Record Plans
2-02-05
Utility Contractor: Hennen Construction
**Note: Rim and invert elevations provided by Otto Associates. All other record plan information provided by the City of Elk River.*

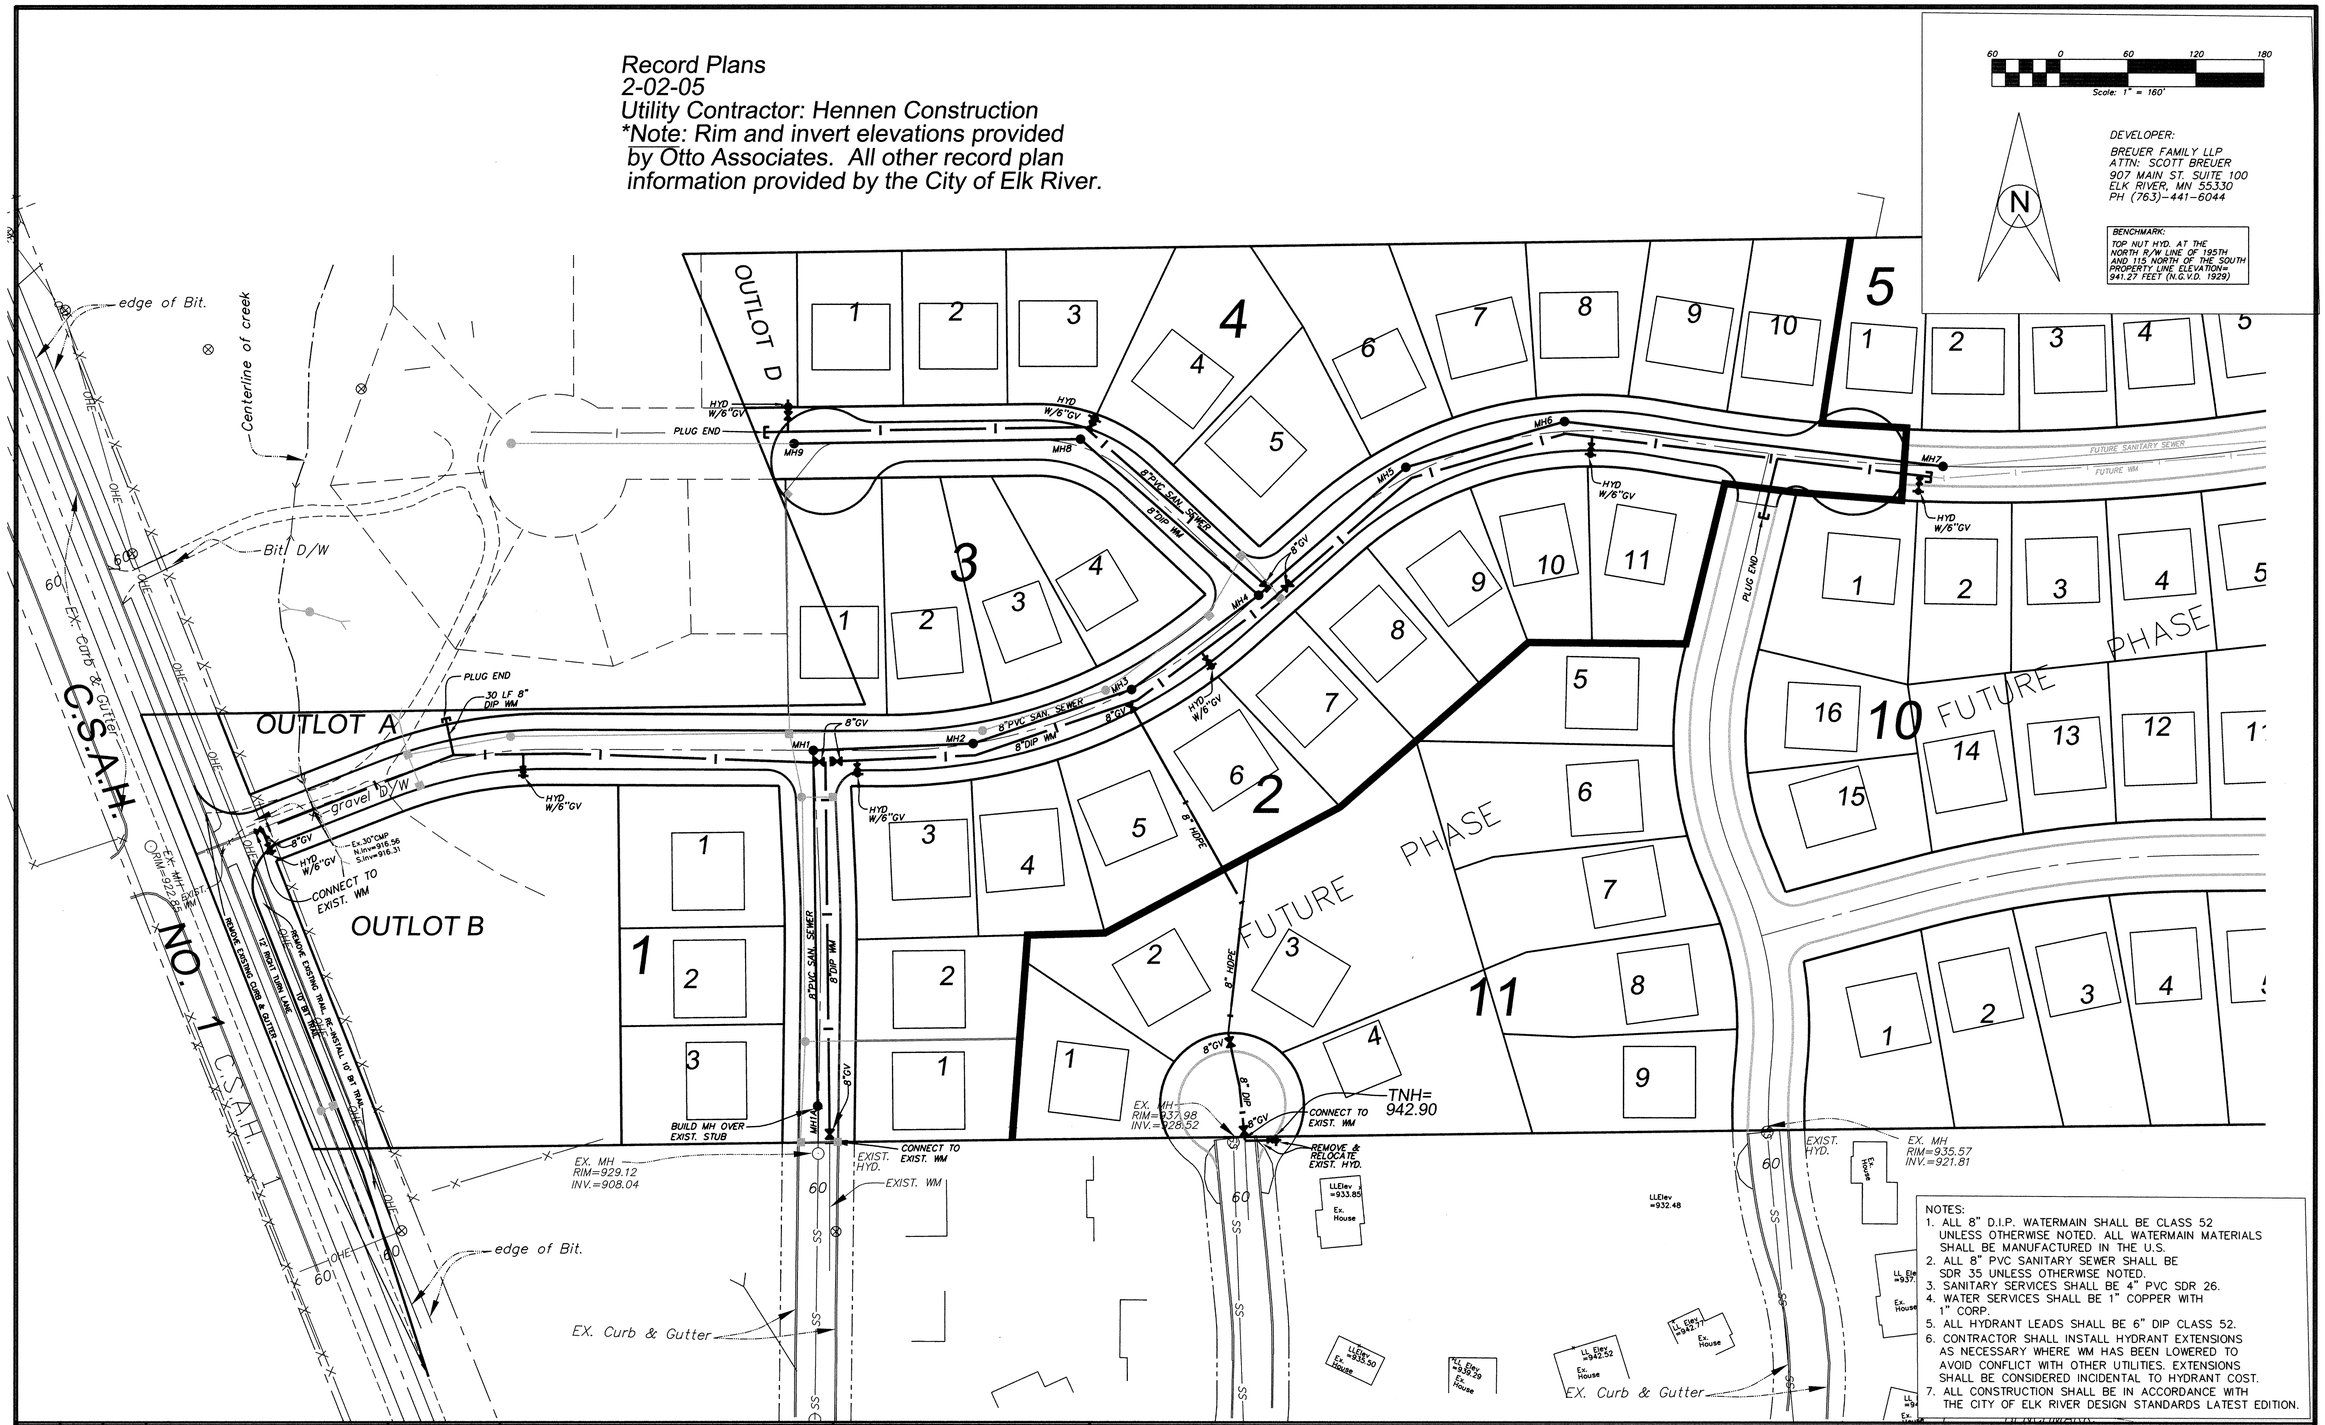

NOTES:
1. ALL 8" D.I.P. WATERMAIN SHALL BE CLASS 52 UNLESS OTHERWISE NOTED. ALL WATERMAIN MATERIALS SHALL BE MANUFACTURED IN THE U.S.
2. ALL 8" PVC SANITARY SEWER SHALL BE SDR 35 UNLESS OTHERWISE NOTED.
3. SANITARY SERVICES SHALL BE 4" PVC SDR 26.
4. WATER SERVICES SHALL BE 1" COPPER WITH 1" CORP.
5. ALL HYDRANT LEADS SHALL BE 6" DIP CLASS 52.
6. CONTRACTOR SHALL INSTALL HYDRANT EXTENSIONS AS NECESSARY WHERE WM HAS BEEN LOWERED TO AVOID CONFLICT WITH OTHER UTILITIES. EXTENSIONS SHALL BE CONSIDERED INCIDENTAL TO HYDRANT COST.
7. ALL CONSTRUCTION SHALL BE IN ACCORDANCE WITH THE CITY OF ELK RIVER DESIGN STANDARDS LATEST EDITION.

NO.	DATE	BY	DESCRIPTION
1	10/29/04	M.L.H.	ADDED MH1A, FOUND STUB FROM EXIST. MH
2	11/9/04	M.L.H.	CONNECTED WM FROM 196TH LANE TO ALBANY CIRCLE

REVISIONS

DESIGNED M.P.C. DRAWN M.L.H.
CHECKED M.P.C.

I HEREBY CERTIFY THAT THIS PLAN, SPECIFICATION, OR REPORT WAS PREPARED BY ME OR UNDER MY DIRECT SUPERVISION AND THAT I AM A DULY LICENSED PROFESSIONAL ENGINEER UNDER THE LAWS OF THE STATE OF MINNESOTA.
Martin P. Campion
DATE: 2/14/05 LICENSE # 19901

OTTO ASSOCIATES
Engineers and Land Surveyors, Inc.
Web Site: www.ottoassociates.com
9 West Division St.
Buffalo, MN 55313
Ph: (763)682-4727
Fax: (763)682-3522

PRESTIGIOUS WOODLAND HILLS
BREUER FAMILY LLP
ELK RIVER, MN

COMPOSITE UTILITY PLAN

SHEET NO. 2 OF 14 SHEETS

PROJECT NO: 2-02-0628
DATE: 9/23/04

DRAWING NUMBER
PW/DHLS.04
2
SAFCO PRODUCTS • NEW HOPE, MINNESOTA
RECORDED BY PART/ NUMBER 63502
POSITION CODE OF PART ON THIS LINE