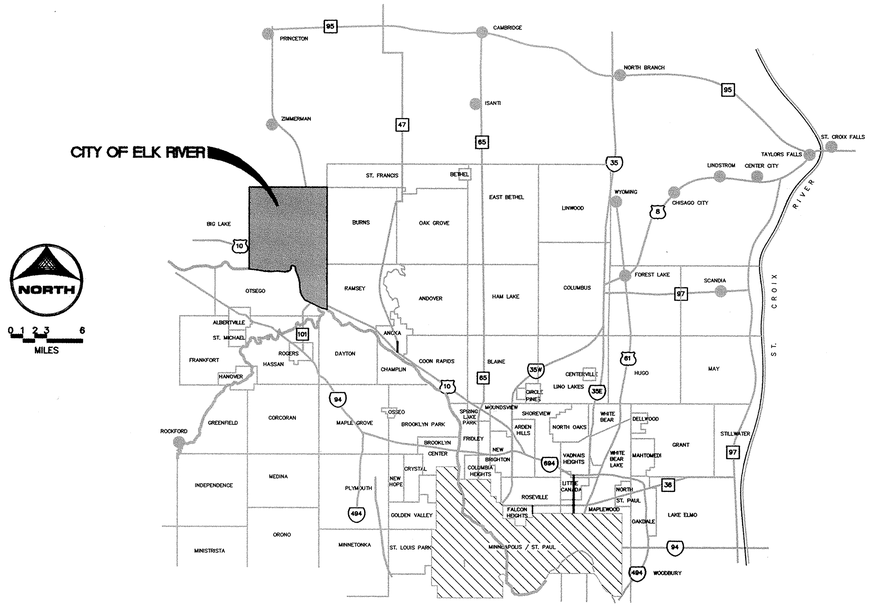

NOTE:
THESE PLANS HAVE BEEN REDUCED TO APPROXIMATELY 1/2 THEIR ORIGINAL SIZE. THESE 1/2 SIZE PLANS ARE TO BE USED FOR BIDDING PURPOSES ONLY.

PARK POINTE

SANITARY SEWER, WATERMAIN, STORM SEWER AND STREET CONSTRUCTION

INDEX

SHEET NO. 1	TITLE SHEET
SHEET NO. 2	LOCATION MAP AND TYPICAL SECTIONS
SHEET NO. 3–4	STORM SEWER SCHEDULE
SHEET NO. 5–22A	PLAN AND PROFILE
SHEET NO. 23–29	STORM SEWER
SHEET NO. L1	LIFT STATION SITE PLAN
SHEET NO. E1–E2	LIFT STATION ELECTRIC PLANS
SHEET NO. D1–D4	DETAILS

THIS PLAN CONTAINS 38 SHEETS

CONSTRUCTION PLAN

I HEREBY CERTIFY THAT THIS PLAN, SPECIFICATION, OR REPORT WAS PREPARED BY ME OR UNDER MY DIRECT SUPERVISION AND THAT I AM A DULY LICENSED PROFESSIONAL ENGINEER UNDER THE LAWS OF THE STATE OF MINNESOTA.

TERRY J. MAURER

DATE _____ LIC.NO. 15316

1326 ENERGY PARK DRIVE
ST. PAUL, MINNESOTA 55108
(651) 644-4389

Howard R. Green Company
CONSULTING ENGINEERS

PREPARED FOR:

DYNAMIC'S DESIGN AND LAND CO.

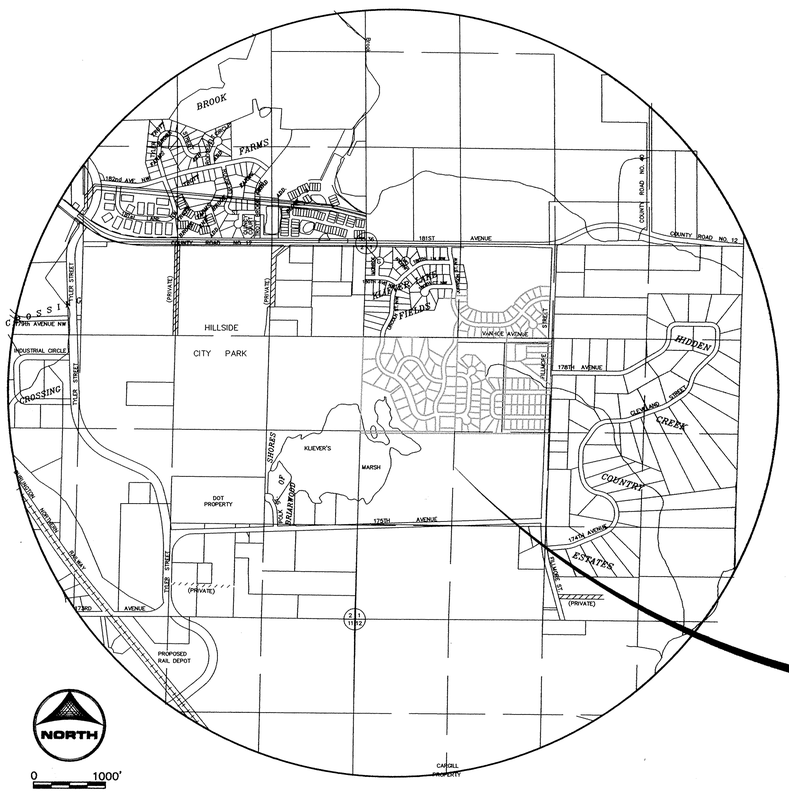

PROJECT LOCATION

LOCATION MAP

RECORD PLAN
DECEMBER 2002

January 08, 2003 8:30:42 a.m.
815361J\dwg\815361-TITLE.DWG (JLALLEN)

MAY 2002

SHEET 1 OF 38

DRAWING NUMBER
SAFCO PRODUCTS • NEW HOPE, MINNESOTA
REORDER BY PART NUMBER 65052
POSITION SIDE OF PART ON THIS LINE

DRAWING NUMBER
SAFCO PRODUCTS • NEW HOPE, MINNESOTA
REORDER BY PART NUMBER 65052
POSITION SIDE OF PART ON THIS LINE

DRAWING NUMBER
SAFCO PRODUCTS • NEW HOPE, MINNESOTA
REORDER BY PART NUMBER 65052
POSITION SIDE OF PART ON THIS LINE

DRAWING NUMBER
PARK.P.02
1
SAFCO PRODUCTS • NEW HOPE, MINNESOTA
REORDER BY PART NUMBER 65052
POSITION SIDE OF PART ON THIS LINE