
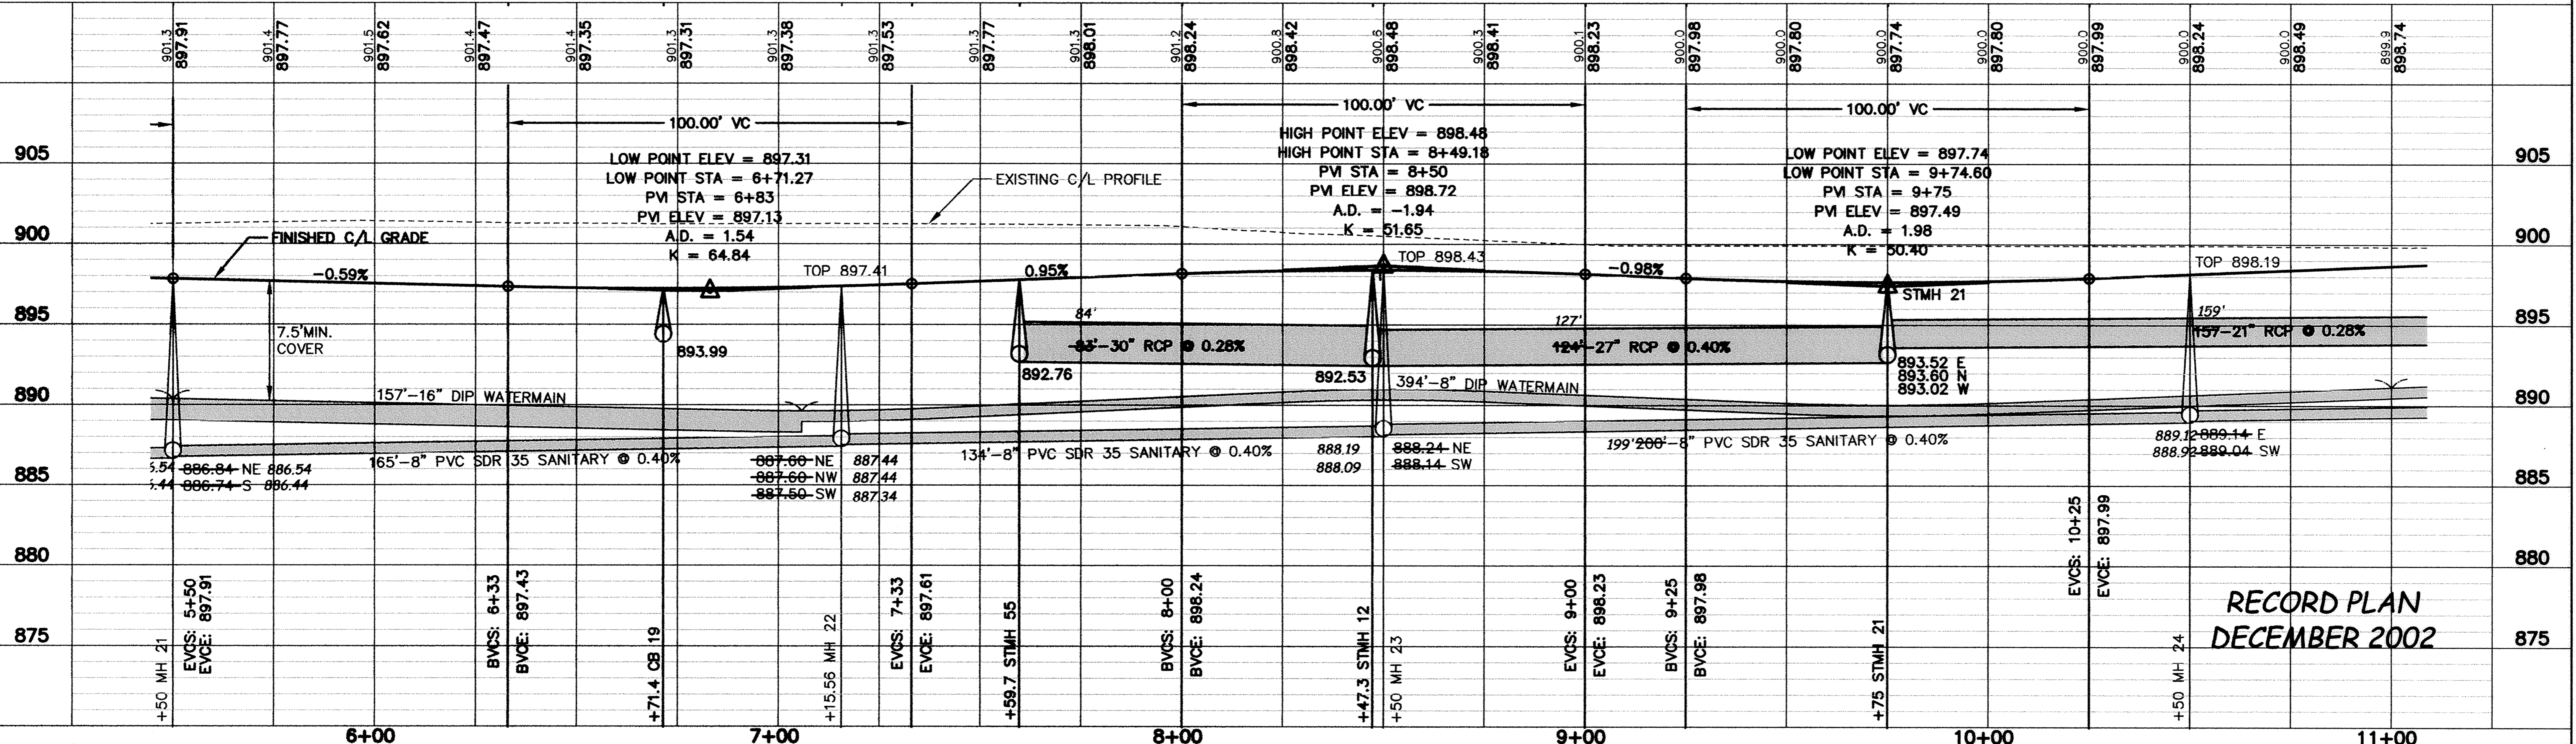


# IVANHOE STREET

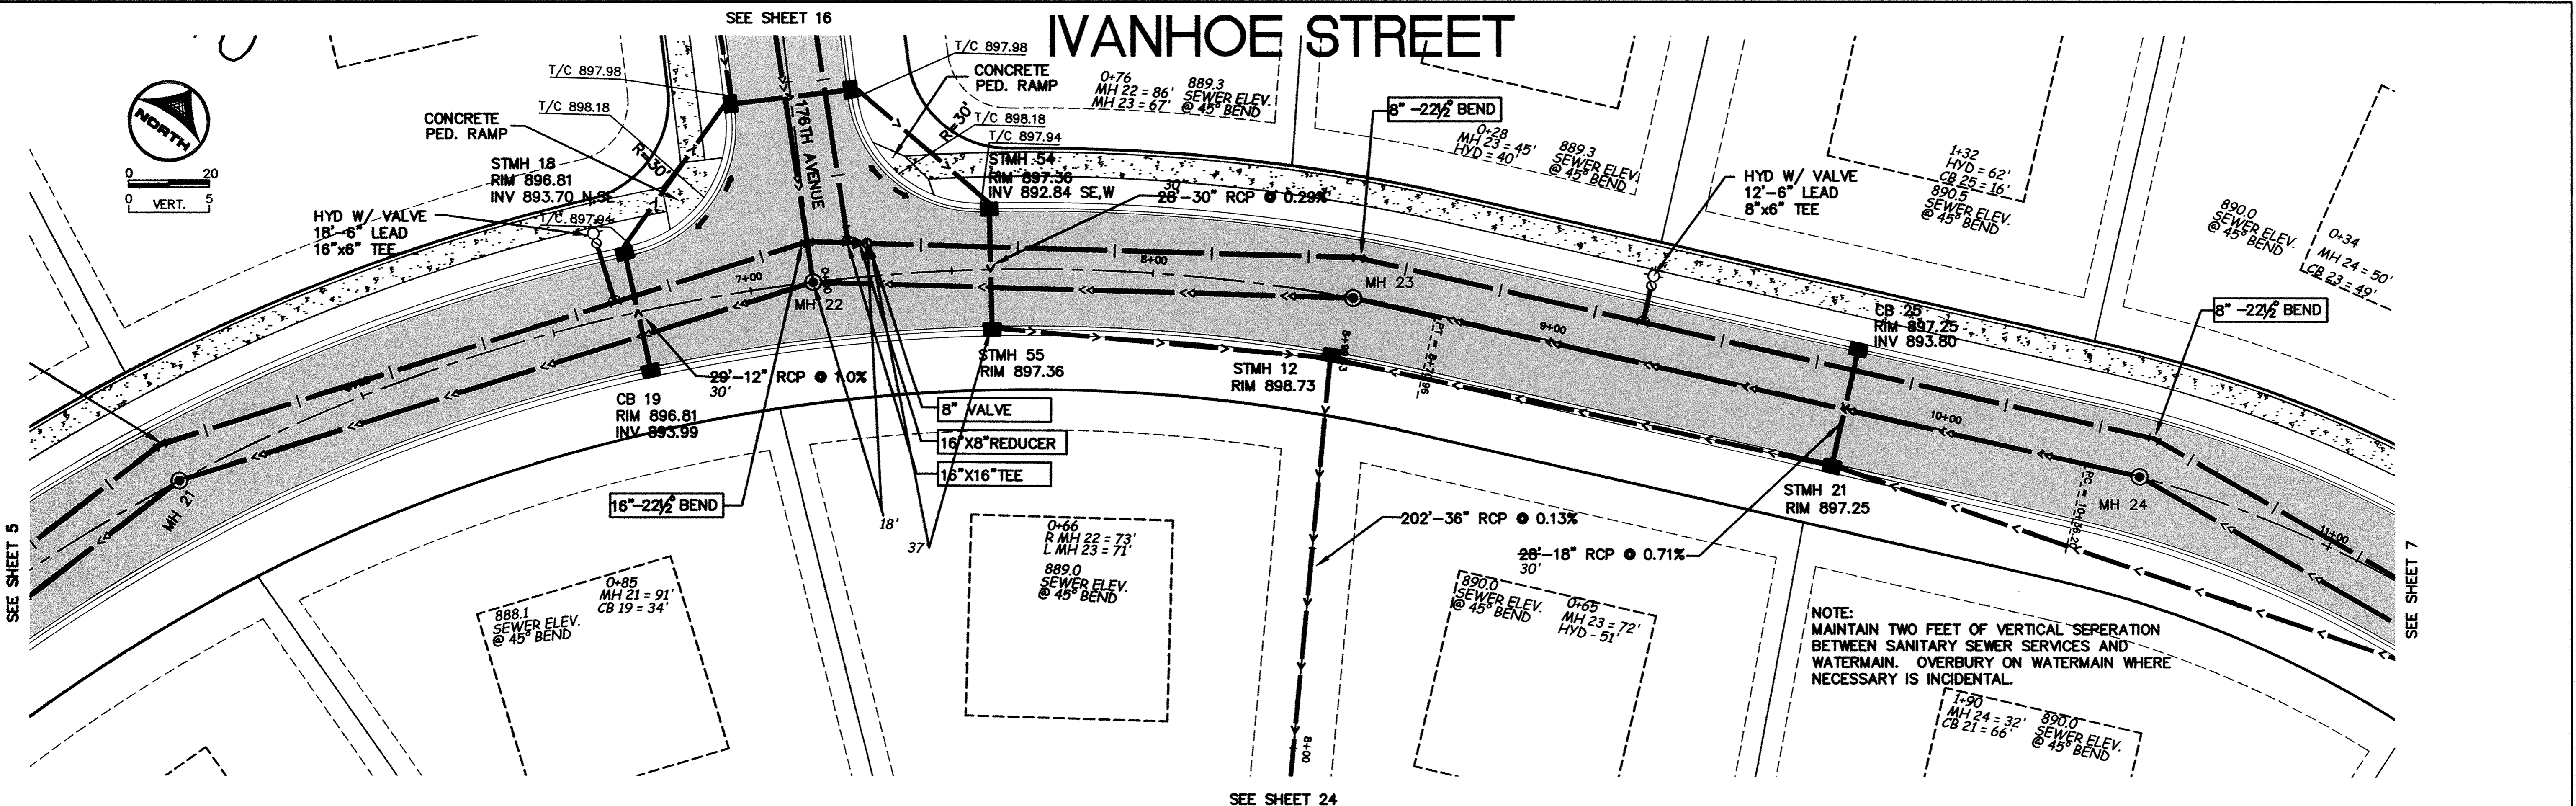

DESIGNED BY: KT/EY DRAWN BY: EY/JM  
 APPROVED BY: APPROVED BY JOB NUMBER 815361J  
 CAD DATE: January 08, 2003 8:39:11 a.m.  
 CAD FILE: 815361J\dwg\IVANHOE.DWG (JLALLEN)

I HEREBY CERTIFY THAT THIS PLAN, SPECIFICATION, OR REPORT WAS PREPARED BY ME OR UNDER MY DIRECT SUPERVISION AND THAT I AM A DULY LICENSED PROFESSIONAL ENGINEER UNDER THE LAWS OF THE STATE OF MINNESOTA.

SIGNATURE: \_\_\_\_\_ DATE: \_\_\_\_\_  
 PRINTED NAME: TERRY J. MAURER LIC. NO. 15316

NO.	DATE	BY	REVISION DESCRIPTION

1326 ENERGY PARK DRIVE  
 ST. PAUL, MINNESOTA 55108  
 (651) 644-4389

**Howard R. Green Company**  
 CONSULTING ENGINEERS

PARK POINT  
 CITY OF ELK RIVER

IVANHOE STREET  
 STREET AND UTILITY IMPROVEMENTS  
 5+50 TO 11+00

SHEET NO.  
**6**

SAICO PRODUCTS • NEW HOPKINS, MINNESOTA  
 REVISIONS BY PART NUMBER 8882