IVANHOE STREET

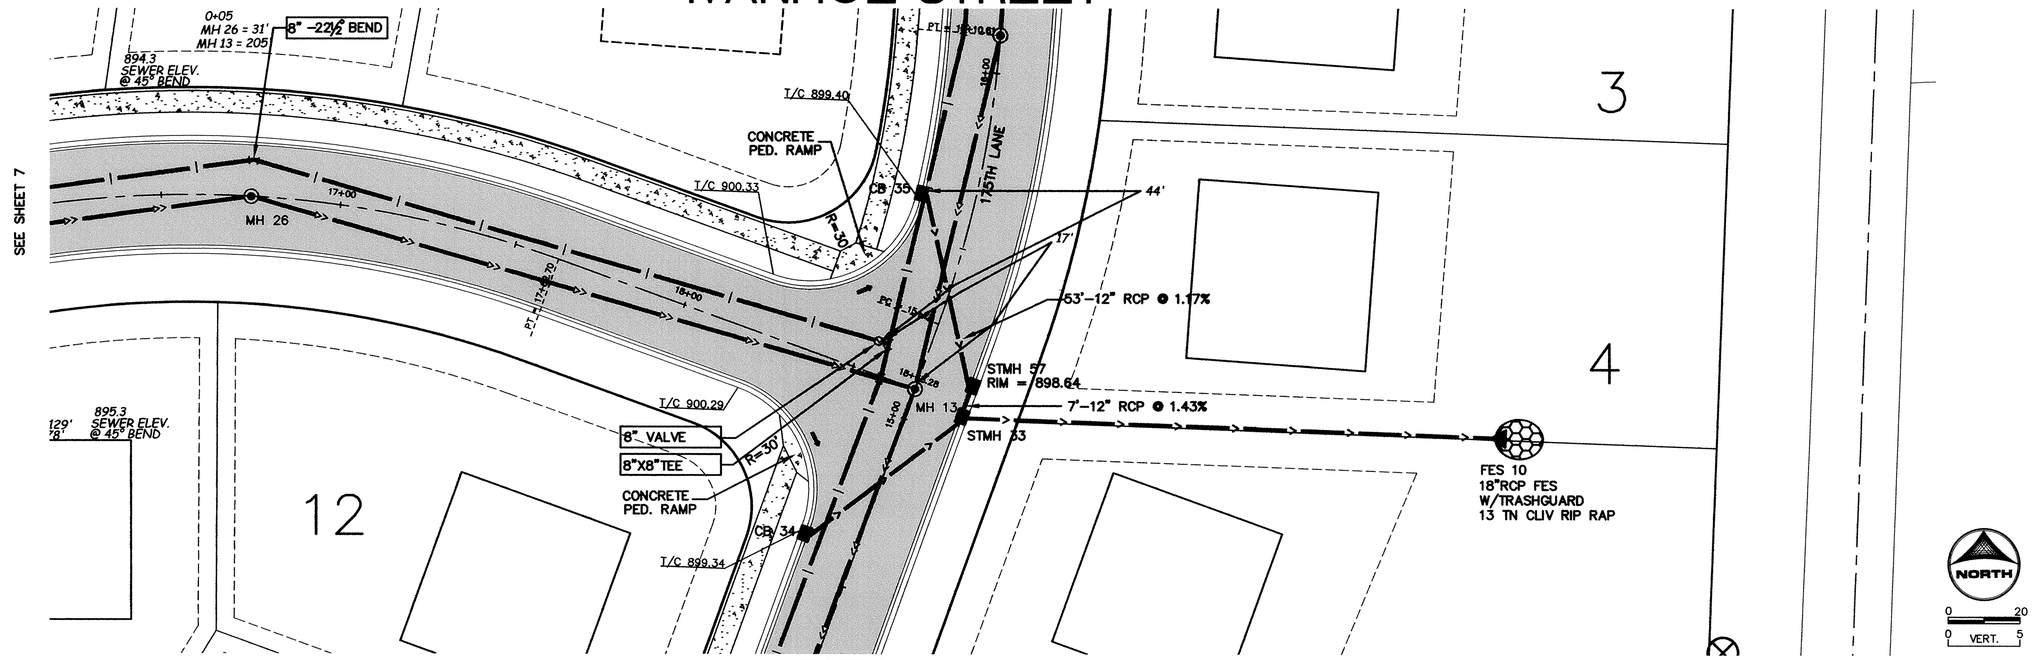

SEE SHEET 13

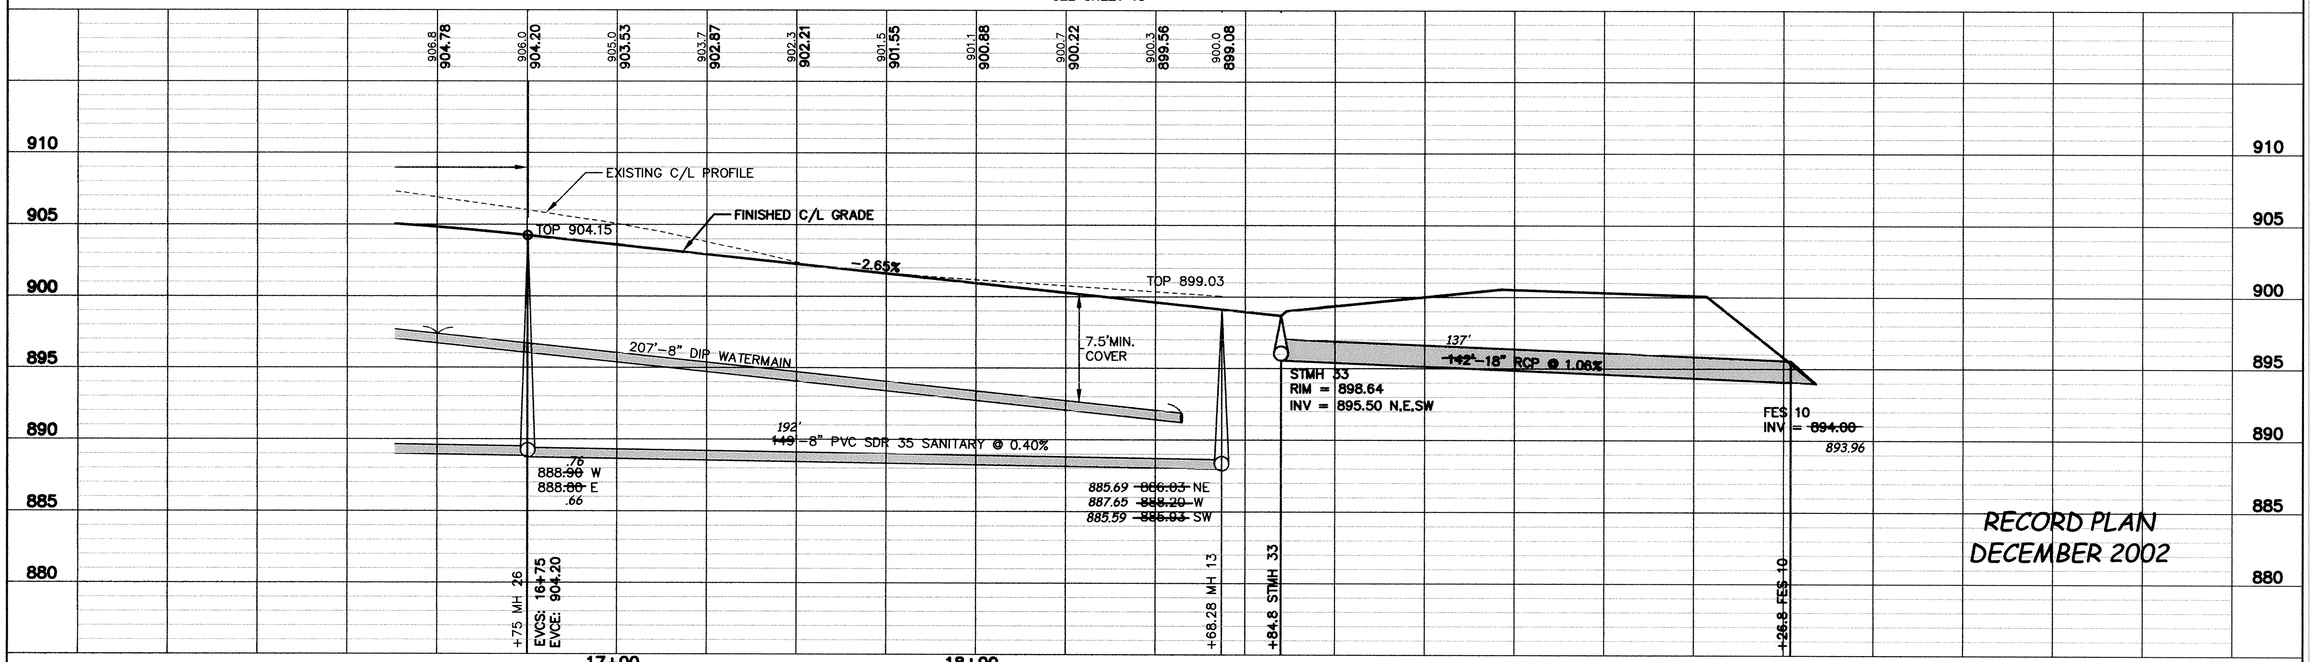

RECORD PLAN
DECEMBER 2002

Xrefs: XCS-BASE.DWG

DESIGNED BY: KT/EY DRAWN BY: EY/JM
APPROVED BY: APPROVED BY JOB NUMBER 815361J
CAD DATE: January 08, 2003 8:39:11 a.m.
CAD FILE: 815361J\dwg\IVANHOE.DWG (JLALLEN)

I HEREBY CERTIFY THAT THIS PLAN, SPECIFICATION, OR REPORT WAS PREPARED BY ME OR UNDER MY DIRECT SUPERVISION AND THAT I AM A DULY LICENSED PROFESSIONAL ENGINEER UNDER THE LAWS OF THE STATE OF MINNESOTA.

SIGNATURE _____ DATE _____
PRINTED NAME TERRY J. MAURER LIC.NO. 15316

NO.	DATE	BY	REVISION DESCRIPTION

1326 ENERGY PARK DRIVE
ST. PAUL, MINNESOTA 55108
(651) 644-4389
Howard R. Green Company
CONSULTING ENGINEERS

PARK POINTE
CITY OF ELK RIVER

IVANHOE STREET
STREET AND UTILITY IMPROVEMENTS 16+50 TO 19+00

SHEET NO.
8

DRAWING NUMBER
PARK.P 02
8

SAFCO PRODUCTS • NEW HOPE, MINNESOTA
REORDER BY PART NUMBER 6532
POSITION EDGE OF PRINT ON THIS LINE