GRANT COURT

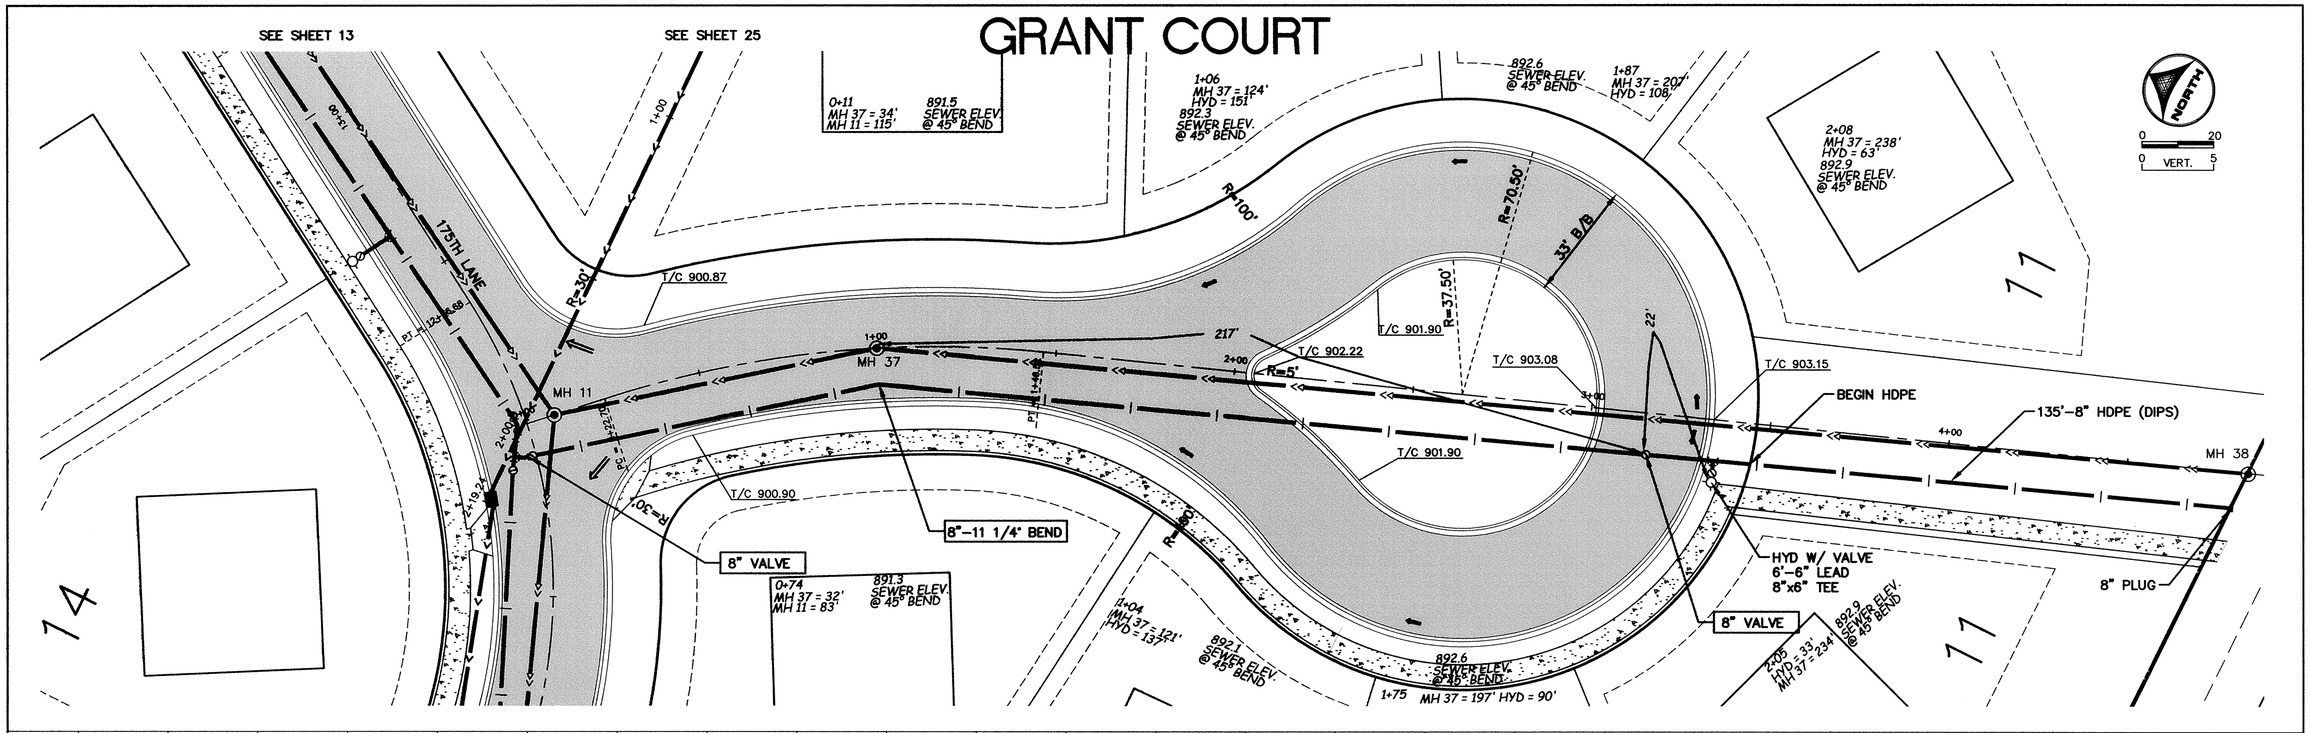

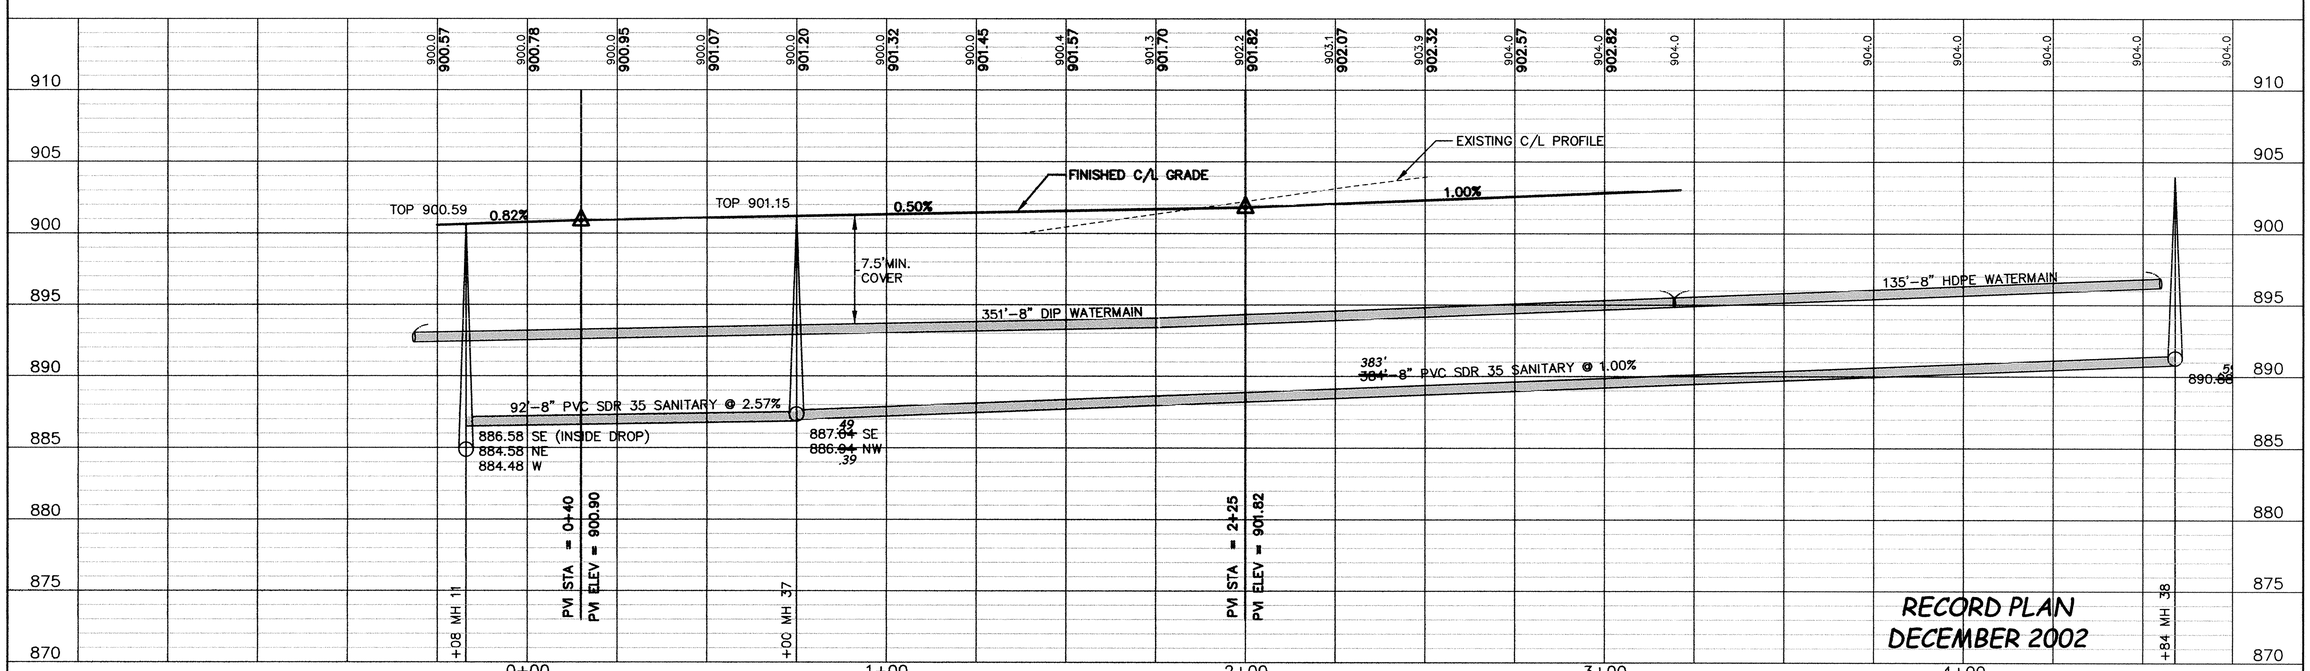

Xrefs: XCS-BASE.DWG

DESIGNED BY: KT/EY DRAWN BY: EY/JM
APPROVED BY: APPROVED BY JOB NUMBER 815361J
CAD DATE: April 04, 2003 8:27:31 a.m.
CAD FILE: 815361J\dwg\GRANT COURT.DWG (JLALLEN)

I HEREBY CERTIFY THAT THIS PLAN, SPECIFICATION, OR REPORT WAS PREPARED BY ME OR UNDER MY DIRECT SUPERVISION AND THAT I AM A DULY LICENSED PROFESSIONAL ENGINEER UNDER THE LAWS OF THE STATE OF MINNESOTA.

SIGNATURE _____ DATE _____

PRINTED NAME TERRY J. MAURER LIC.NO. 15316

NO.	DATE	BY	REVISION DESCRIPTION

Howard R. Green Company
CONSULTING ENGINEERS
1326 ENERGY PARK DRIVE
ST. PAUL, MINNESOTA 55108
(651) 644-4389

PARK POINTE
CITY OF ELK RIVER

GRANT COURT
STREET AND UTILITY IMPROVEMENTS 0+00 TO 4+84

SHEET NO. 15

DRAWING NUMBER
SAFCO PRODUCTS • NEW HOPE, MINNESOTA
REORDER BY PART NUMBER 65302

DRAWING NUMBER
SAFCO PRODUCTS • NEW HOPE, MINNESOTA
REORDER BY PART NUMBER 65302

DRAWING NUMBER
SAFCO PRODUCTS • NEW HOPE, MINNESOTA
REORDER BY PART NUMBER 65302

DRAWING NUMBER
PARKP.02
16
SAFCO PRODUCTS • NEW HOPE, MINNESOTA
REORDER BY PART NUMBER 65302