176TH COURT

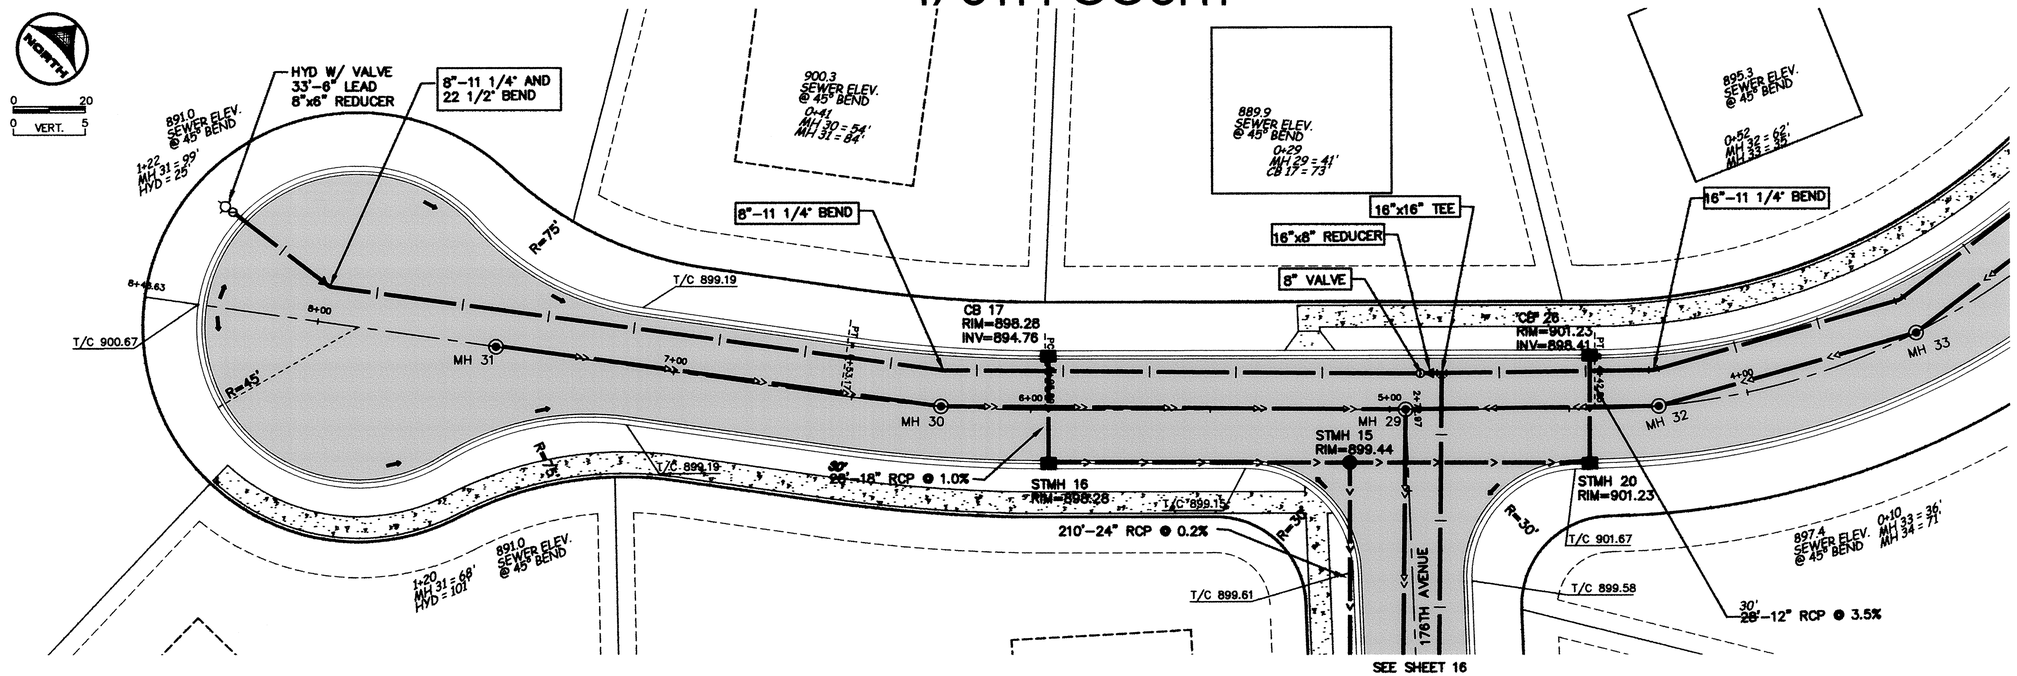

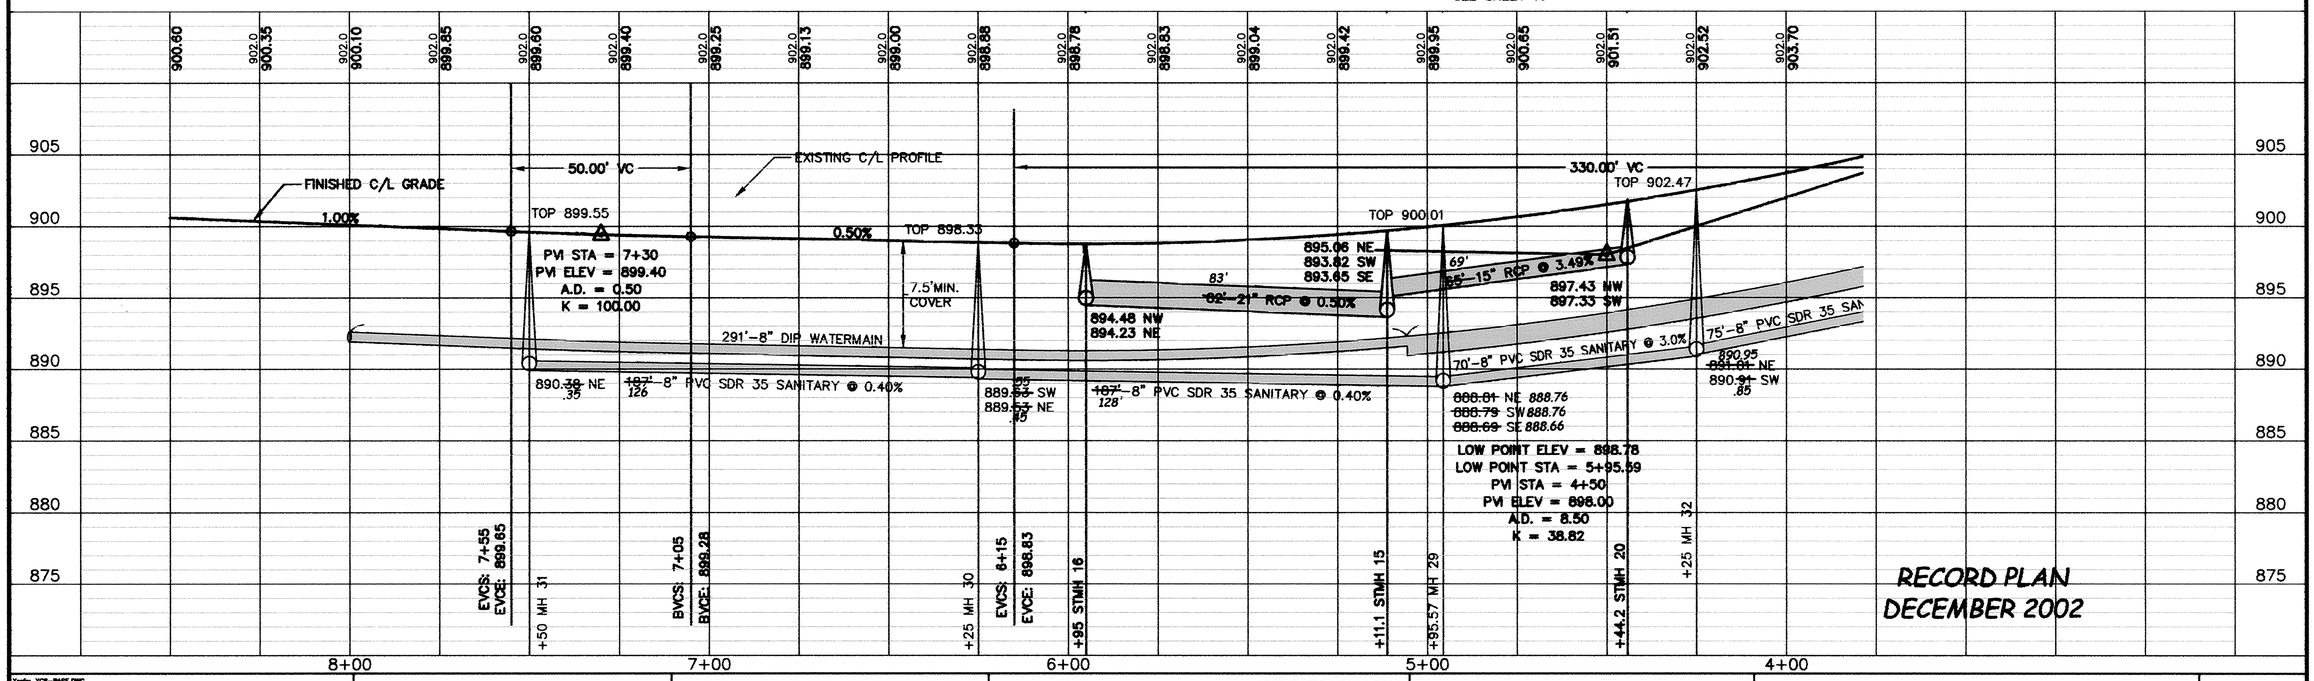

RECORD PLAN
DECEMBER 2002

DESIGNED BY: KT/EY	DRAWN BY: EY/JM	I HEREBY CERTIFY THAT THIS PLAN, SPECIFICATION, OR REPORT WAS PREPARED BY ME OR UNDER MY DIRECT SUPERVISION AND THAT I AM A DULY LICENSED PROFESSIONAL ENGINEER UNDER THE LAWS OF THE STATE OF MINNESOTA.	1326 ENERGY PARK DRIVE ST. PAUL, MINNESOTA 55108 (651) 644-4389
APPROVED BY: APPROVED BY	JOB NUMBER 815361J	SIGNATURE _____ DATE _____	Howard R. Green Company CONSULTING ENGINEERS
CAD DATE: April 04, 2003 8:10:23 a.m.		PRINTED NAME TERRY J. MAURER LIC.NO. 15316	
CAD FILE: 815361J\dwg\176TH COURT.DWG (JLALLEN)			

NO.	DATE	BY	REVISION DESCRIPTION

PARK POINTE
CITY OF ELK RIVER

176TH COURT
STREET AND UTILITY IMPROVEMENTS 4+00 TO 8+48.63

SHEET NO. 18

DRAWING NUMBER

DRAWING NUMBER
PARKP 02
19