**NOTES:** Sanitary Sewer Manhole Castings shall be Neenah Foundry R-1733 with solid lid and 2 concealed lift holes. "SANITARY SEWER" shall be stamped on the cover.

All hydrants to be Waterous hydrants.

NOTES:

1. All stations for services as shown on plans are to sanitary sewer service wyes.
2. All sanitary sewer services are to be 4" PVC All water services are to be 1" (Type K) Cu tubing.

**Fed. Proj. No.**

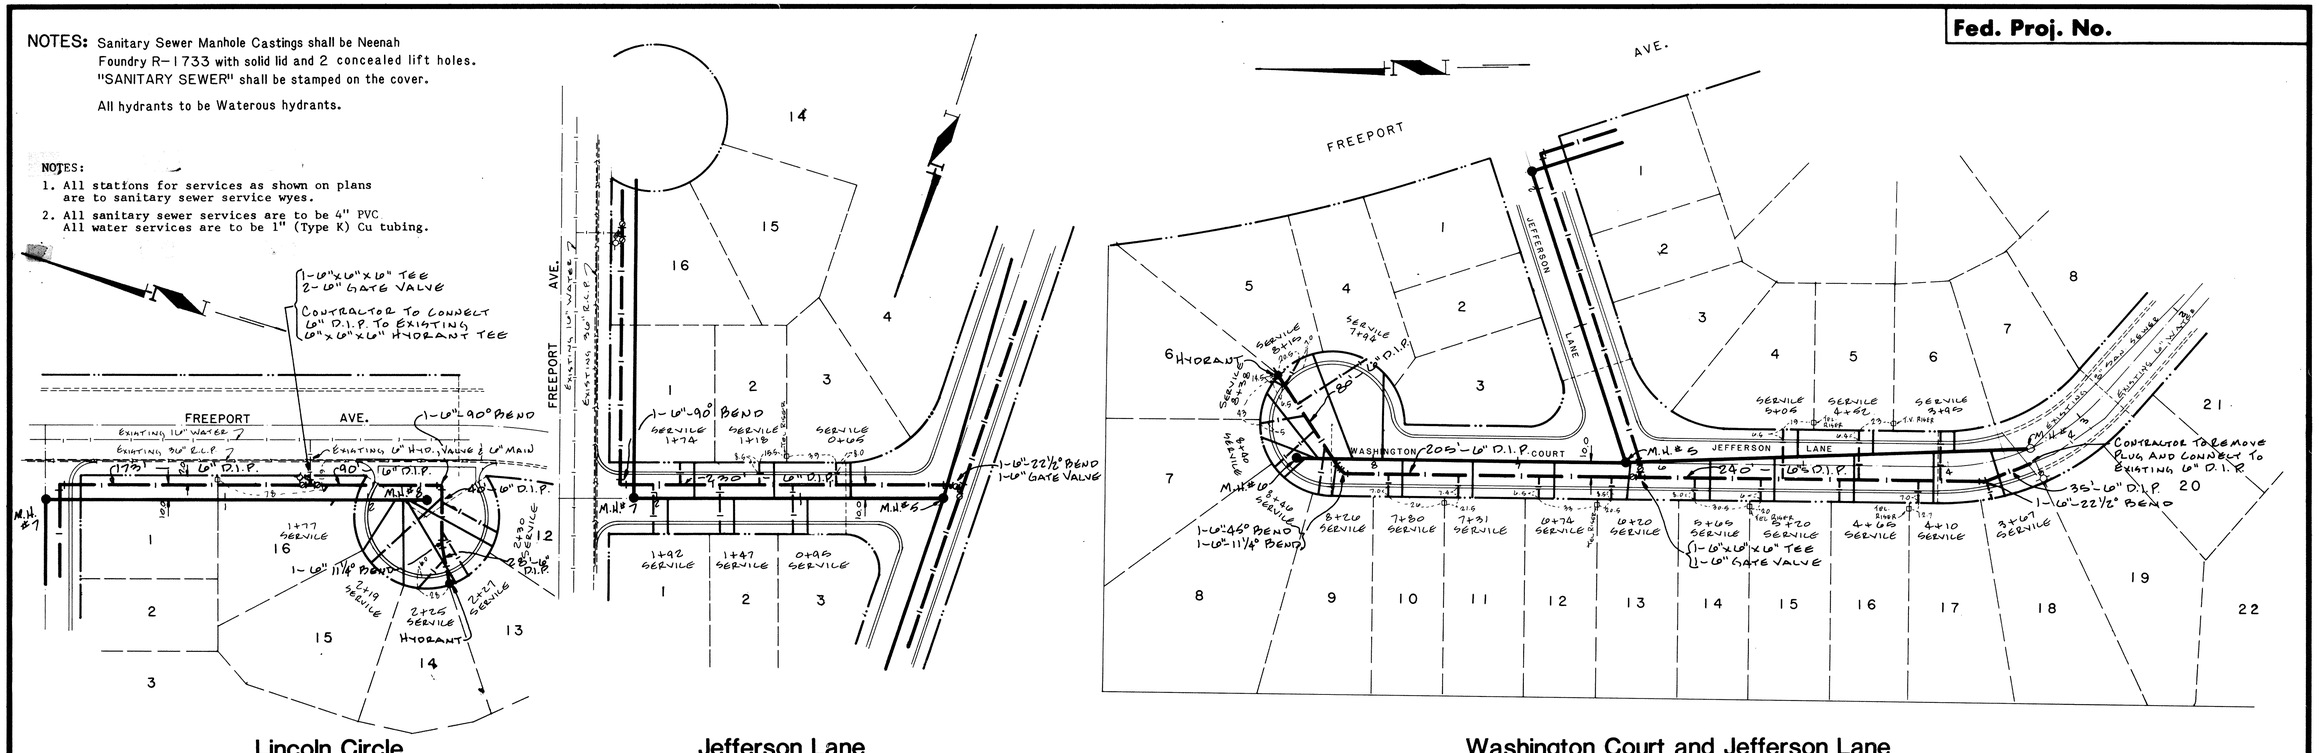


I hereby certify that this plan, specification, or report was prepared by me or under my direct supervision and that I am a duly Registered Professional Engineer under the laws of the State of Minnesota.

Date 8/29/86 Reg. No. 6218

MEYER-ROHLIN, INC.
ENGINEERS-LAND SURVEYORS
1111 Hwy. 25 N., Buffalo, Minn. 55313

| DESIGNED BY | DRAWN BY | CHECKED BY |
|---|---|---|
| | Z.K.N. | T.P.M. |

RECORD DRAWINGS

**State Proj. No.**

**Sheets**

ATES

RMAIN

FILE NO. D-85115A

138

DRAWING NUMBER



DRAWING NUMBER PRESI.86 1

Copyright 1986 Construction Data Systems, Inc.

Cary Equipment Form #2