
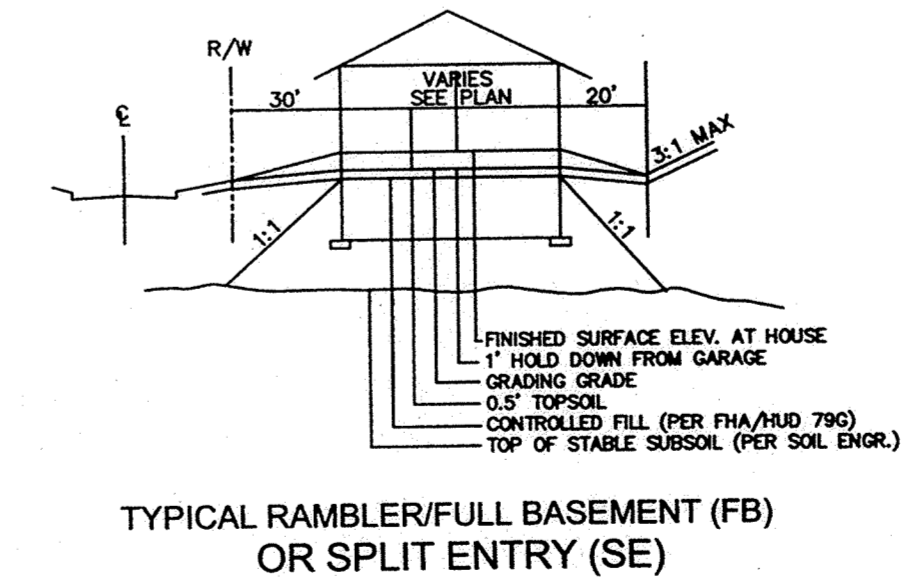
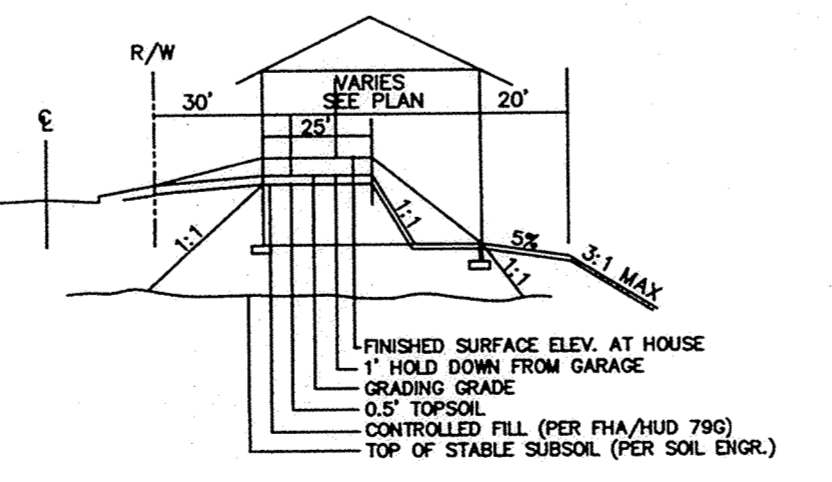
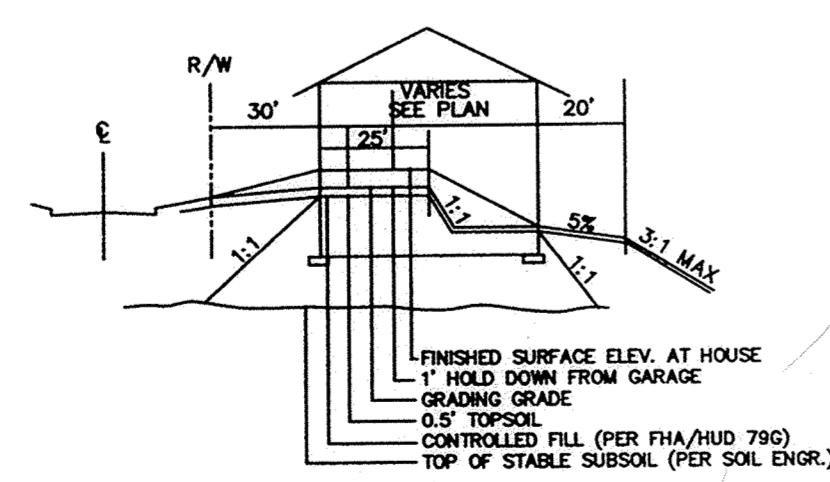
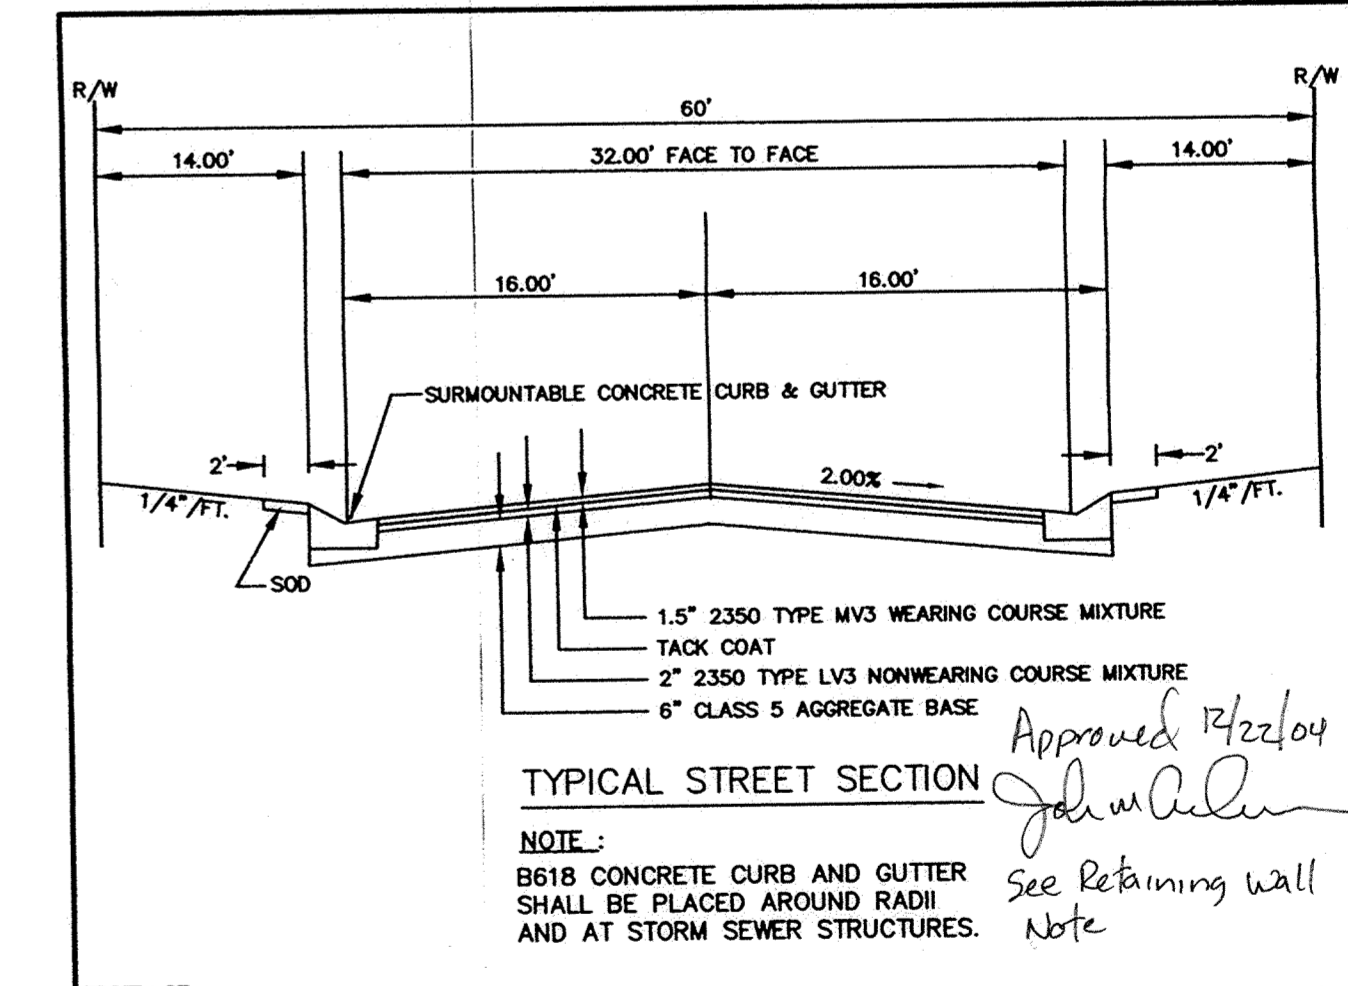


BENCHMARK:
TOP HUT HVD. AT THE
NORTH R/W LINE OF 195TH
AND 115 NORTH OF THE SOUTH
PROPERTY LINE. ELEVATION:
941.27 FEET (N.G.V.D. 1929)

DEVELOPER:
BREUER FAMILY LLP
ATTN: SCOTT BREUER
907 MAIN ST. SUITE 100
ELK RIVER, MN 55330
PH (763)-441-6044

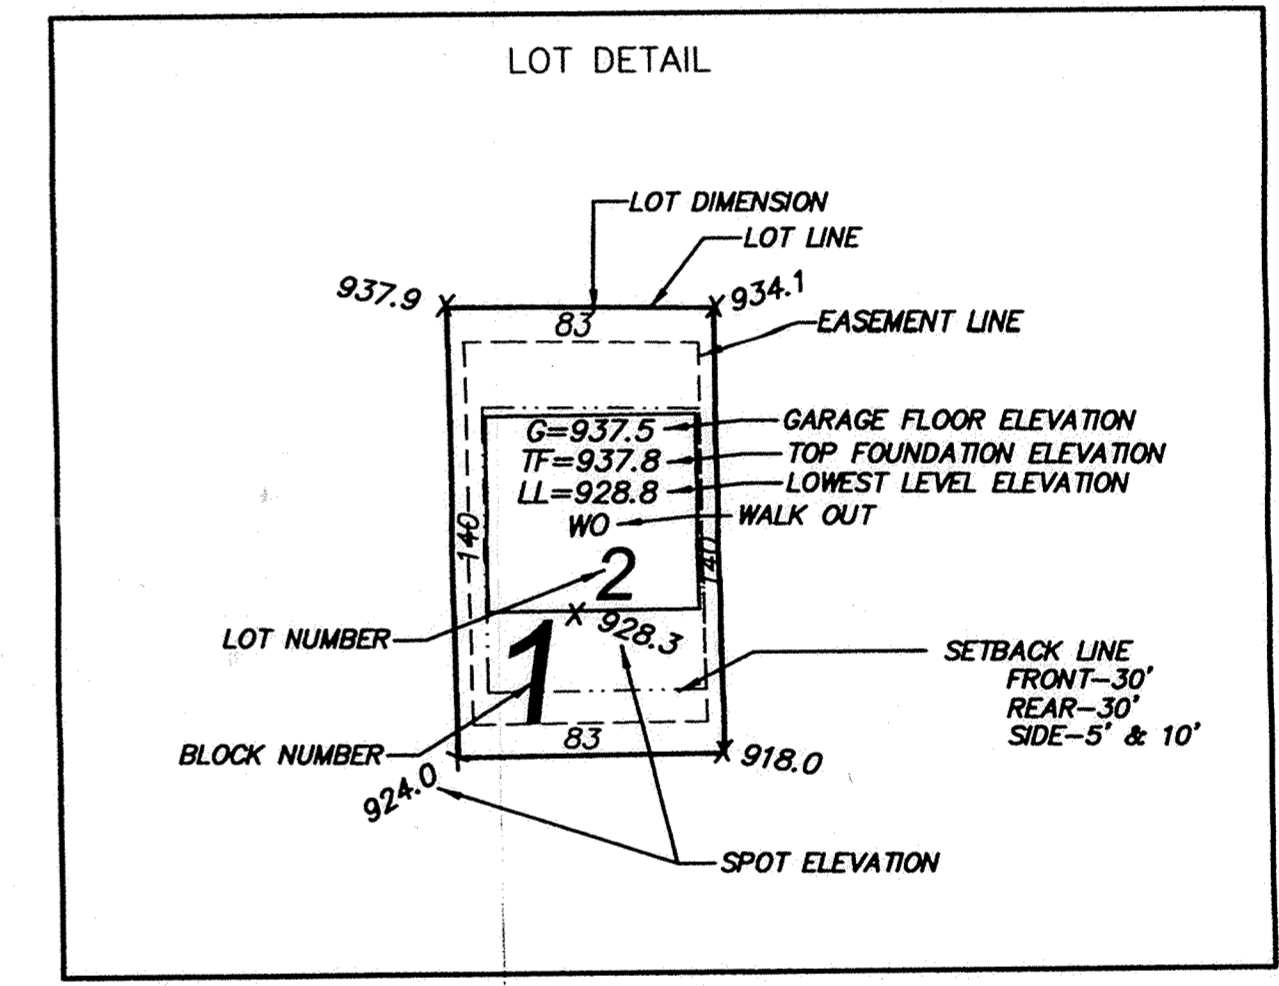

ERSTD-ST

 TYPICAL STREET SECTION

 STANDARD PLATE NO. 2010

NO.	DATE	BY	DESCRIPTION
1	12/9/04	M.L.H.	REVISED PER REVIEW LETTER

DESIGNED DRAWN
M.P.C. M.L.H.
CHECKED
M.P.C.
I HEREBY CERTIFY THAT THIS PLAN, SPECIFICATION, OR REPORT WAS PREPARED BY ME OR UNDER MY DIRECT SUPERVISION AND THAT I AM A DULY LICENSED PROFESSIONAL ENGINEER UNDER THE LAWS OF THE STATE OF MINNESOTA.
Martin P. Coffey
DATE: 12/20/04 LICENSE # 39091

Web Site:
www.ottosassociates.com

 9 West Division St.
Buffalo, MN 55313
Ph: (763)882-4727
Fax: (763)882-3522
Engineers and Land Surveyors, Inc.

PRESTIGIOUS WOODLAND HILLS
BREUER FAMILY LLP
ELK RIVER, MN

DEVELOPMENT PLAN
PROJECT NO: 2-02-0628
SHEET NO. 1 OF 1 SHEETS
DATE: 10/20/04