PLAN HOLD CORPORATION • IRVINE, CALIFORNIA
REORDER BY NUMBER 075AR
POSITION EDGE OF PRINT ON THIS LINE

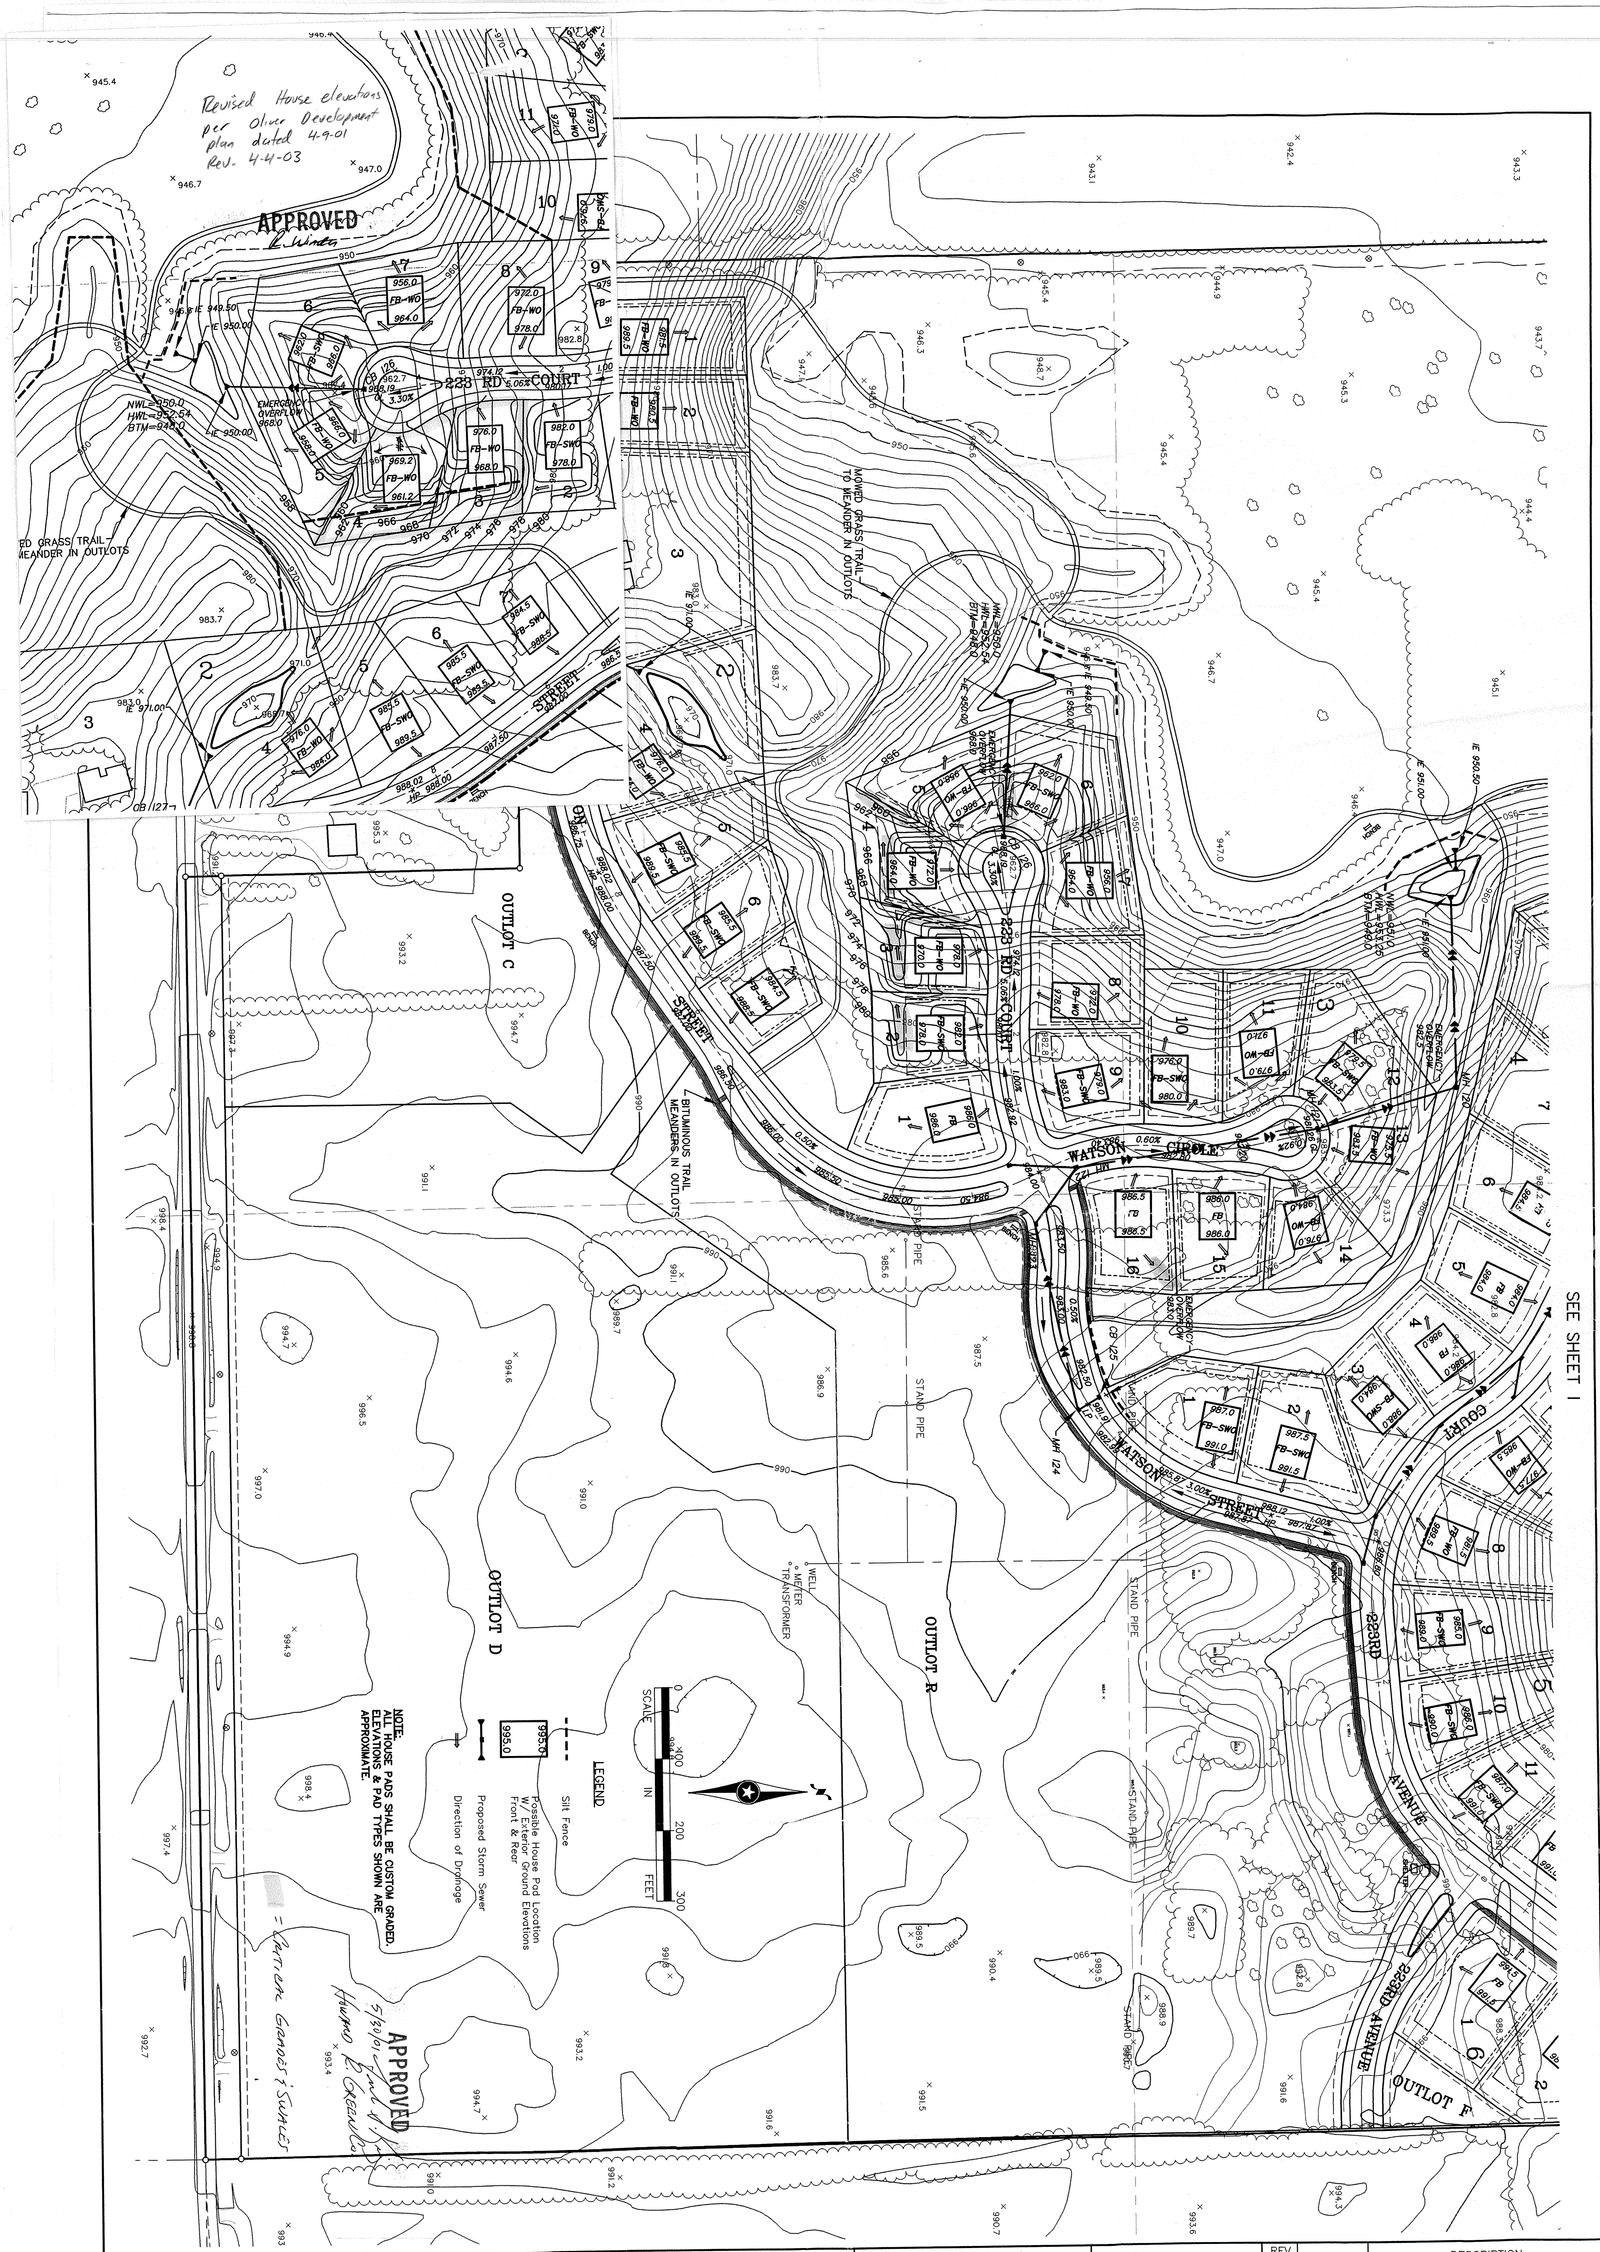

SHEET NO. 2 OF 2

RIDGES OF RICE LAKE
ELK RIVER, MN

Dynamics Design & Land Co.
DEVELOPMENT PLAN

John Oliver & Associates, Inc.
Civil Engineering, Land Surveying, Land Planning
580 Dodge Avenue
Elk River, Minnesota 55330
(612)441-2072 (FAX)441-5665
201 W. Travelers Trail, Suite 200
Burnsville, Minnesota 55337
(612)894-3045 (FAX)894-3049

I hereby certify that this plan, specification, or report was prepared by me or under my direct supervision and that I am a Licensed Professional Engineer under the laws of the State of Minnesota.

Signed: William J. Mornen
Date: 4/9/01 Reg. No. 26777

DATE:	4/9/01
DESIGN BY:	JBK
DRAWN BY:	TGL
CHECKED BY:	WJM, JBK
DWG:	7918DEV2.DWG
TEXT:	NONE
FILE NO.:	7918.10-03

REV NO.	DATE	DESCRIPTION