223RD COURT

WATSON STREET

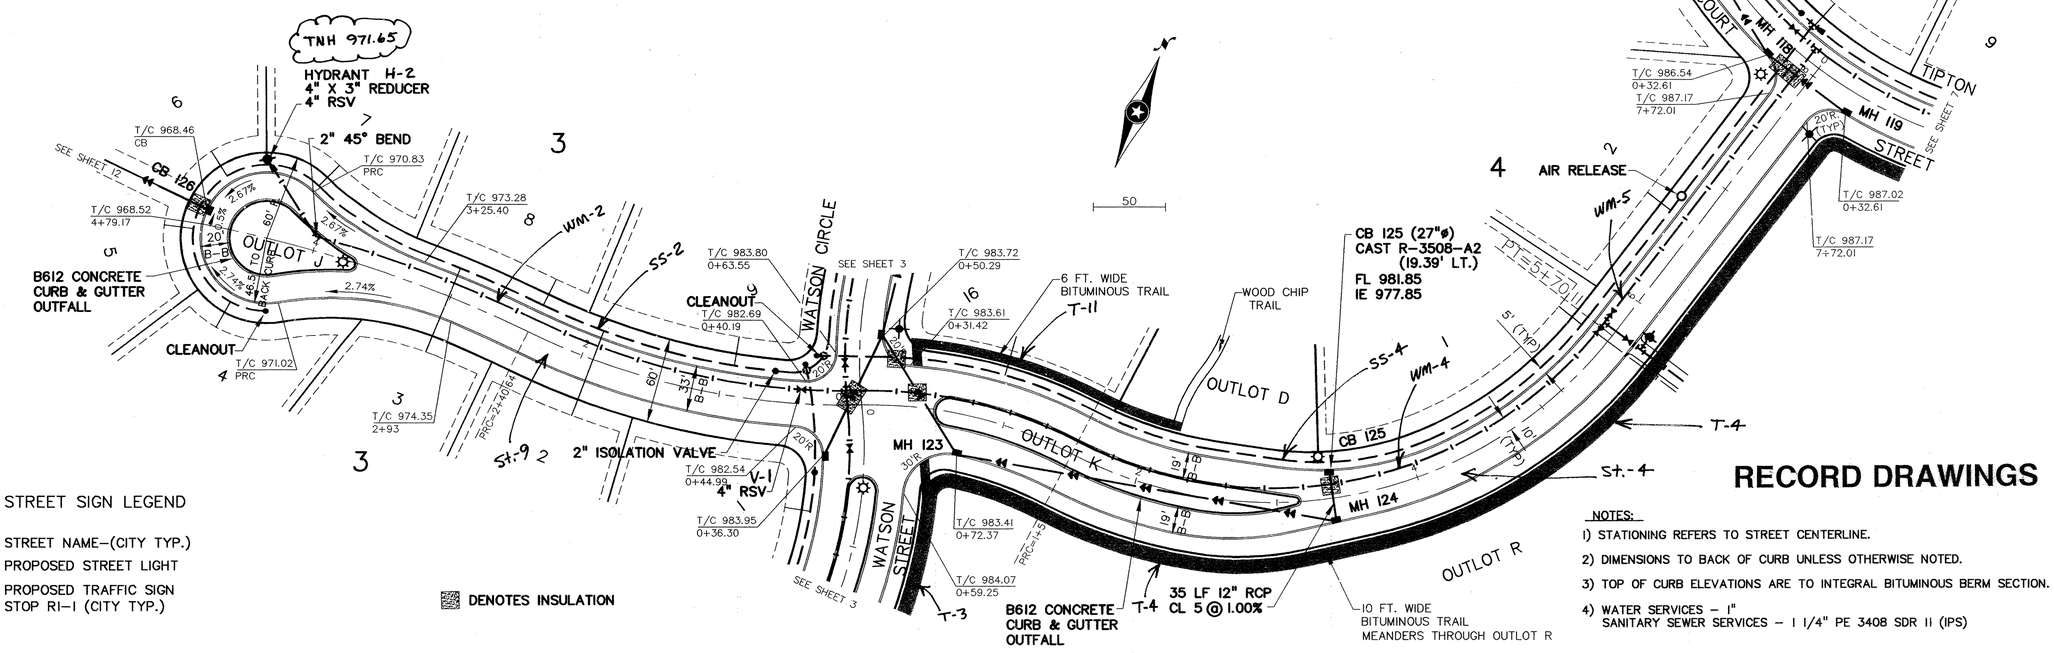

STREET SIGN LEGEND

- STREET NAME–(CITY TYP.)
- PROPOSED STREET LIGHT
- PROPOSED TRAFFIC SIGN STOP RI–I (CITY TYP.)

RECORD DRAWINGS

NOTES:

1) STATIONING REFERS TO STREET CENTERLINE.
2) DIMENSIONS TO BACK OF CURB UNLESS OTHERWISE NOTED.
3) TOP OF CURB ELEVATIONS ARE TO INTEGRAL BITUMINOUS BERM SECTION.
4) WATER SERVICES – 1" SANITARY SEWER SERVICES – 1 1/4" PE 3408 SDR 11 (IPS)

REV NO.	DATE	DESCRIPTION
1	5/1/01	ADDED CB
2	5/9/01	CITY COMMENTS
3	11/8/05	RECORD DRAWINGS

DATE: 4/9/01
DESIGN BY: JK/BM
DRAWN BY: BJC
CHECKED BY: JK/BM
DWG FILE: 6–223RD
TEXT FILE: NONE
FILE NO.: 7918.10–03

I hereby certify that this plan, specification, or report was prepared by me or under my direct supervision and that I am a duly Licensed Professional Engineer under the laws of the state of Minnesota.

Signature: Jville S Mlaman
Date: 4/9/01 Reg. No. 26777

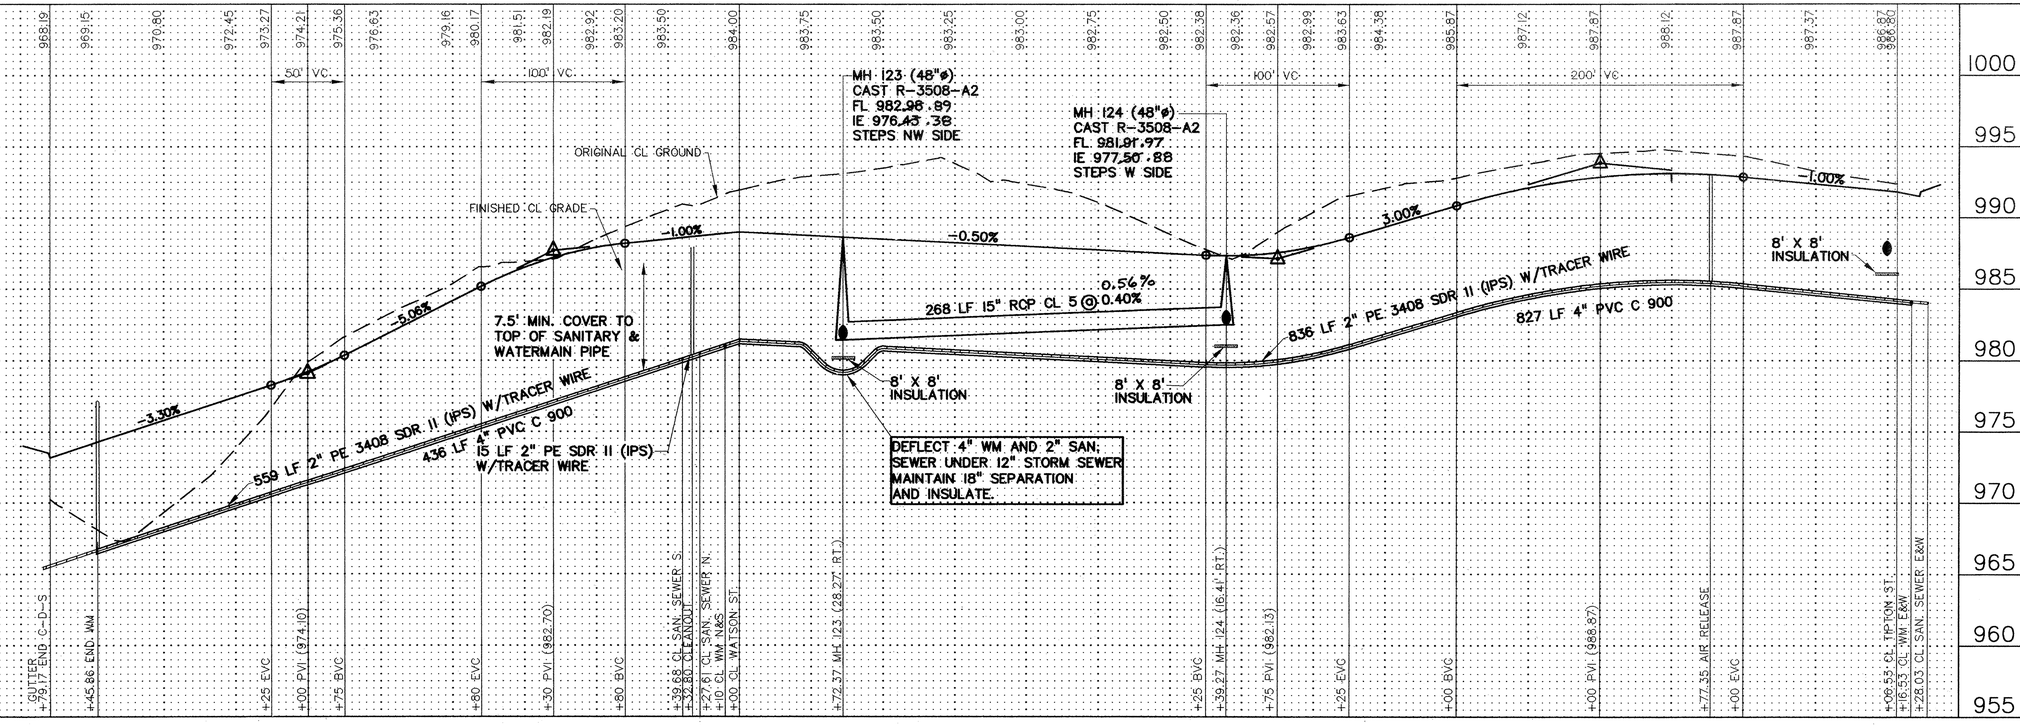

John Oliver & Associates, Inc.
Civil Engineering, Land Surveying, Land Planning
580 Dodge Avenue
Elk River, Minnesota 55330
763-441-2072 FAX 763-441-5665
Offices in: Elk River, Burnsville and Brooklyn Park, Minnesota

THE RIDGES OF RICE LAKE
ELK RIVER, MN
DYNAMICS DESIGN & LAND CO.
STREET, SAN. SEWER, STORM SEWER & WATERMAIN CONSTRUCTION PLAN
223RD COURT

SHEET NO. 6 OF 16