STORM SEWER EASEMENTS

RECORD DRAWINGS

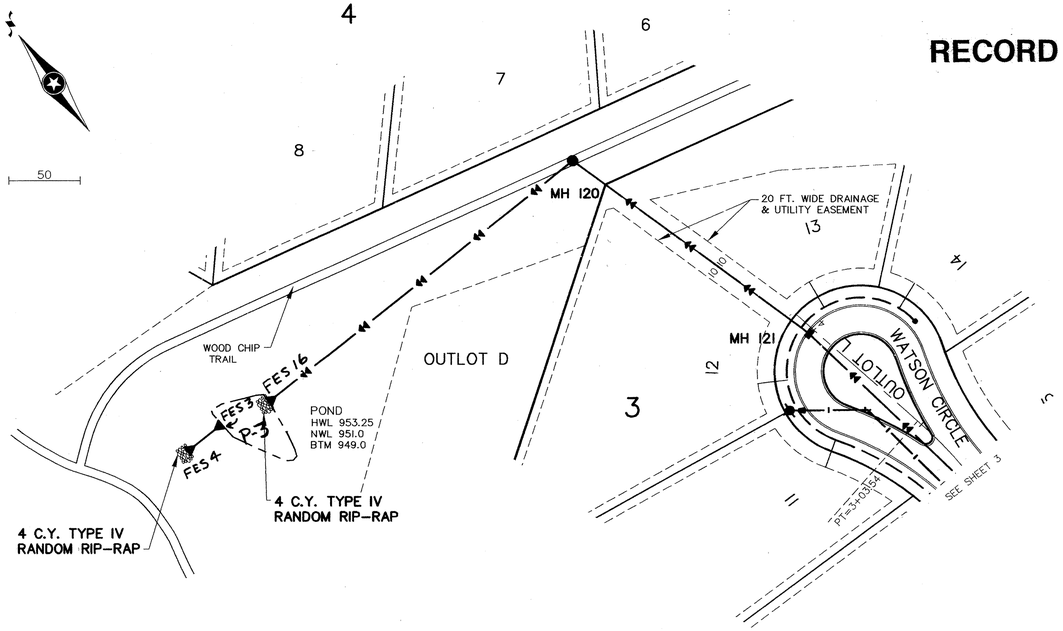

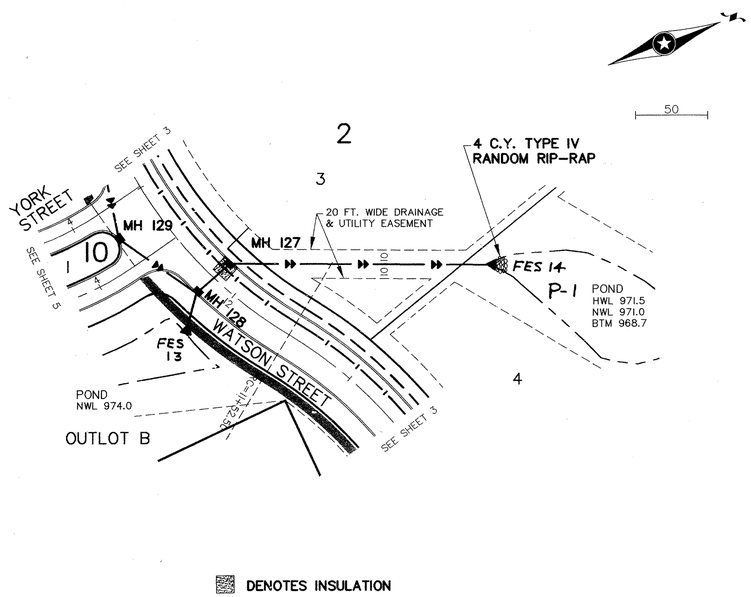

DENOTES INSULATION

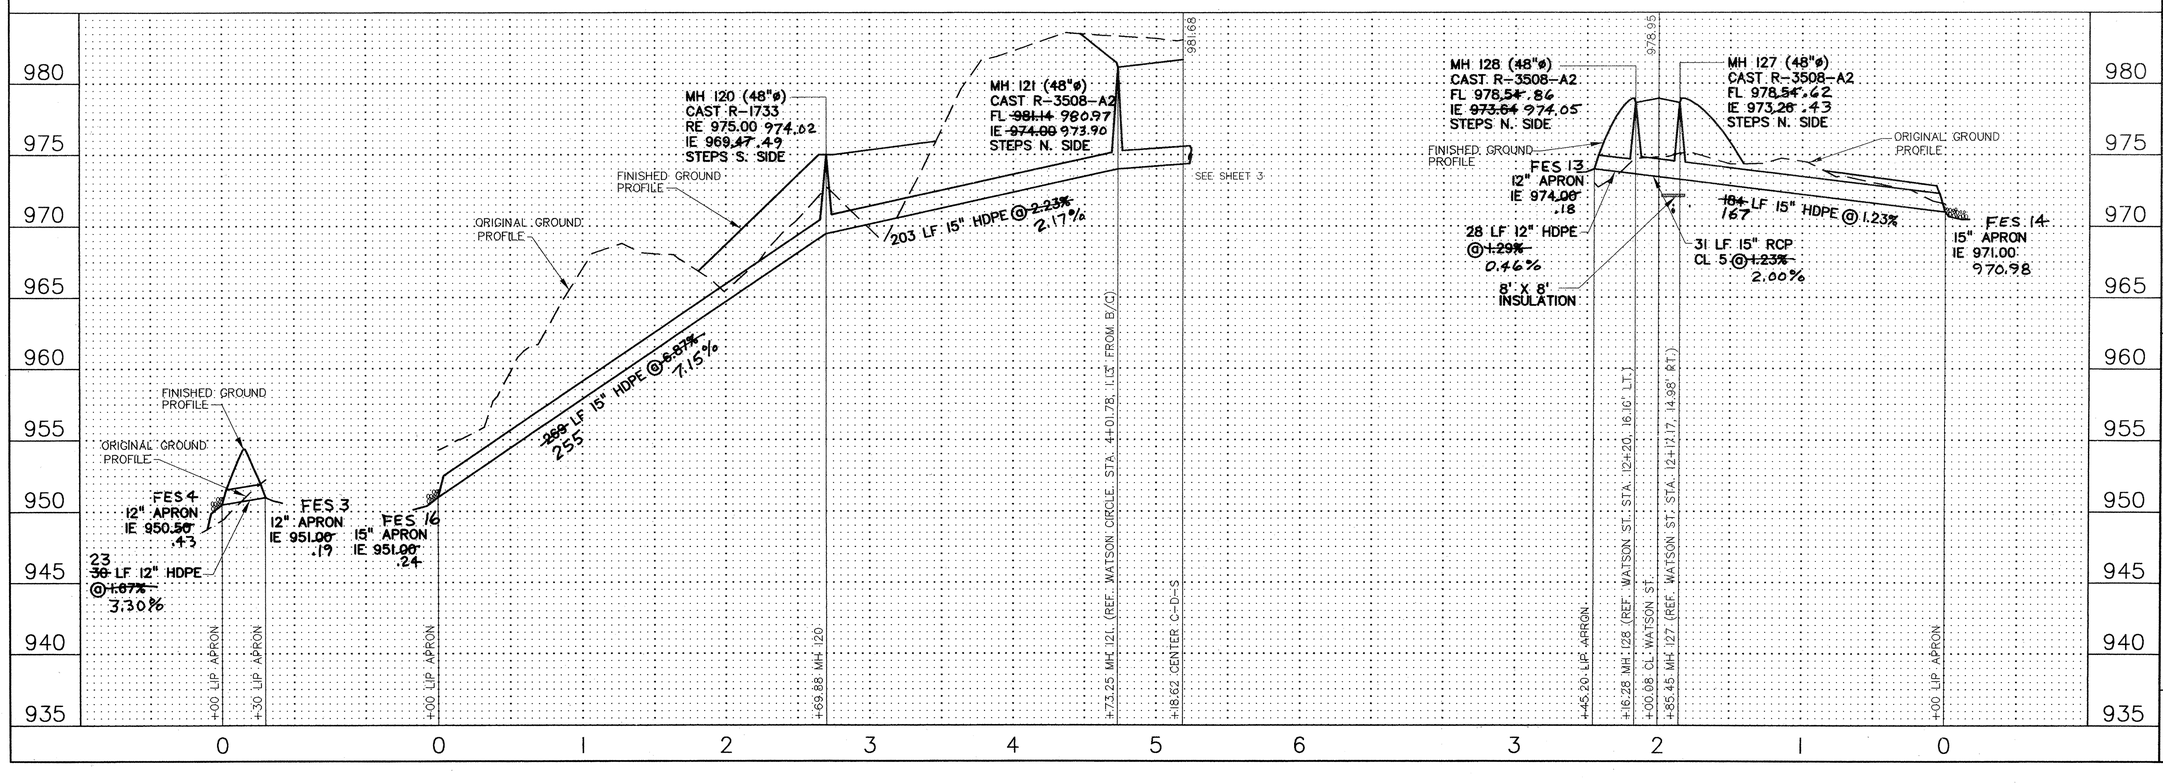

REV NO.	DATE	DESCRIPTION
2	5/9/01	CITY COMMENTS
3	1/18/05	RECORD DRAWINGS

DATE: 4/9/01
DESIGN BY: JK/BM
DRAWN BY: BJC
CHECKED BY: JK/BM
DWG FILE: 1.3STORM
TEXT FILE: NONE
FILE NO.: 7918.10-03

I hereby certify that this plan, specification, or report was prepared by me or under my direct supervision and that I am a duly Licensed Professional Engineer under the laws of the state of Minnesota.

Signature: [signature]
Date: 4/9/01 Reg. No. 26777

John Oliver & Associates, Inc.
Civil Engineering, Land Surveying, Land Planning
580 Dodge Avenue
Elk River, Minnesota 55330
763-441-2072 FAX 763-441-5665
Offices in: Elk River, Burnsville and Brooklyn Park, Minnesota

THE RIDGES OF RICE LAKE
ELK RIVER, MN
DYNAMICS DESIGN & LAND CO.
STREET, SAN. SEWER, STORM SEWER & WATERMAIN CONSTRUCTION PLAN
STORM SEWER EASEMENTS

SHEET NO. 13 OF 16

DRAWING UNAWARD
