
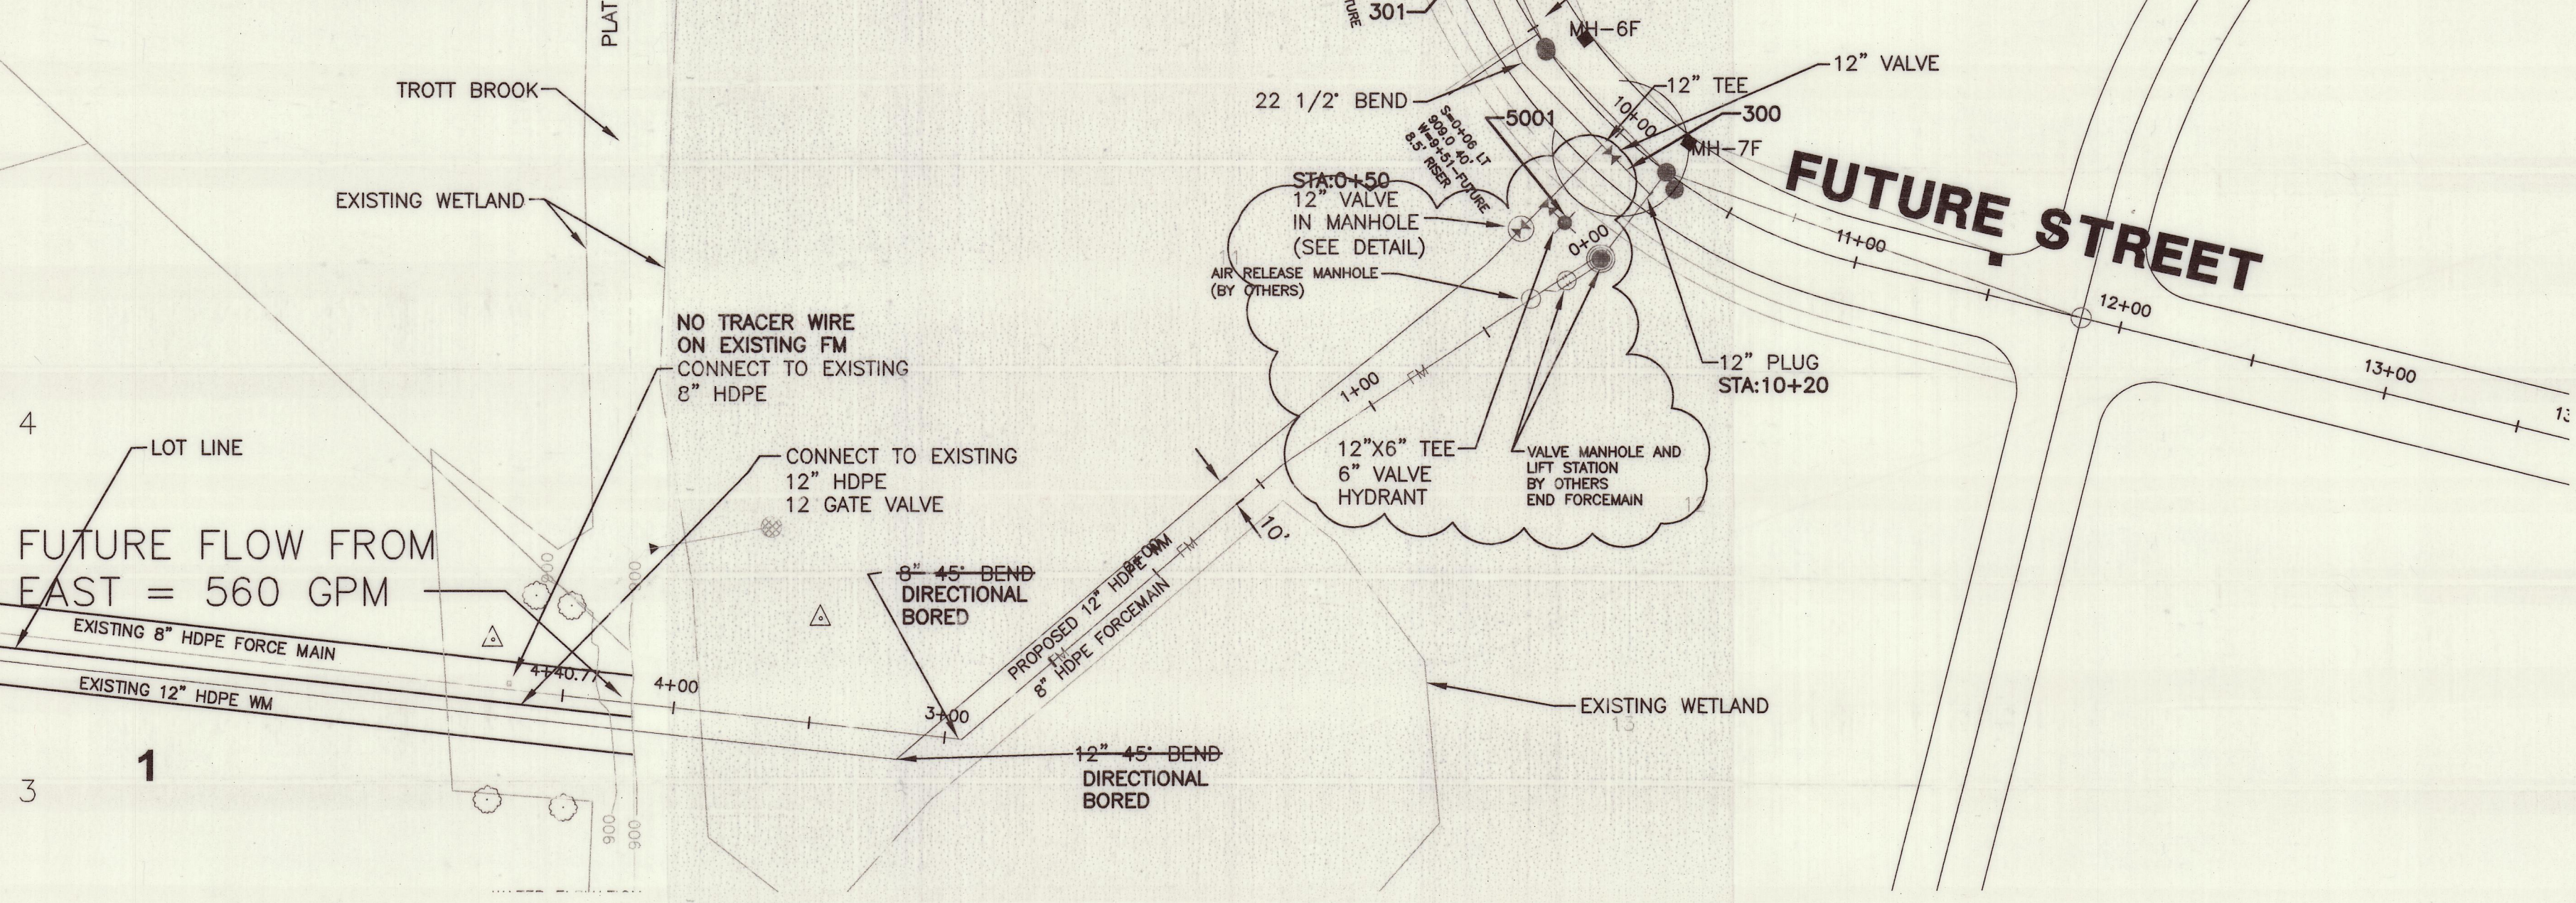


**TROTT BROOK FARM
EIGHTH ADDITION
BLOCK 1**

FOSTER PROPERTY



FUTURE STREET

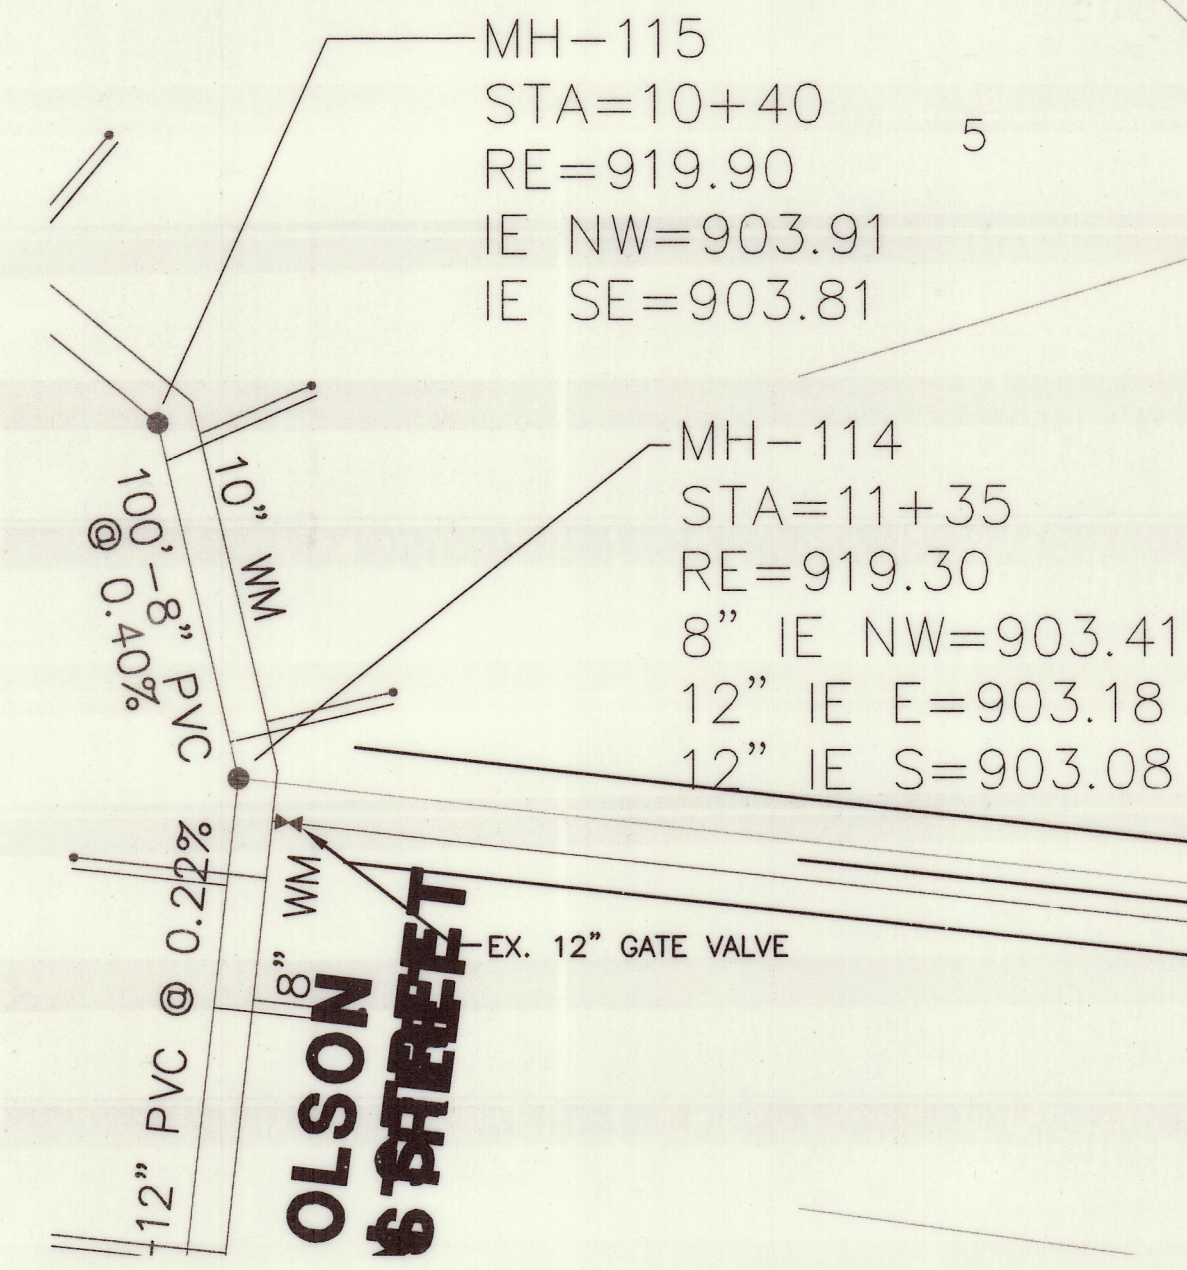

- NOTES:**
- STATIONING SHOWN FOR MANHOLE IS CENTERLINE STREET STATIONING.
 - SERVICE WYE STATIONING IS FROM DOWNSTREAM MANHOLE.
 - EXTEND SERVICES TO PROPERTY WHERE NO SIDEWALK IS PROPOSED AND TO 9' BEHIND PROPERTY LINE WHERE SIDEWALK IS PROPOSED.
 - STATIONING FOR CURB STOPS IS CENTERLINE STREET STATIONING.
 - SINGLE FAMILY LOT WATER SERVICES SHALL BE 1" TYPE K COPPER TUBE. TOWNHOME BUILDING SERVICES SHALL BE 6" DIP.
 - SANITARY SEWER SERVICES SHALL BE 4" PVC, SCH. 40 UNLESS NOTED AS DEEP. THEN SERVICE SHALL BE DIP TO THE TOP OF THE MAIN RISER THEN TRANSITION TO PVC. TOWNHOME BUILDING SEWER SERVICES SHALL BE 6" PVC, SCH. 40.

WARNING

THE CONTRACTOR SHALL CONTACT ALL PUBLIC UTILITIES FOR LOCATIONS OF ALL UNDERGROUND WIRES, CABLES, CONDUITS, PIPES, MANHOLES, VALVES, OR OTHER BURIED STRUCTURES BEFORE DIGGING. HE SHALL REPAIR OR REPLACE THE ABOVE WHEN DAMAGED DURING CONSTRUCTION AT NO COST TO OWNER.

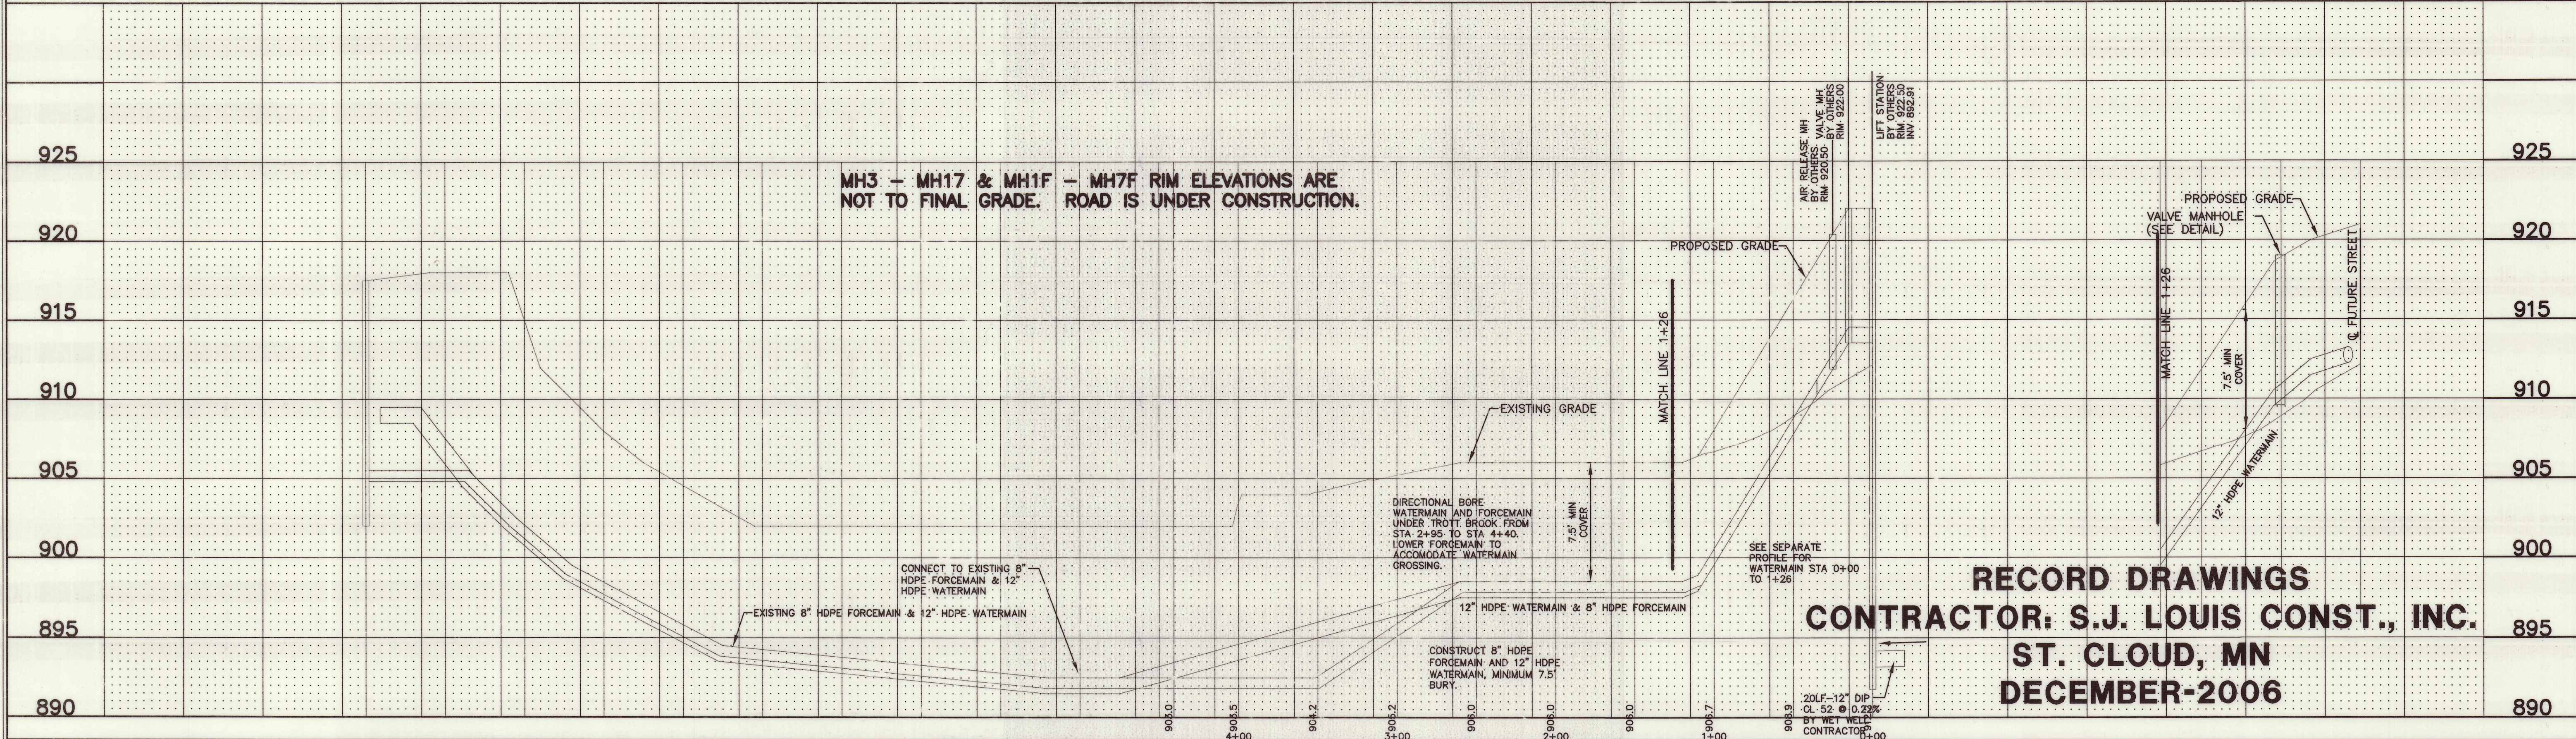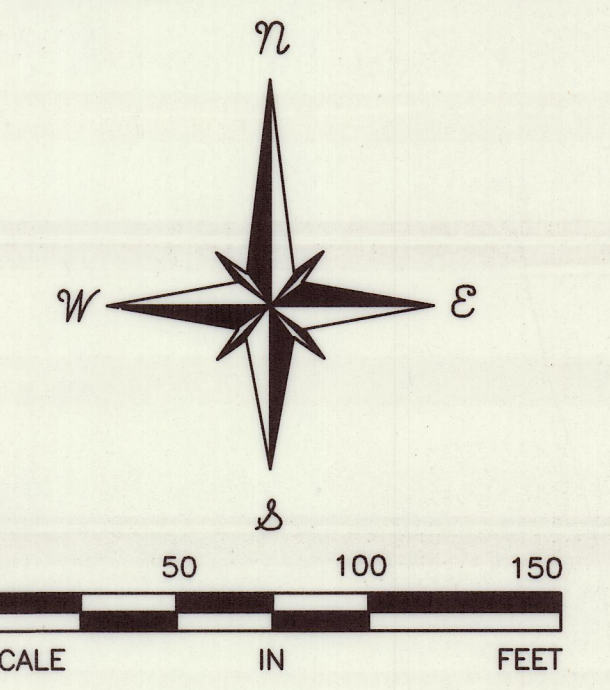

Date:	Description:	By:	Date:	Description:	By:
08/29/05	Profile revision	CB	11-07-05	GENERAL REVISIONS	BDR
9-20-05	REVISIONS PER CITY COMMENTS	BDR	12-22-06	UTILITY ASBULTS	BB
10-05-05	REVISIONS GV/WM LOCATION	CB			
10-18-05	CITY COMMENTS	BDR			

I hereby certify that this plan was prepared by me or under my direct supervision and that I am a Licensed Professional Engineer under the laws of the State of Minnesota.

Brian Robideau
Date: 08/23/05 Reg. No. 43382

Designed By: BDR
Drawn By: BDR
Checked By: KA

Schoell & Madson, Inc.
Engineering • Surveying • Planning

10580 Wayzata Boulevard, Suite 1
Minneapolis, Minnesota 55305-1525
phone: (952) 546-7601 - fax: (952) 546-9065

554 Third Street NW, Suite 100
Elk River, Minnesota 55330-1409
phone: (763) 241-0108 - fax: (952) 546-9065

Client:

Orrin Thompson Homes
935 East Wayzata Boulevard
Wayzata, Minnesota 55391
19521 249-3076

Project Name/Location: **River Park
Elk River, Minnesota**

Date: **08/23/05**

Sheet Title: **UTILITY CONSTRUCTION
FOSTER PROPERTY**

Sheet: **UTIL1**

DRAWING NUMBER
