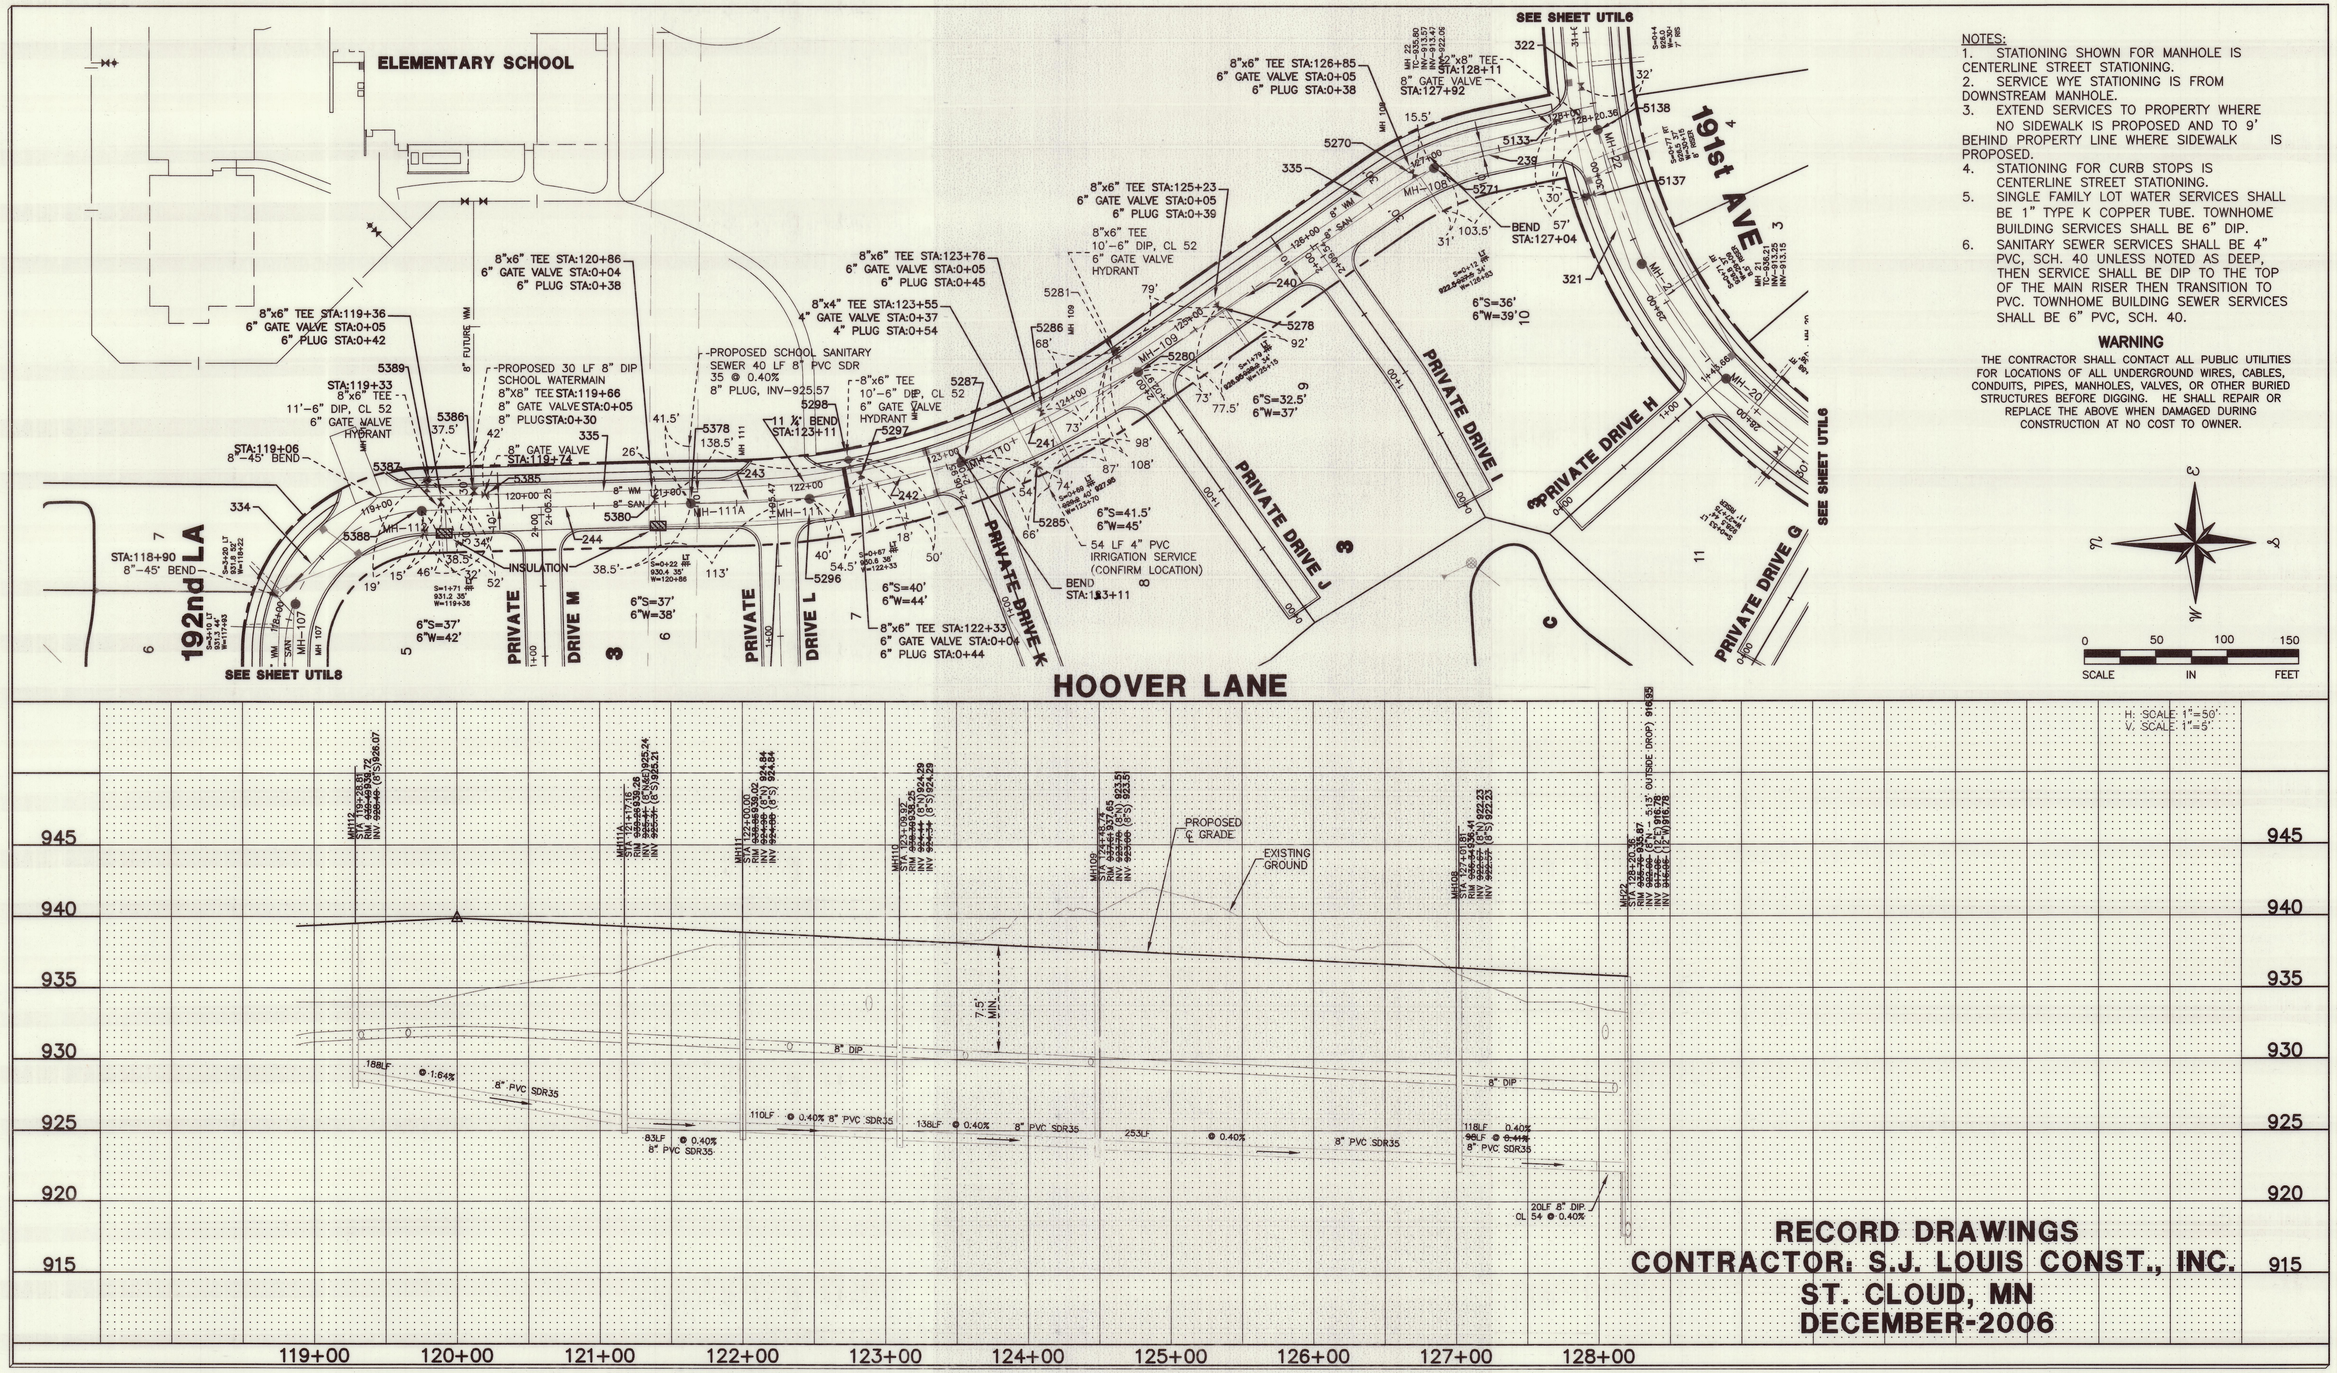
ELEMENTARY SCHOOL
SEE SHEET UTIL6
192nd LA
191st AVE
HOOVER LANE
PRIVATE DRIVE M
PRIVATE DRIVE L
PRIVATE DRIVE K
PRIVATE DRIVE J
PRIVATE DRIVE I
PRIVATE DRIVE H
PRIVATE DRIVE G
8"x6" TEE STA:119+36
6" GATE VALVE STA:0+05
6" PLUG STA:0+42
8"x6" TEE STA:120+86
6" GATE VALVE STA:0+04
6" PLUG STA:0+38
8"x6" TEE STA:123+76
6" GATE VALVE STA:0+05
6" PLUG STA:0+45
8"x6" TEE STA:125+23
6" GATE VALVE STA:0+05
6" PLUG STA:0+39
8"x6" TEE STA:126+85
6" GATE VALVE STA:0+05
6" PLUG STA:0+38
8"x6" TEE STA:128+11
6" GATE VALVE
STA:127+92
8"x4" TEE STA:123+55
4" GATE VALVE STA:0+37
4" PLUG STA:0+54
8"x6" TEE STA:122+33
6" GATE VALVE STA:0+04
6" PLUG STA:0+44
PROPOSED 30 LF 8" DIP
SCHOOL WATERMAIN
8"X8" TEE STA:119+66
8" GATE VALVE STA:0+05
8" PLUG STA:0+30
PROPOSED SCHOOL SANITARY
SEWER 40 LF 8" PVC SDR
35 @ 0.40%
8" PLUG, INV-925.57
54 LF 4" PVC
IRRIGATION SERVICE
(CONFIRM LOCATION)
BEND
STA:123+11
BEND
STA:127+04
STA:119+33
8"x6" TEE
11'-6" DIP, CL 52
6" GATE VALVE
HYDRANT
STA:119+06
8"-45° BEND
STA:118+90
8"-45° BEND
8" GATE VALVE
STA:119+74
8"x6" TEE
10'-6" DIP, CL 52
6" GATE VALVE
HYDRANT
8"x6" TEE
10'-6" DIP, CL 52
6" GATE VALVE
HYDRANT
11 ¼° BEND
STA:123+11
6"S=37'
6"W=38'
6"S=37'
6"W=42'
6"S=40'
6"W=44'
6"S=41.5'
6"W=45'
6"S=32.5'
6"W=37'
6"S=36'
6"W=39'
INSULATION
8" FUTURE WM
MH-107
MH-108
MH-109
MH-110
MH-111
MH-111A
MH-112
MH-20
MH-21
