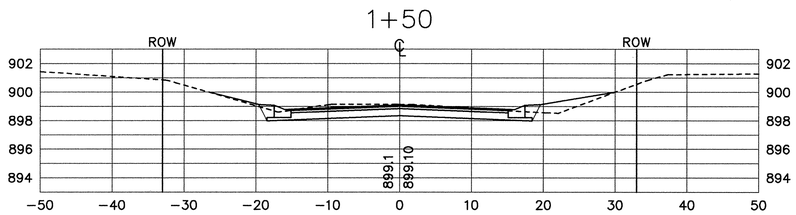

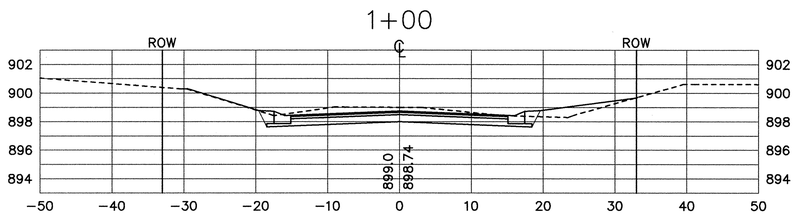

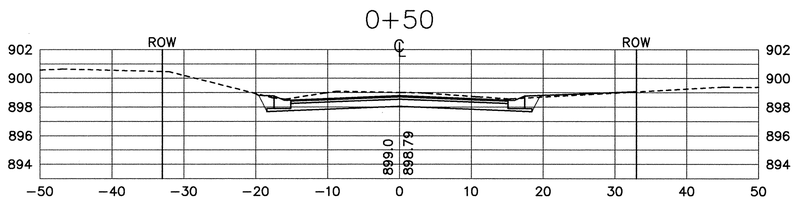

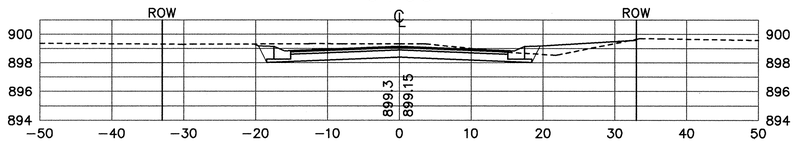

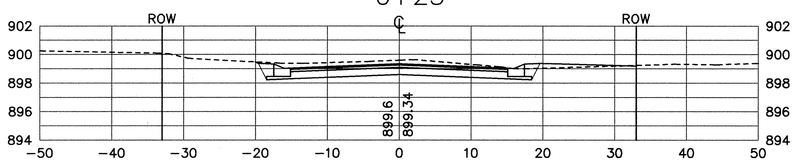

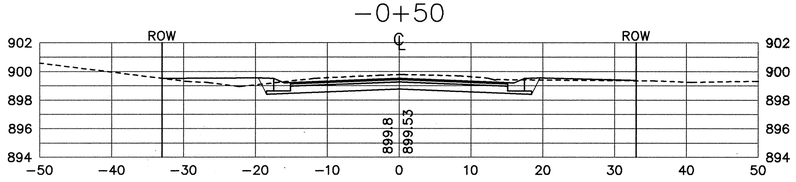

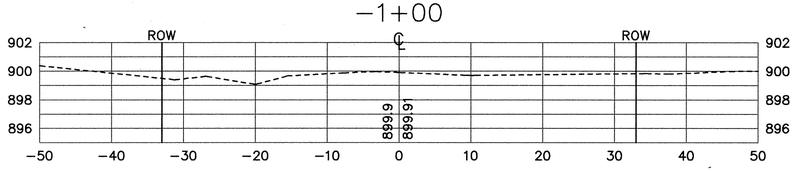

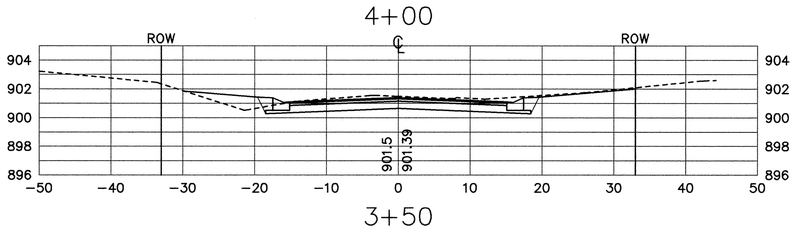

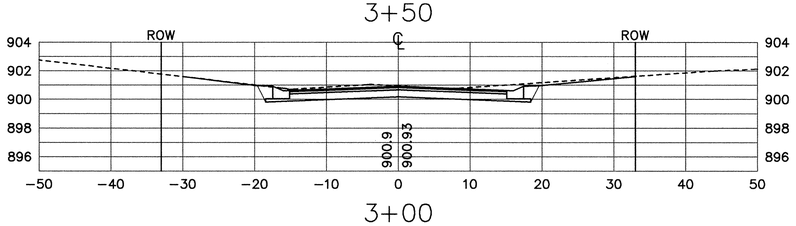

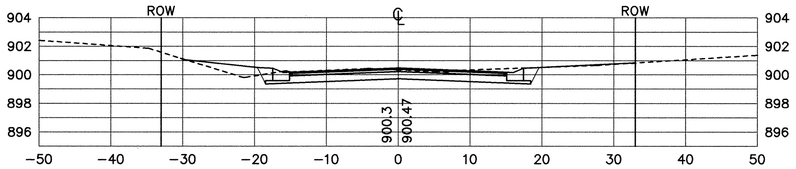

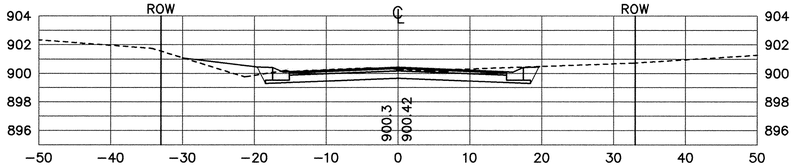

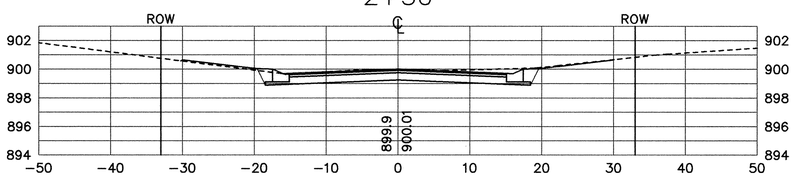

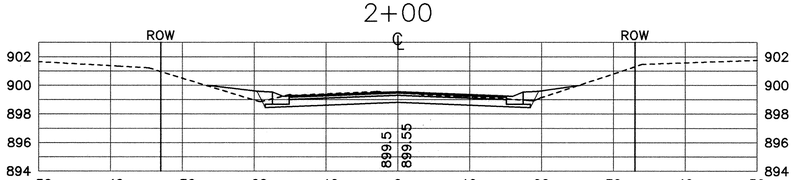

RECORD PLAN
FEBRUARY 1998

I HEREBY CERTIFY THAT THIS PLAN, SPECIFICATION, OR REPORT WAS PREPARED BY ME OR UNDER MY DIRECT SUPERVISION AND THAT I AM A DULY REGISTERED PROFESSIONAL ENGINEER UNDER THE LAWS OF THE STATE OF MINNESOTA.

Mark V. Graham

DATE 3/16/98 REG.NO. 19130

MSA CONSULTING ENGINEERS
1326 ENERGY PARK DRIVE
ST. PAUL, MINNESOTA 55108
(612) 644-4389

REVISIONS

DATE	DESCRIPTION

DESIGNED
CHECKED
DRAWN
GRAPHIC SCALE 0 10
0 VERT. 5

CITY OF ELK RIVER
RIVERVIEW DRIVE
STREET AND UTILITY IMPROVEMENTS
CROSS SECTIONS
−1+00 TO 4+00

DATE JUNE 1997 | SHEET 10 OF 20 SHEETS | PROJECT NO. 230-365-20

ER365X1

1274

DRAWING NUMBER

DRAWING NUMBER
RIVER 97
10

SAFCO PRODUCTS • NEW HOPE, MINNESOTA
REORDER BY PART NUMBER 65302
PERFORATIONS AT RIGHT ANGLES TO FOLD LINE
PERFORATIONS AT RIGHT ANGLES TO FOLD LINE

D:\CAD\230365W\ER365X1.dwg Fri Mar 13 11:48:01 1998