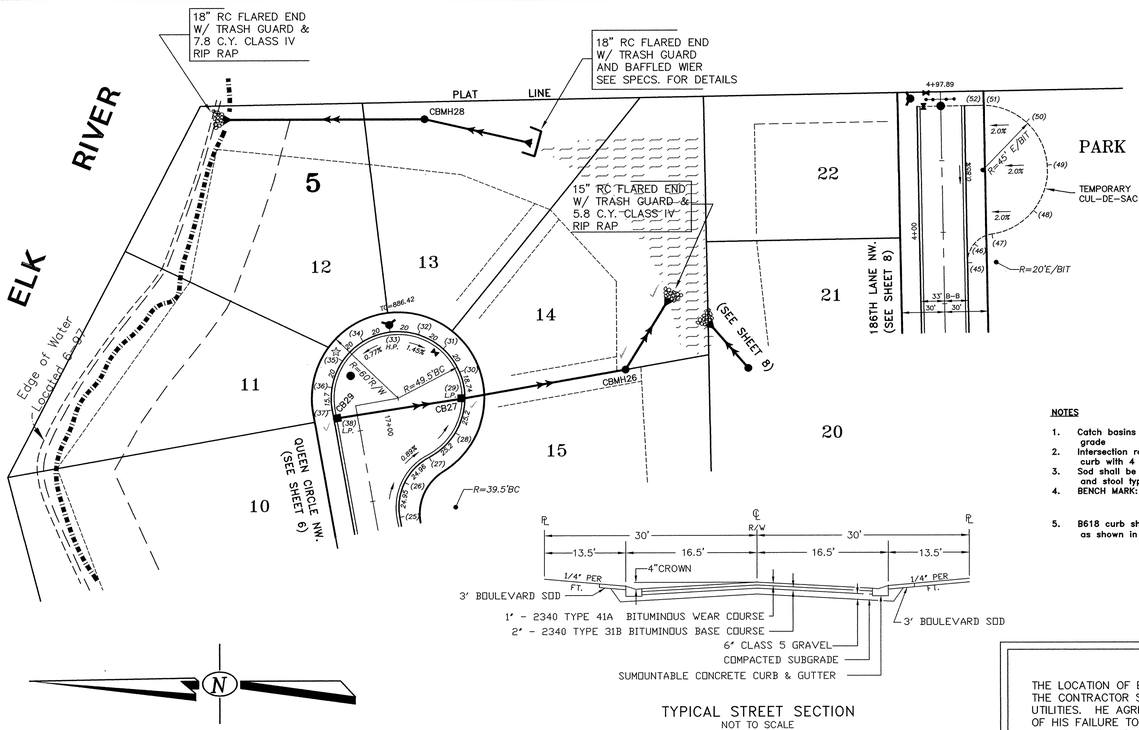

TOP OF CURB TABLE

13.	882.32	*	33.	886.42	* H.P.
14.	882.24	*	34.	886.28	*
15.	882.17	*	35.	886.13	*
16.	882.17	*	36.	885.99	*
17.	881.91	*	37.	885.84	* L.P.
18.	881.64	*			
25.	886.17	*	45.	879.47	*
26.	885.95	*	46.	879.73	**
27.	885.73	*	47.	879.99	**
28.	885.51	*	48.	880.71	**
29.	885.28	* L.P.	49.	881.17	**
30.	885.57	*	50.	881.16	**
31.	885.85	*	51.	880.68	**
32.	886.14	*	52.	880.41	*

* DENOTES TOP OF SURMOUNTABLE CURB. ADD 0.17' FOR TRUE TOP OF B618 CURB.

** DENOTES EDGE OF BITUMINOUS

NOTES

1. Catch basins shall be depressed 0.1 feet from gutter grade
2. Intersection radius and 16 feet each side shall be B-618 type curb with 4 foot transition to Surmountable.
3. Sod shall be placed and pegged around all storm sewer aprons and stool type catch basins.
4. BENCH MARK: TNH SE CORNER LOT 1, BLOCK 1 RIVERPLACE & SOUTH SIDE OF 185 TH AVE. NW ELEV.=891.47
5. B618 curb shall be installed on both sides of catch basins as shown in Std. Plate No. 2005

TYPICAL STREET SECTION
NOT TO SCALE

STORM SEWER

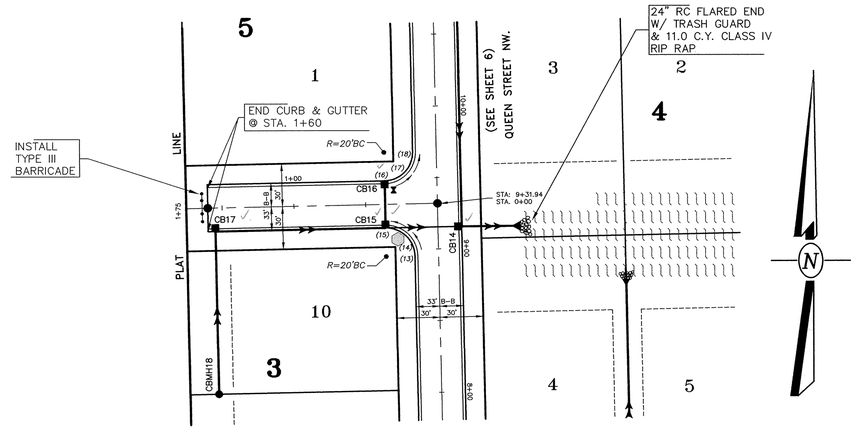

STRUCTURE TABLE

STRUCTURE	STRUCTURE TYPE	CASTING	CASTING TYPE
CB14	48" SLAB TOP	R-3067-V	
CB15	48" SLAB TOP	R-3067-V	
CB16	2'X3' RECT.	R-3067-V	
CB17	48" SLAB TOP	R-3067-V	
CB18	48" SLAB TOP	R-4342	STOOL
CBMH26	48" SLAB TOP	R-1733	SOLID
CB27	48" SLAB TOP	R-3067-V	
CBMH28	48" SLAB TOP	R-1733	SOLID
CB29	2'X3' RECT.	R-3067-V	
ALL CASTING SHALL BE BICYCLE FRIENDLY			

186TH AVENUE NW.

WARNING:

THE LOCATION OF EXISTING UTILITIES SHOWN ARE SHOWN IN AN APPROXIMATE WAY ONLY. THE CONTRACTOR SHALL BE RESPONSIBLE FOR LOCATING AND PROTECTING ALL EXISTING UTILITIES. HE AGREES TO BE FULLY RESPONSIBLE FOR ANY AND ALL DAMAGES ARISING OUT OF HIS FAILURE TO PROPERLY LOCATE AND/OR PRESERVE THEM. ALL EXISTING UTILITIES MAY NOT BE SHOWN

CITY OF ELK RIVER,
CITY ENGINEER: _____ DATE: _____

REV. NO.	DATE	REVISION
1	5-08-98	STREET X-SECTION, CURB NOTES, STREET BARRICADE

I hereby certify that this plan, specification, or report was prepared by me or under my direct supervision and that I am a duly registered Professional Engineer under the laws of the State of Minnesota.

Reg. No. 16753 Date 5-31-98

SCALE: HORIZONTAL 1" = 50'
VERTICAL 1" = 5'
RECORD PLAN

STREET & STORM SEWER PROFILE
186TH AVENUE NW. & E. PROPERTY LINE
RIVERPLACE
ELK RIVER, MINNESOTA

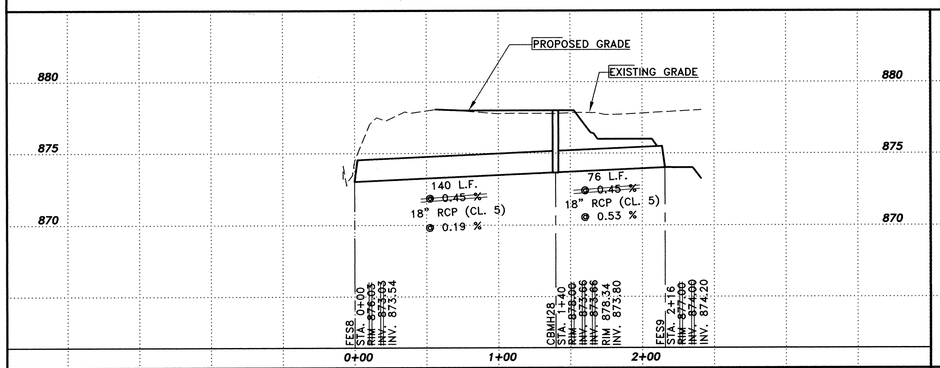

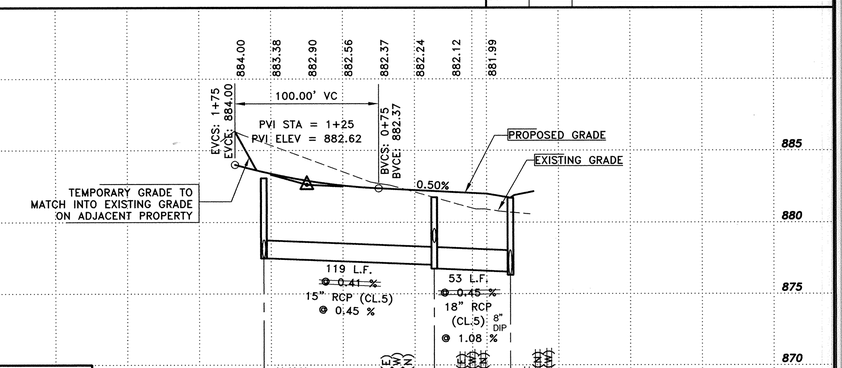

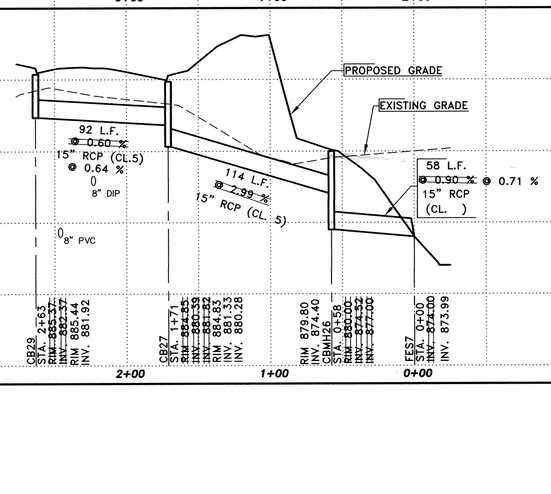

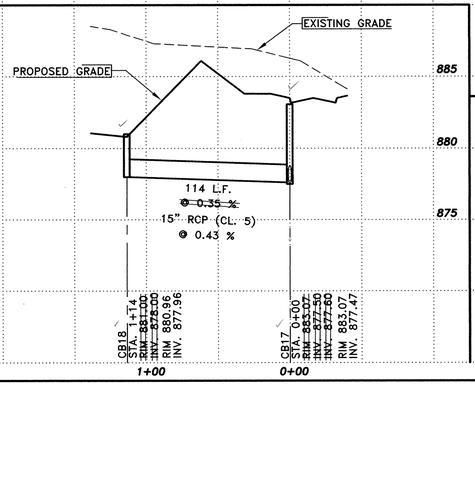

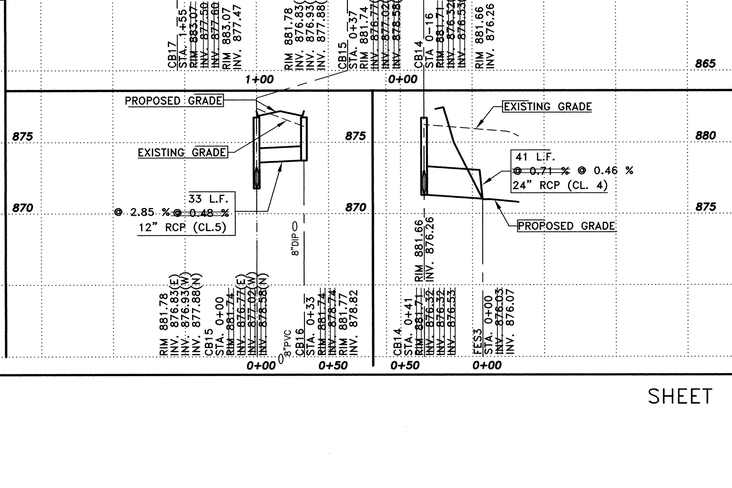

MIDWEST
Land Surveyors & Civil Engineers, Inc.
199 Coon Rapids Blvd.
Coon Rapids, MN 55433
Ph. 612-786-8500 Fax 612-786-9206
Job No. 144-18 Book-Page Acad file 144-18PS

© 1998-Midwest Land Surveyors & Civil Engineers, Inc. - All Rights Reserved

1379

SIECO PRODUCTS • NEW HOPE, MINNESOTA
REORDER BY PART NUMBER 6550