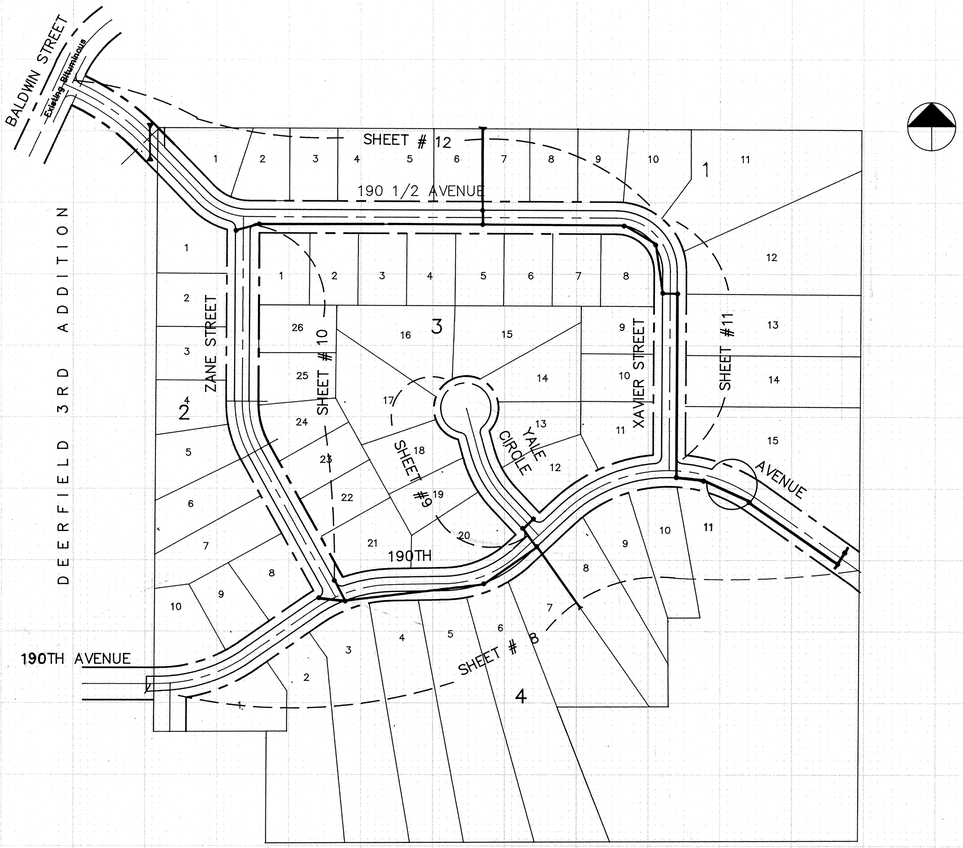

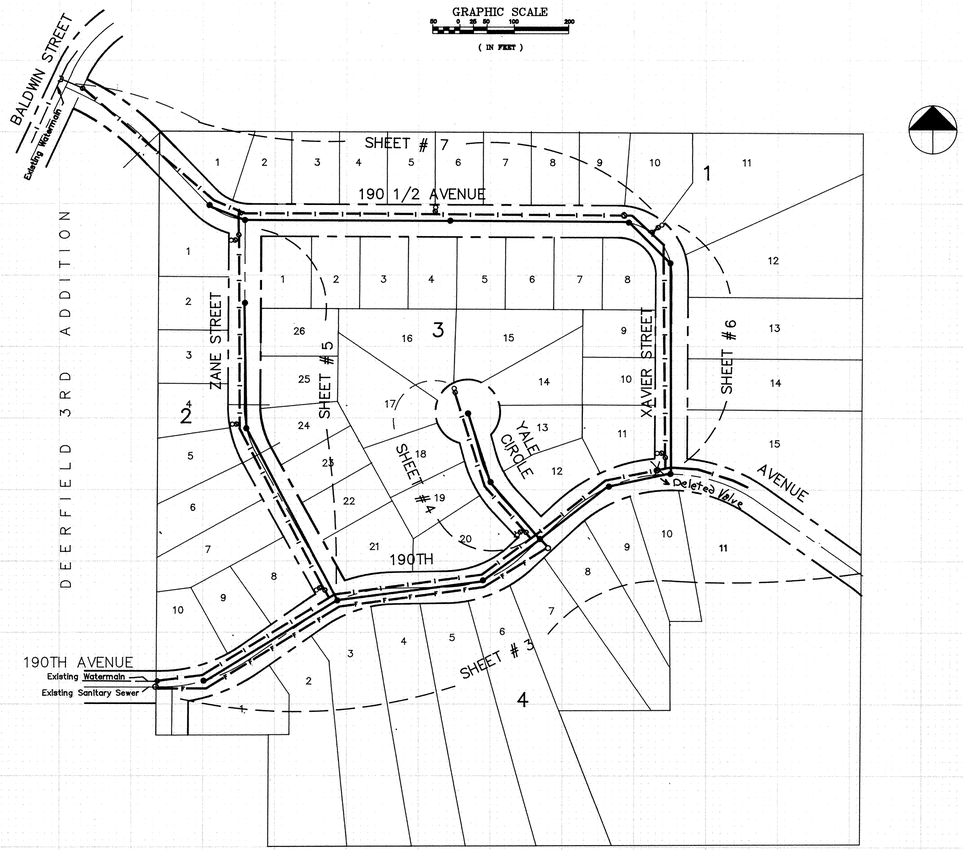

STREET AND STORM SEWER

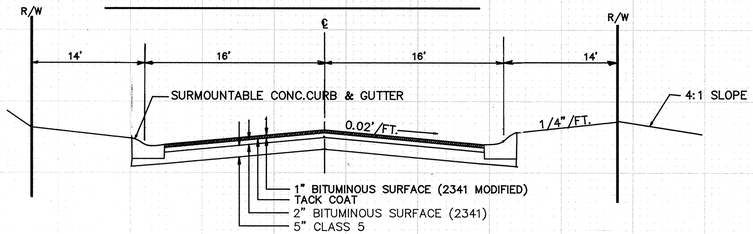

TYPICAL SECTION

SANITARY SEWER AND WATERMAIN

NOTES:
1. HYDRANT SHALL CONSIST OF HYDRANT, VALVE & 6" PIPE
2. ALL RCP FLARED END SECTIONS SHALL INCLUDE A TRASH GUARD
3. ALL STORM SEWER INLET CASTINGS SHALL BE R-3250A
4. ALL CONC. CURB & GUTTER RADIUS SHALL 15' UNLESS OTHERWISE NOTED

RECORD PLAN NOV. 1988

CONSULTING ENGINEERS
Maier Stewart & Associates Inc.
480 CEDAR STREET (612)227-9475 ST. PAUL, MINNESOTA 55101

REVISIONS	DATE	DESCRIPTION

DESIGNED
CHECKED
DRAWN
GRAPHIC SCALE
HORIZ. NONE
VERT. NONE

CITY OF ELK RIVER
ROYAL OAKS RIDGE
LOCATION MAP

DATE MAR.1988 SHEET 2 OF 17 SHEETS PROJECT NO. 230-034

290

MINNESOTA BLUEPRINT

DRAWING NUMBER
SAFCO PRODUCTS • NEW HOPE, MINNESOTA
REORDER BY PART NUMBER 60532
POSITION SIDE OF PRINT ON THIS LINE

DRAWING NUMBER
ROYAL 88
2