Fed. Proj. No.

INDEPENDENT SCHOOL DISTRICT NO. 728

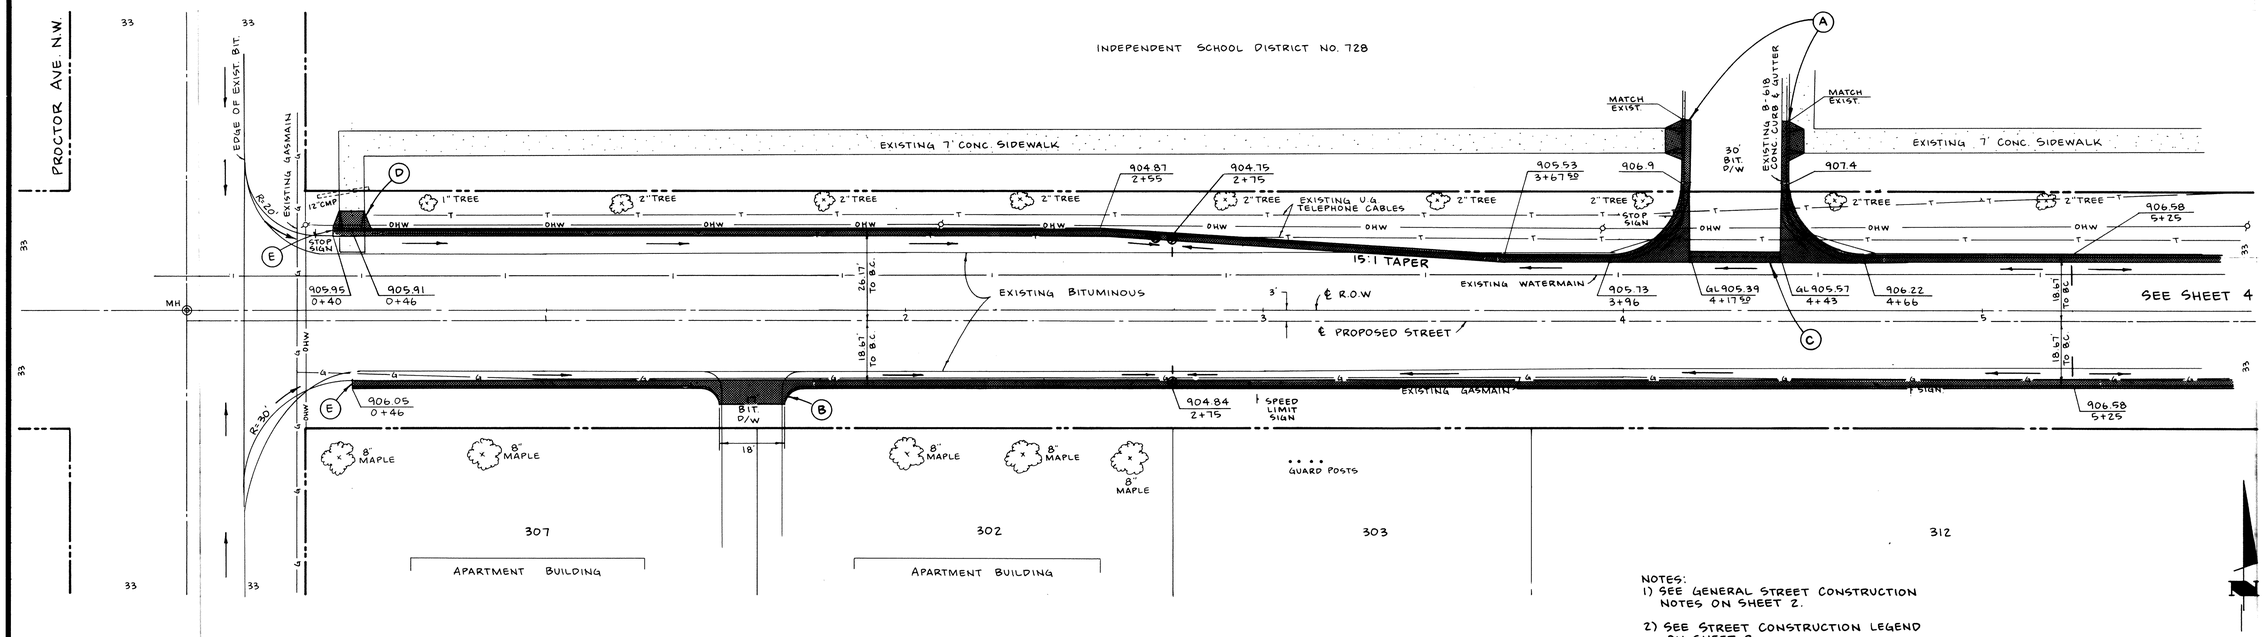

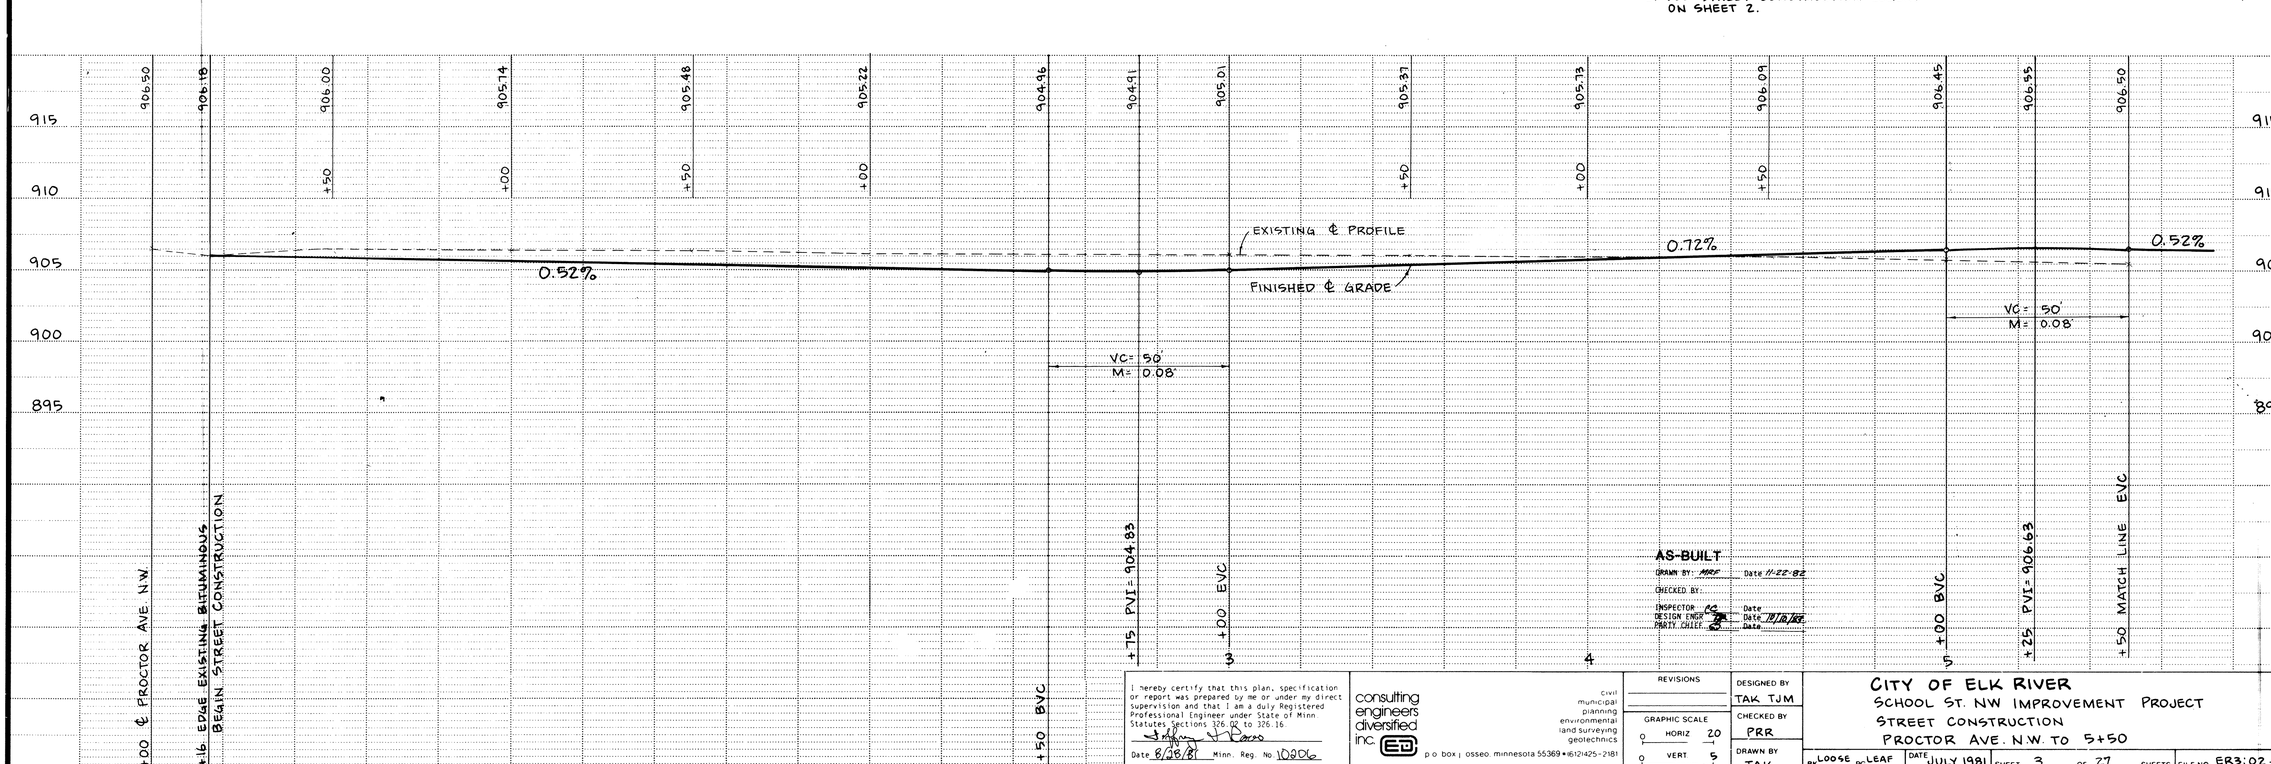

AS-BUILT
DRAWN BY: MRF Date 11-22-82
CHECKED BY:
INSPECTOR
DESIGN ENGR. Date 11/8/82
PARTY CHIEF Date

I hereby certify that this plan, specification or report was prepared by me or under my direct supervision and that I am a duly Registered Professional Engineer under State of Minn. Statutes Sections 326.02 to 326.16.
Date 8/28/81 Minn. Reg. No. 10906

consulting engineers diversified inc.
Civil municipal planning environmental land surveying geotechnics
p.o. box | osseo, minnesota 55369 • (612)425-2181

REVISIONS	DESIGNED BY	CITY OF ELK RIVER
	TAK TJM	SCHOOL ST. NW IMPROVEMENT PROJECT
GRAPHIC SCALE	CHECKED BY	STREET CONSTRUCTION
0 HORIZ 20	PRR	PROCTOR AVE. N.W. TO 5+50
0 VERT 5	DRAWN BY TAK	BK LOOSE PG LEAF · DATE JULY 1981 · SHEET 3 OF 27 SHEETS · FILE NO ER3:02-5

State Proj. No. 204-107-01 **Sheet No. of Sheets**

DRAWING NUMBER
DRAWING NUMBER SCHOO 81 3