Fed. Proj. No.

INDEPENDENT SCHOOL DISTRICT NO. 278

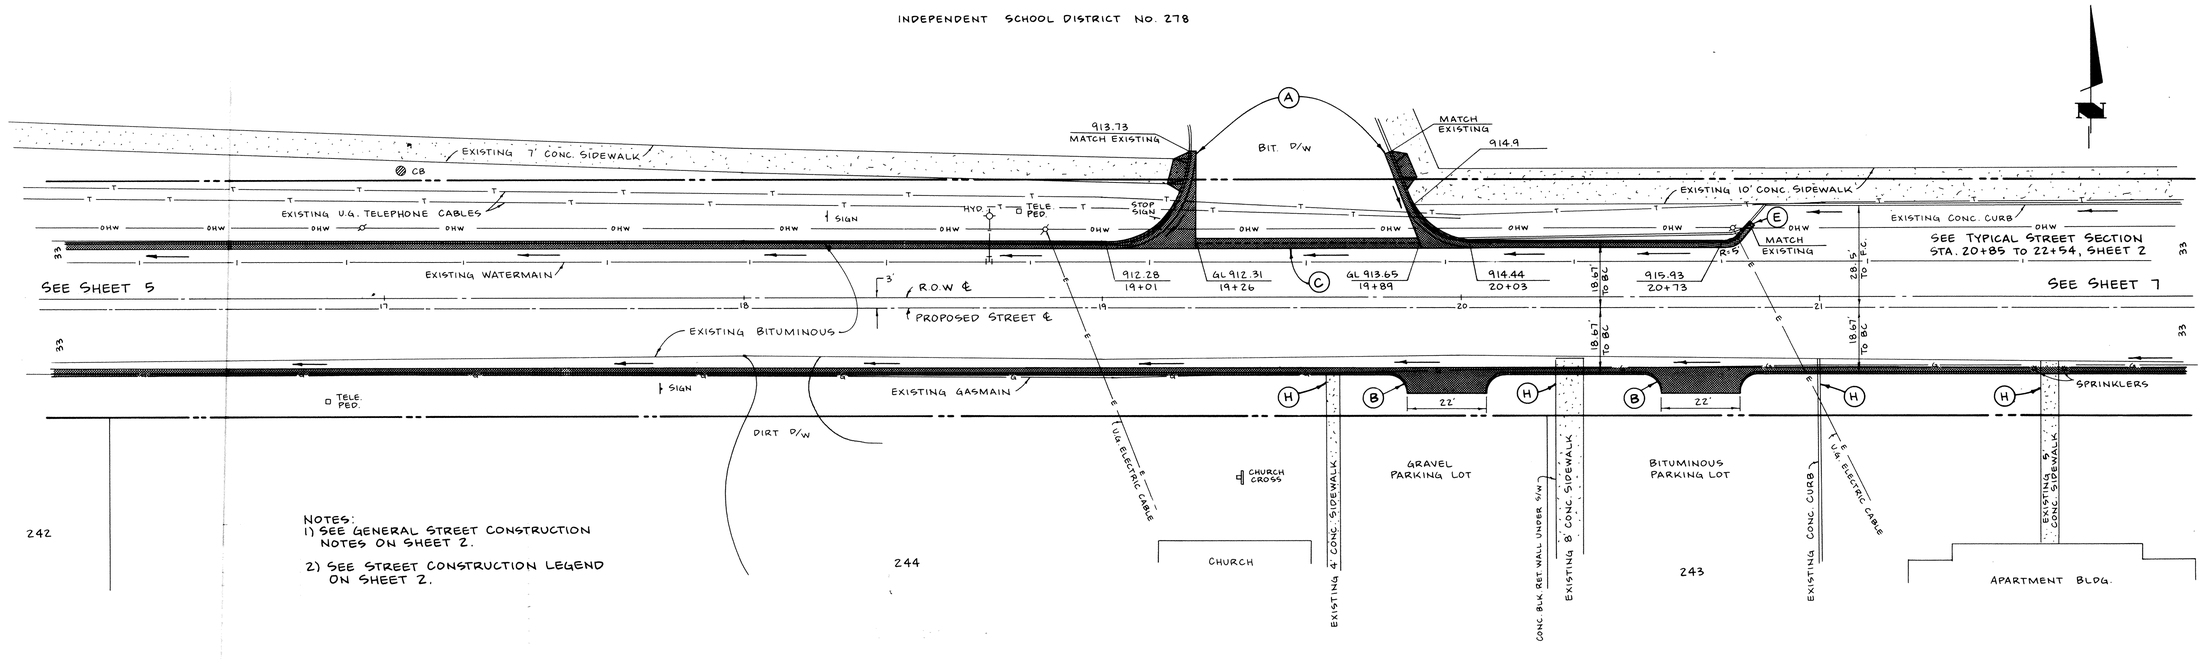

NOTES:
1) SEE GENERAL STREET CONSTRUCTION NOTES ON SHEET 2.
2) SEE STREET CONSTRUCTION LEGEND ON SHEET 2.

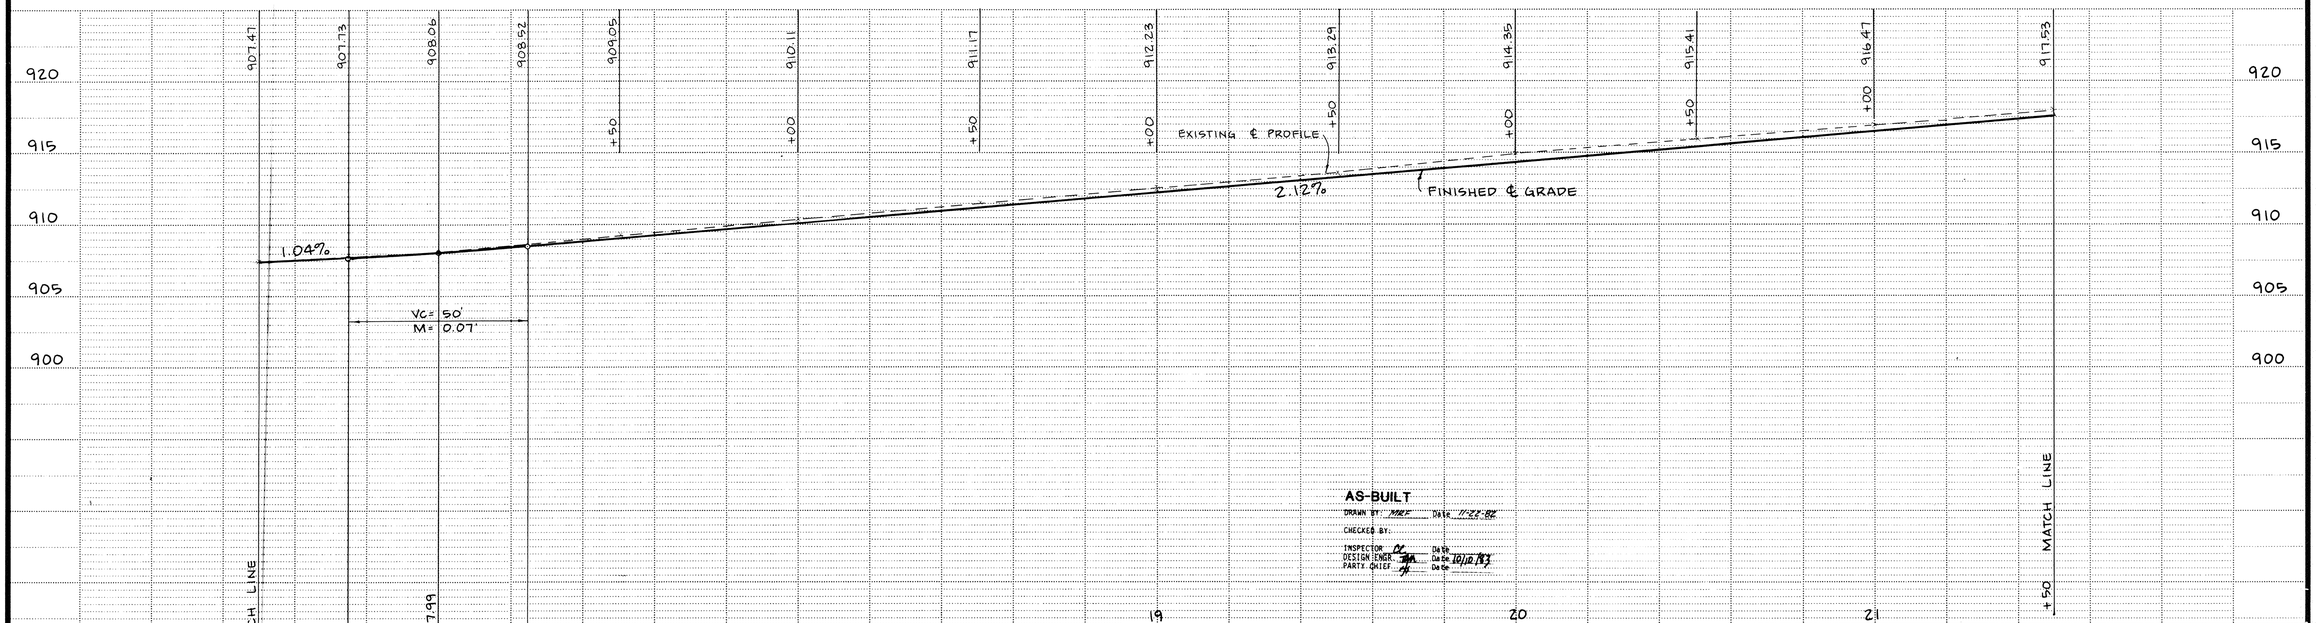

AS-BUILT
DRAWN BY: MRE Date 11-25-82
CHECKED BY:
INSPECTOR Date
DESIGN ENGR. Date 10/0/83
PARTY CHIEF Date

I hereby certify that this plan, specification or report was prepared by me or under my direct supervision and that I am a duly Registered Professional Engineer under State of Minn. Statutes Sections 326.02 to 326.16.
Date 5/26/81 Minn. Reg. No. 10206

consulting engineers diversified inc.
civil municipal planning environmental land surveying geotechnics
p o box; osseo, minnesota 55369 • (612)425-2181

REVISIONS

GRAPHIC SCALE
HORIZ 20
VERT 5

DESIGNED BY TAK TJM
CHECKED BY PRR
DRAWN BY TAK

CITY OF ELK RIVER
SCHOOL ST. N.W. IMPROVEMENT PROJECT
STREET CONSTRUCTION
16+50 to 21+50

BK LOOSE PG LEAF | DATE JULY 1981 | SHEET 6 OF 37 SHEETS | FILE NO. ER3:02-5

State Proj. No. 204-107-01 **Sheet No. of Sheets**

62

DRAWING NUMBER
SCHOO.81
6

DRAWING NUMBER
SUPCO PRODUCTS • NEW HOPE, MINNESOTA
REORDER BY PART NUMBER 10503