Fed. Proj. No.

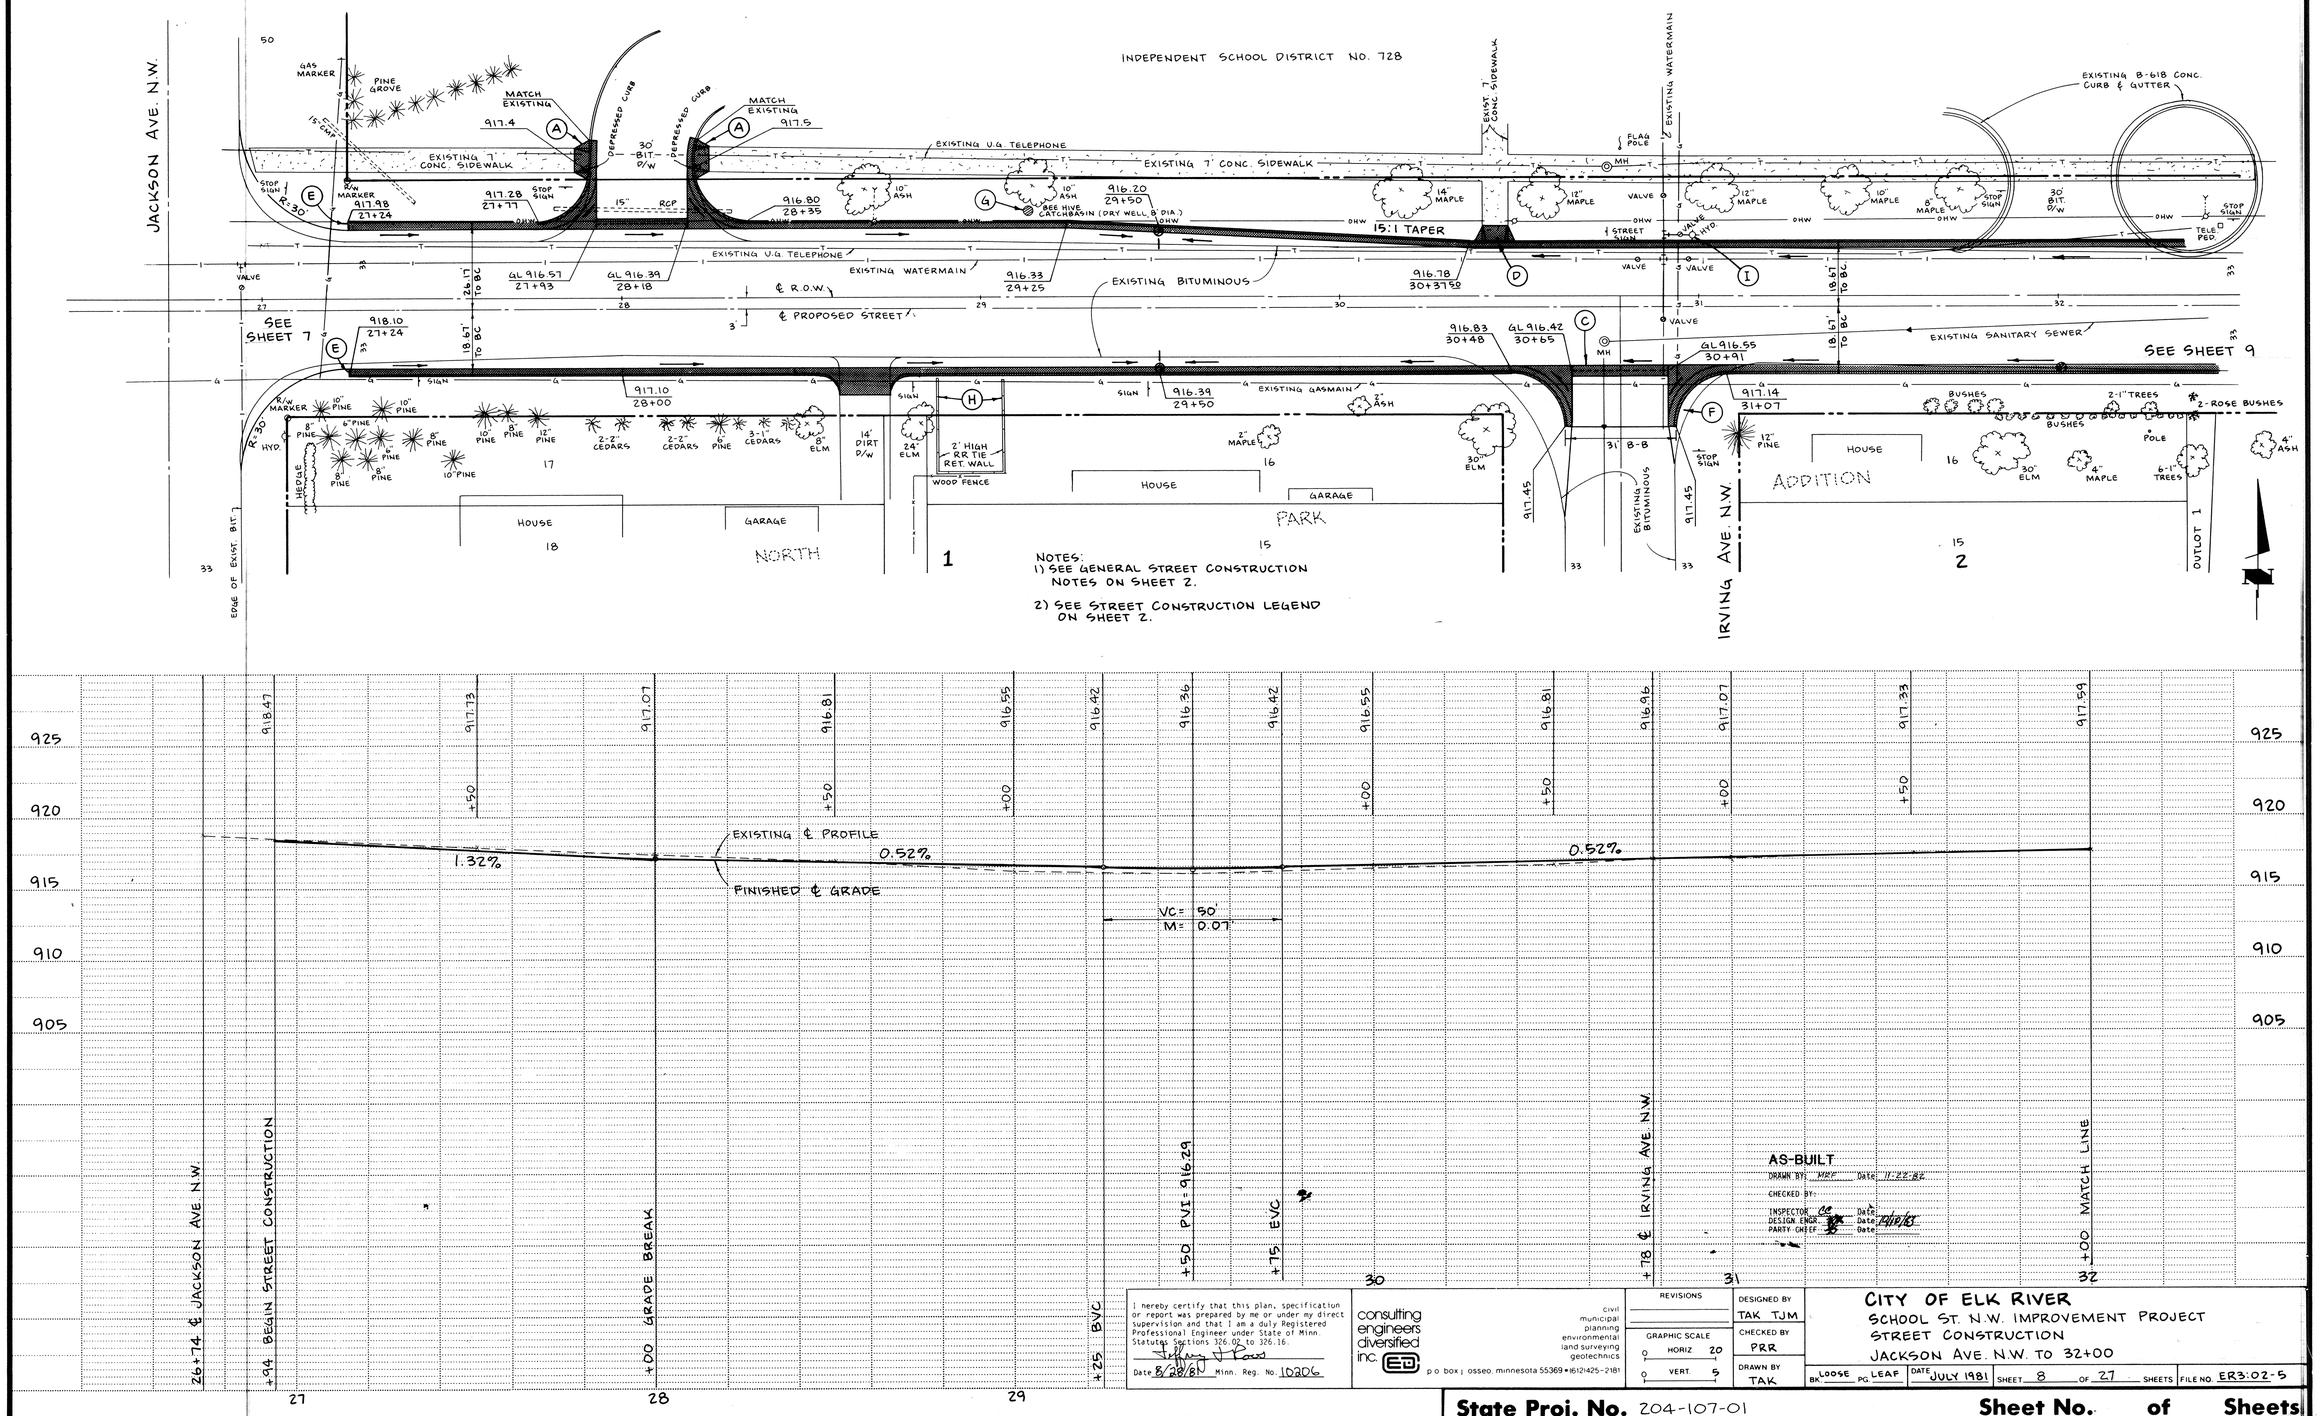

I hereby certify that this plan, specification or report was prepared by me or under my direct supervision and that I am a duly Registered Professional Engineer under State of Minn. Statutes Sections 326.02 to 326.16.

Date 8/28/81 Minn. Reg. No. 10206

consulting engineers diversified inc.

civil municipal planning environmental land surveying geotechnics

p.o. box j osseo, minnesota 55369 • (612)425-2181

REVISIONS

GRAPHIC SCALE HORIZ 0 20 VERT. 0 5

DESIGNED BY TAK TJM

CHECKED BY PRR

DRAWN BY TAK

CITY OF ELK RIVER
SCHOOL ST. N.W. IMPROVEMENT PROJECT
STREET CONSTRUCTION
JACKSON AVE. N.W. TO 32+00

BK. LOOSE PG. LEAF DATE JULY 1981 SHEET 8 OF 27 SHEETS FILE NO. ER3:02-5

State Proj. No. 204-107-01 Sheet No. of Sheets

DRAWING NUMBER

DRAWING NUMBER

DRAWING NUMBER

DRAWING NUMBER SCHOO.81 8

60