Fed. Proj. No.

INDEPENDENT SCHOOL DISTRICT NO. 278

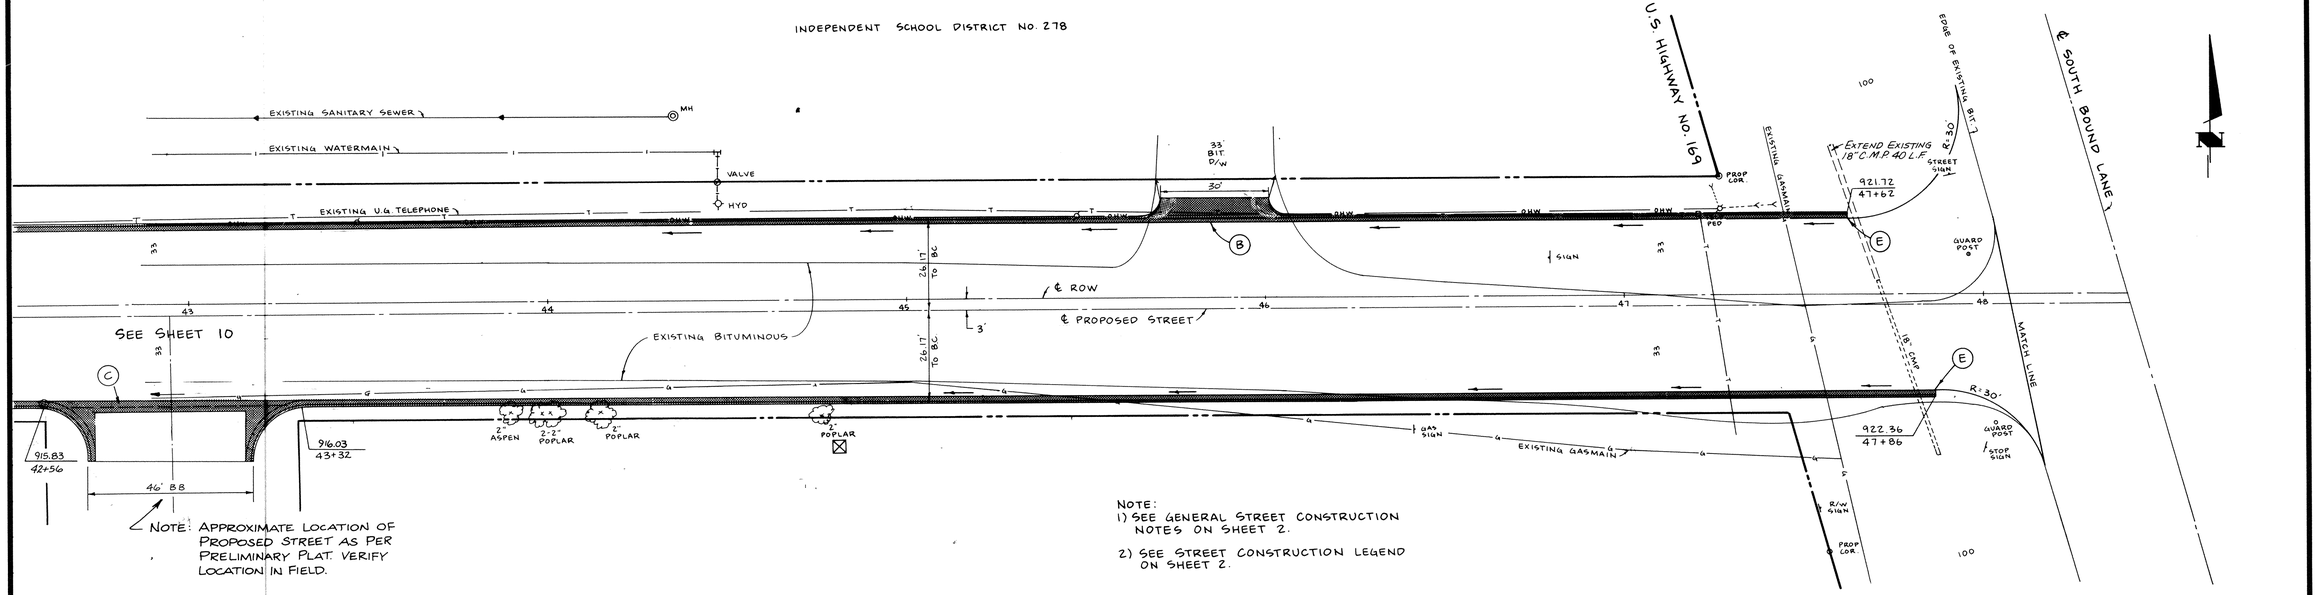

AS-BUILT
DRAWN BY: MRF Date 11-22-82
CHECKED BY:
INSPECTOR BC Date
DESIGN ENGR TA Date 7/6/83
PARTY CHIEF SS Date

I hereby certify that this plan, specification or report was prepared by me or under my direct supervision and that I am a duly Registered Professional Engineer under State of Minn. Statutes Sections 326.02 to 326.16.
Date 8/30/83 Minn. Reg. No. 10206

consulting engineers diversified inc.
civil municipal planning environmental land surveying geotechnics
p o box 1 osseo minnesota 55369 • (612)425-2181

REVISIONS

GRAPHIC SCALE 0 HORIZ 20 1 0 VERT 5 1

DESIGNED BY TAK TJM
CHECKED BY PRR
DRAWN BY TAK

CITY OF ELK RIVER
SCHOOL ST. N.W. IMPROVEMENT PROJECT
STREET CONSTRUCTION
43+00 TO U.S. HIGHWAY NO. 169

BK LOOSE LEAF | DATE JULY 1981 | SHEET 11 OF 27 SHEETS | FILE NO ER3:02-5

State Proj. No. 204-107-01 **Sheet No. of Sheets**

DRAWING NUMBER
GUTTER PRODUCTS • NEW HOPE, MINNESOTA
REORDER BY PART NUMBER 6503

DRAWING NUMBER
SCHOO.81
11
GUTTER PRODUCTS • NEW HOPE, MINNESOTA
REORDER BY PART NUMBER 6503