Fed. Proj. No.

INDEPENDENT SCHOOL DISTRICT NO 278

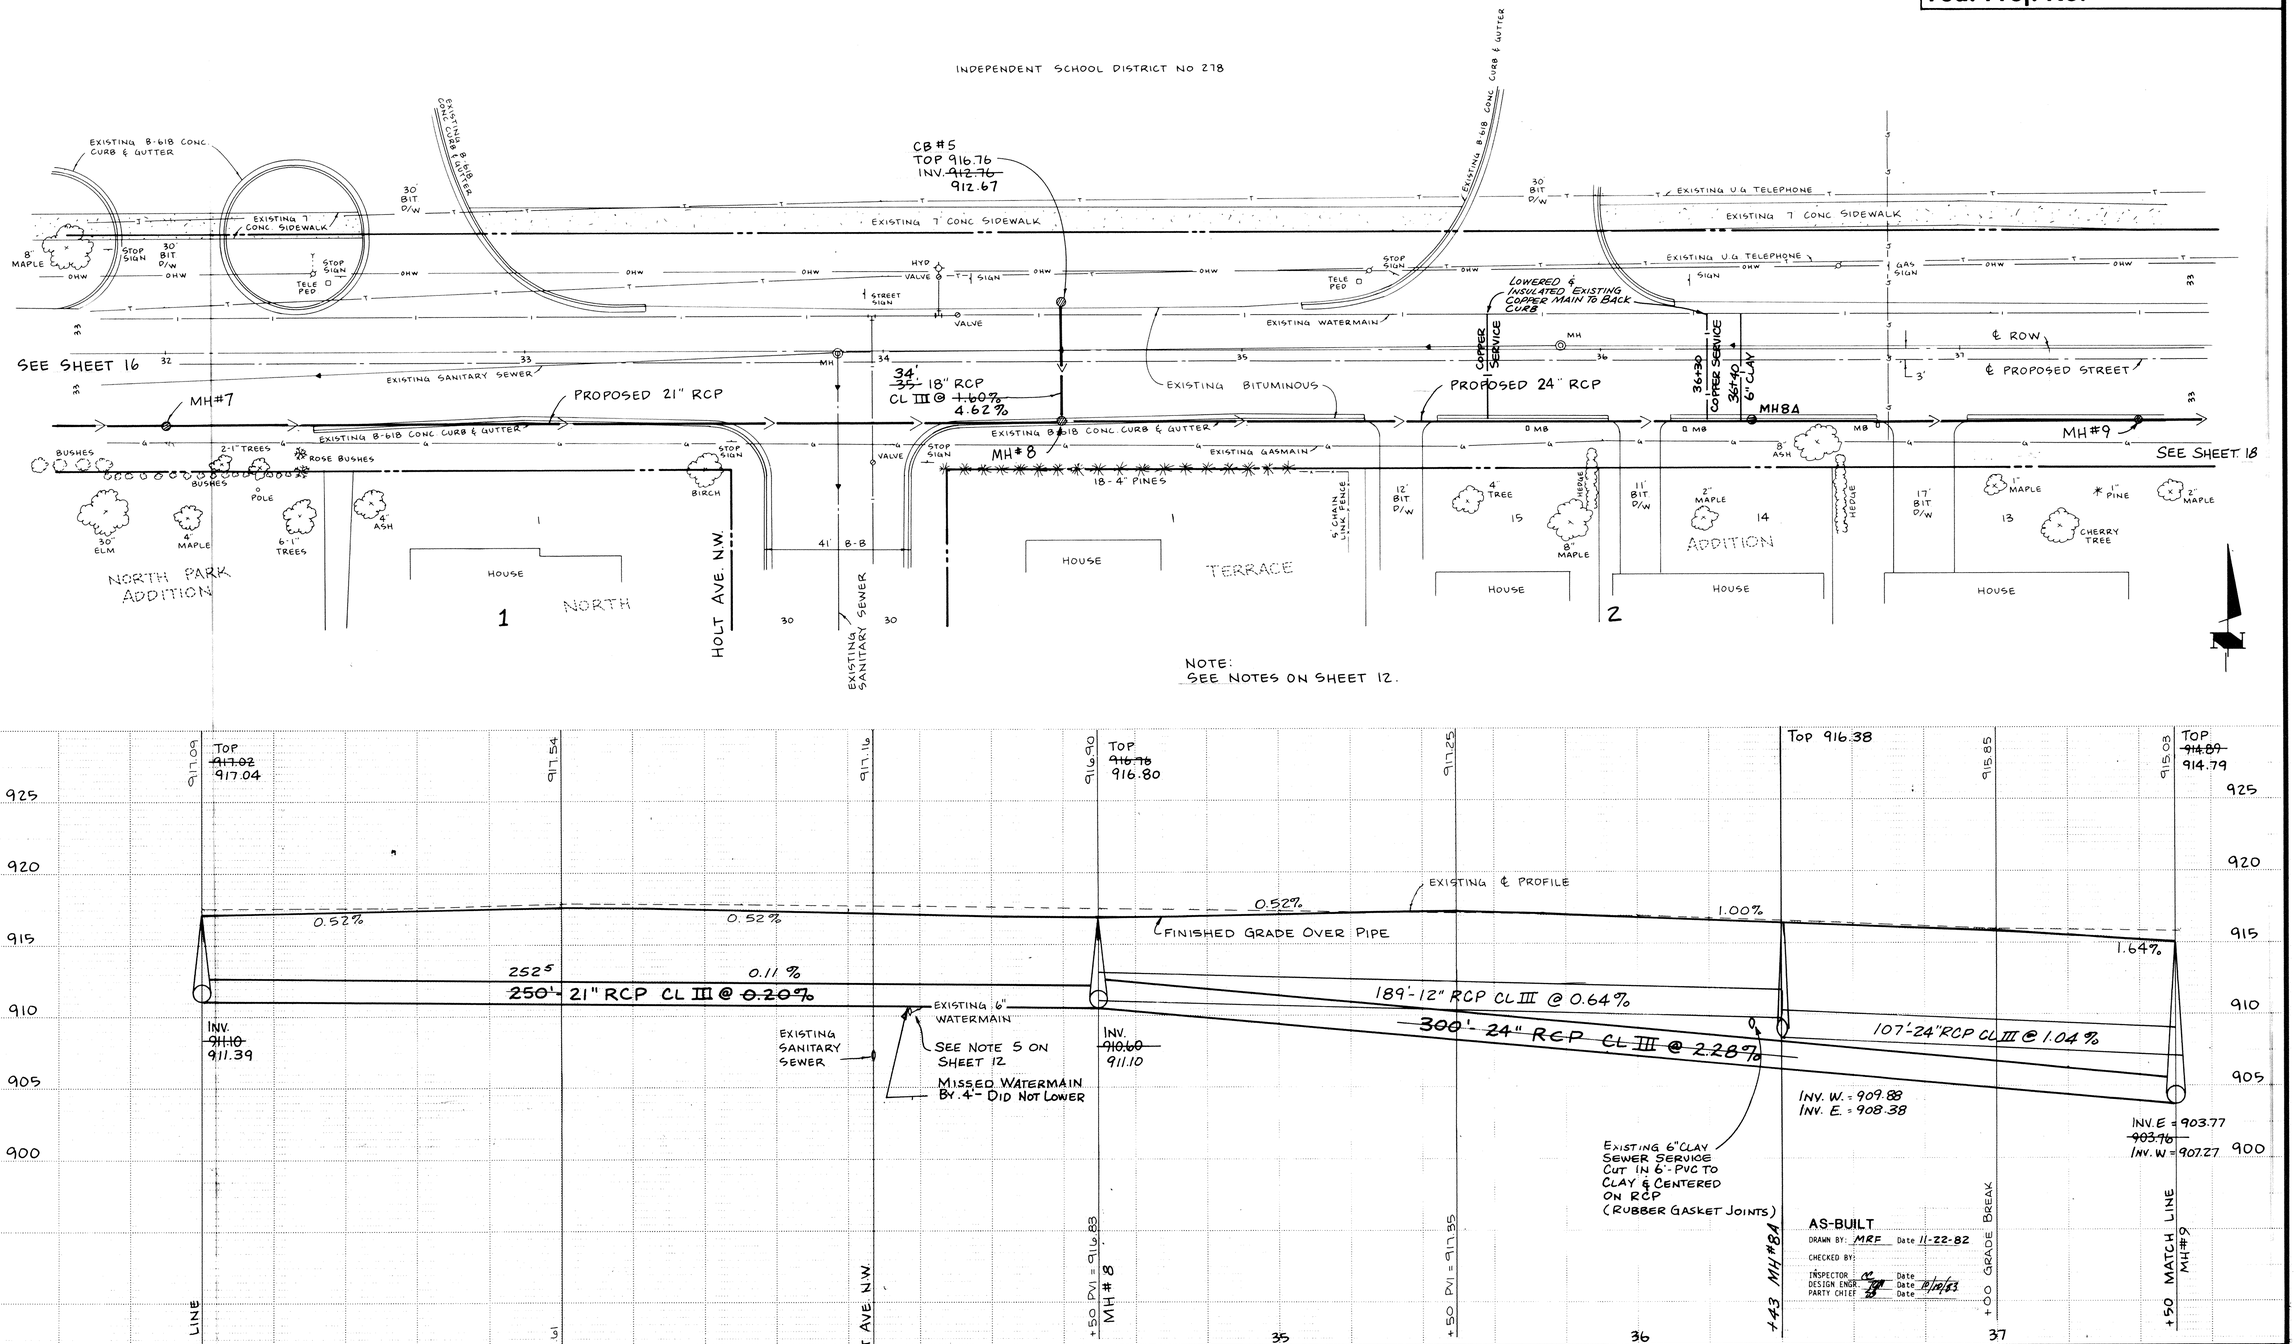

NOTE:
SEE NOTES ON SHEET 12.

I hereby certify that this plan, specification or report was prepared by me or under my direct supervision and that I am a duly registered Professional Engineer under the laws of Minnesota. Statutes Section 326.02 to 326.15
Date 8/28/81 Minn. Reg. No. 10806

consulting engineers diversified inc.
municipal planning environmental land surveying geotechnics
P.O. Box 1 Ossseo Minnesota 55369 • 473-1424

REVISIONS	DESIGNED BY	CITY OF ELK RIVER
	TAK TJM	SCHOOL ST. N.W. IMPROVEMENT PROJECT
GRAPHIC SCALE	CHECKED BY	STORM SEWER
HORIZ 20	PRR	32+00 TO 37+50
VERT 5	DRAWN BY TAK	BK LOOSE PG LEAF · DATE JULY 1981 · SHEET 17 OF 27 SHEETS · FILE NO ER3:02-5

State Proj. No. 204-107-01 Sheet No. of Sheets

DRAWING NUMBER
SHOWN SHADED ON PLATE • VERIFY WITH MARKINGS
REORDER BY PART NUMBER 6506

DRAWING NUMBER
SCHOOL 81
17
SHOWN SHADED ON PLATE • VERIFY WITH MARKINGS
REORDER BY PART NUMBER 6506