INDEPENDENT SCHOOL DISTRICT NO 278

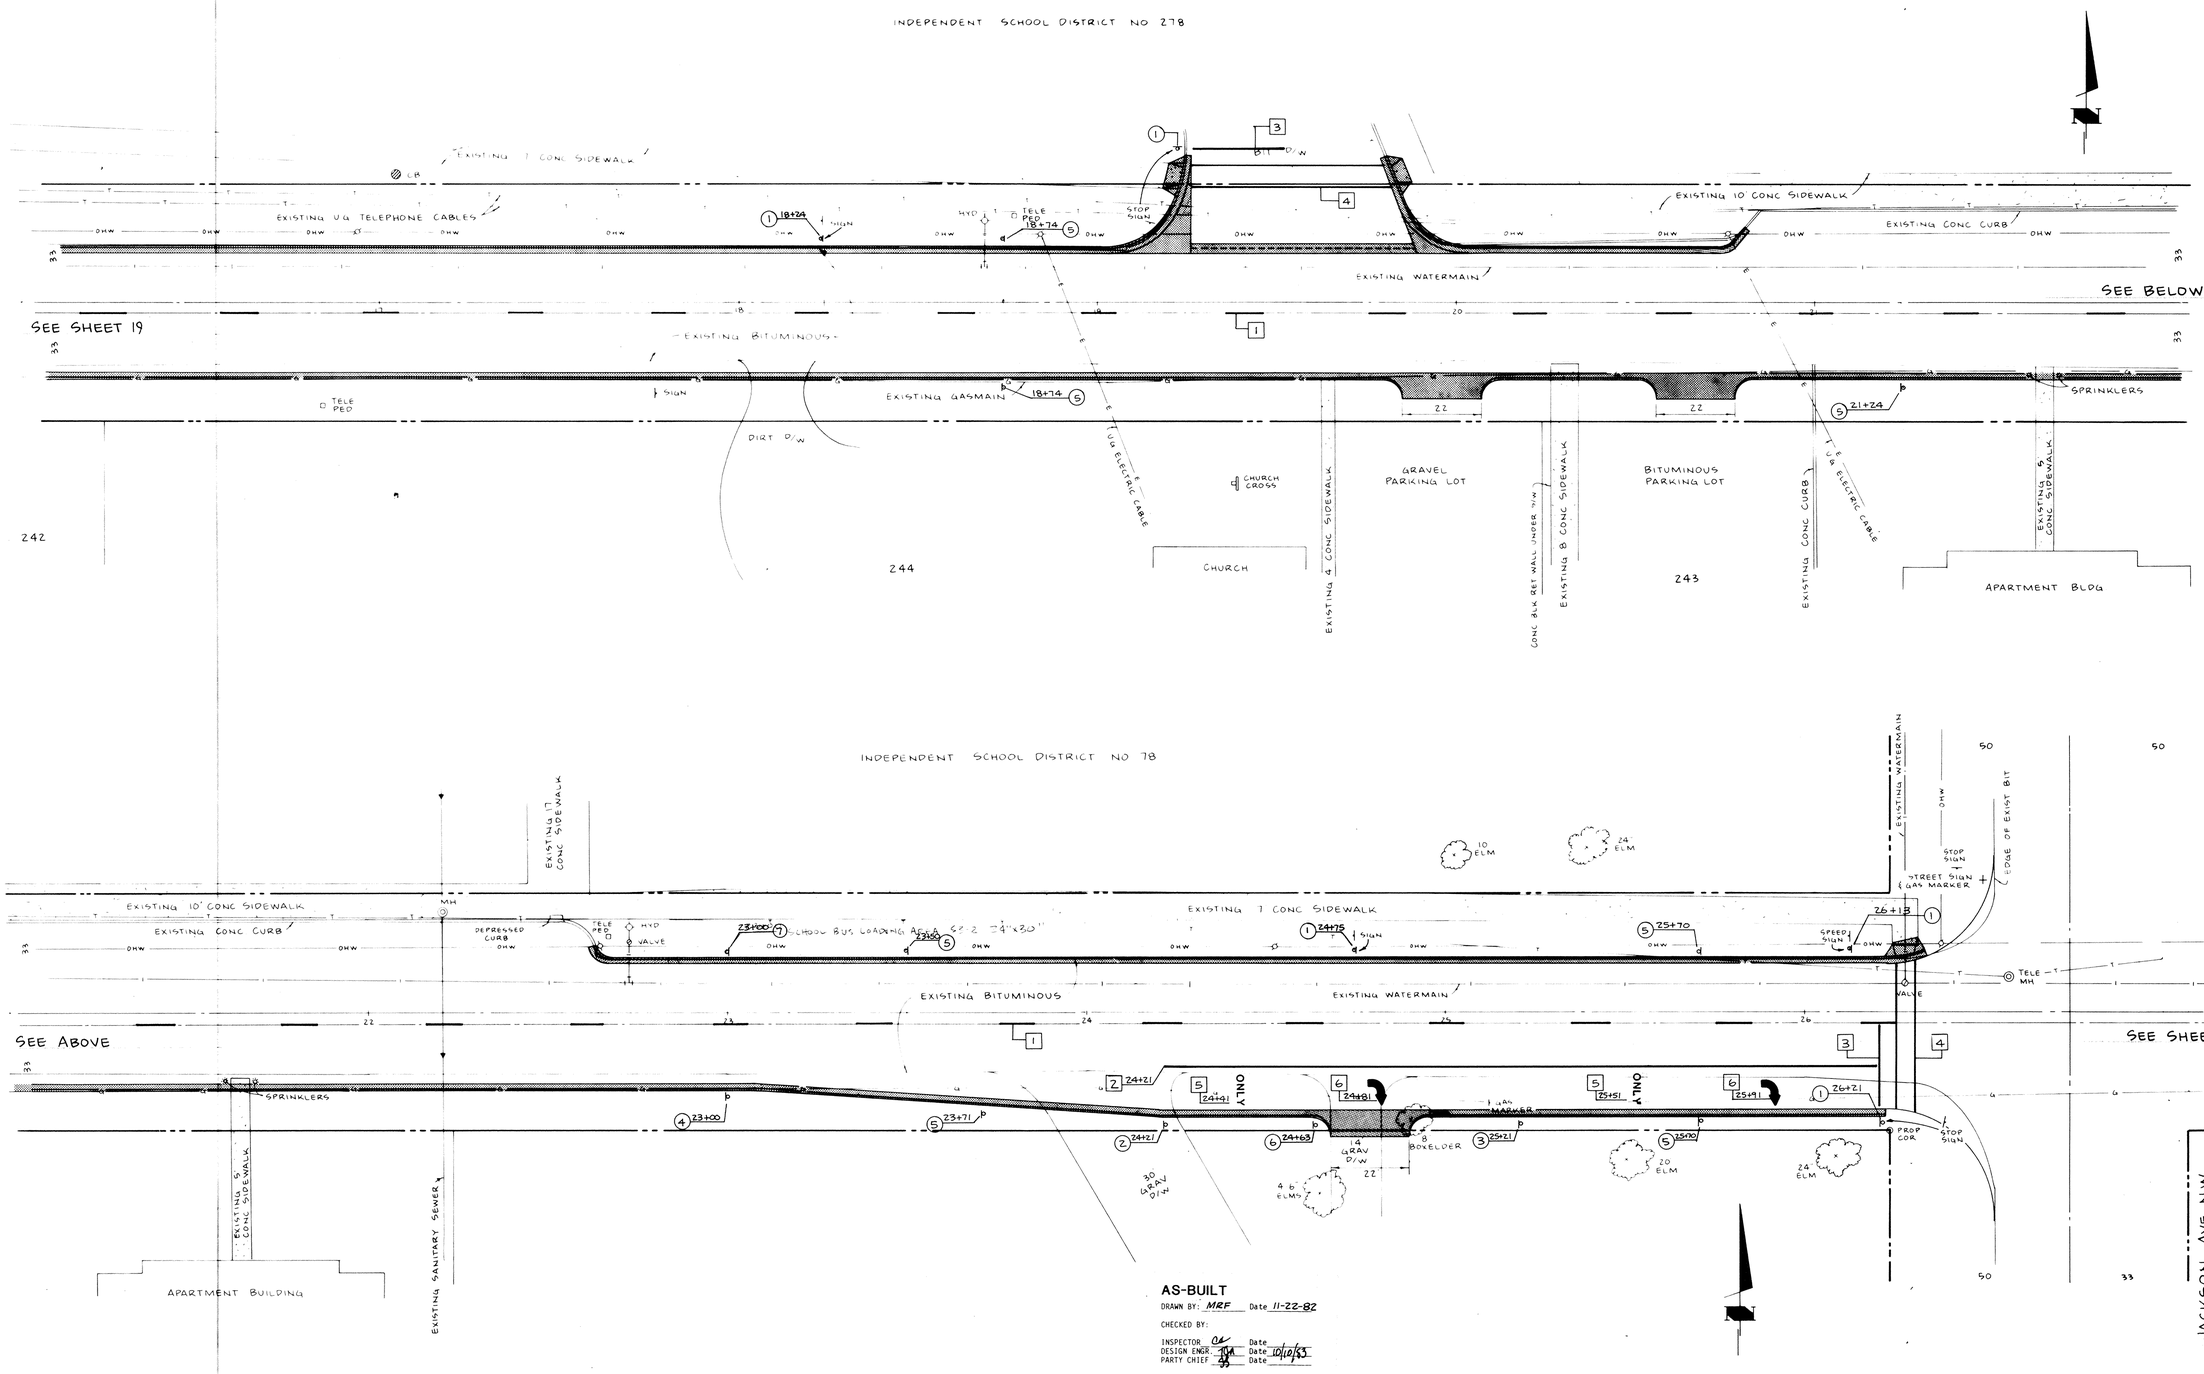

INDEPENDENT SCHOOL DISTRICT NO 78

AS-BUILT

DRAWN BY: MRF Date 11-22-82

CHECKED BY:

INSPECTOR OK Date
DESIGN ENGR. TJM Date 10/10/83
PARTY CHIEF JS Date

S.A.P. # 204-107-01

I hereby certify that this plan, specification or report was prepared by me or under my direct supervision and that I am a duly Registered Professional Engineer under the State of Minn. Statutes Sections 326.02 to 326.16.

Date 8/26/83 Minn. Reg. No. 10206

consulting engineers diversified inc.
civil, municipal, planning, environmental, land surveying, geotechnics
p.o. box | osseo minnesota 55369 • 612-424-2181

REVISIONS

GRAPHIC SCALE 0 20 HORIZ. 0 VERT. 0

DESIGNED BY TJM
CHECKED BY PRR
DRAWN BY MRF

CITY OF ELK RIVER
SCHOOL ST. NW IMPROVEMENT PROJECT
SIGNING & PAVEMENT MARKING
16+50 TO JACKSON AVE. NW

BK ____ PG ____ DATE Aug 1981 SHEET 21 OF 27 SHEETS FILE NO. ER 3:02-5

DRAWING NUMBER
SAFCO PRODUCTS • NEW HOPE, MINNESOTA
REORDER BY PART NUMBER 83053

DRAWING NUMBER
SCHOOL 81
21
SAFCO PRODUCTS • NEW HOPE, MINNESOTA
REORDER BY PART NUMBER 83053