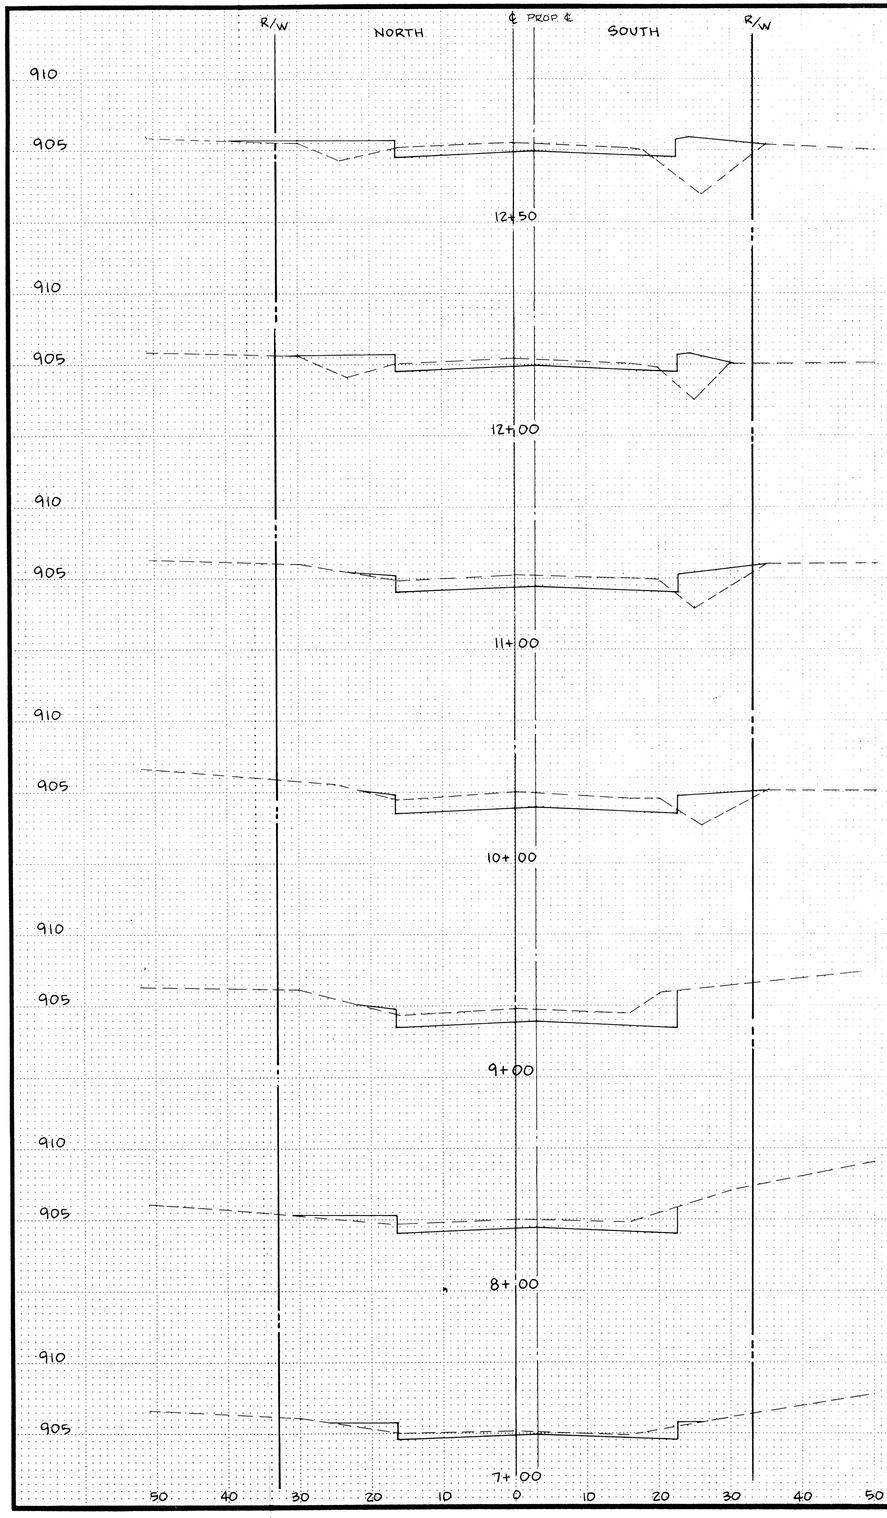

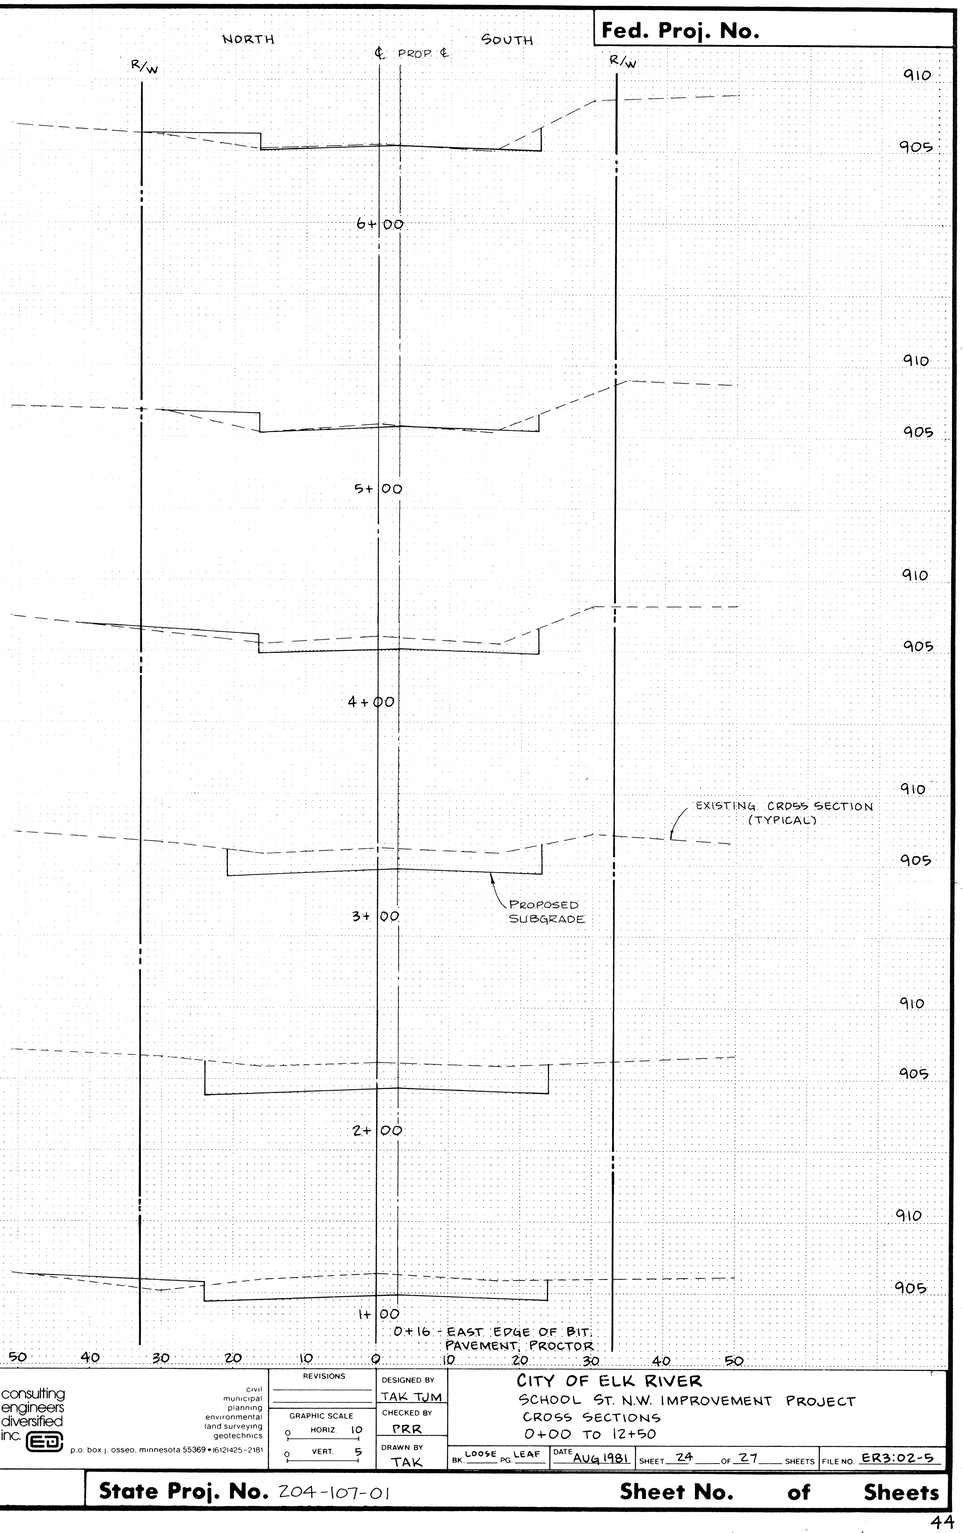

Fed. Proj. No.

AS-BUILT
DRAWN BY: MRF Date: 11-22-82
CHECKED BY:
INSPECTOR Date
DESIGN ENGR. Date 12/10/83
PARTY CHIEF Date

S.A.P. # 204-107-01

I hereby certify that this plan, specification or report was prepared by me or under my direct supervision and that I am a duly Registered Professional Engineer under State of Minn. Statutes Sections 326.02 to 326.16.
Date 8/28/81 Minn. Reg. No. 10206

consulting engineers diversified inc.
civil
municipal
planning
environmental
land surveying
geotechnics
p.o. box j. osseo, minnesota 55369 • (612)425-2181

REVISIONS

GRAPHIC SCALE
HORIZ. 10
VERT. 5

DESIGNED BY TAK TJM
CHECKED BY PRR
DRAWN BY TAK

CITY OF ELK RIVER
SCHOOL ST. N.W. IMPROVEMENT PROJECT
CROSS SECTIONS
0+00 TO 12+50

BK LOOSE PG. LEAF | DATE AUG 1981 | SHEET 24 OF 27 SHEETS | FILE NO. ER3:02-5

State Proj. No. 204-107-01 **Sheet No. of Sheets**

DRAWING NUMBER

DRAWING NUMBER
SCHOO.81
24

DAFCO PRODUCTS • NEW HOPE, MINNESOTA
REORDER BY PART NUMBER 60053