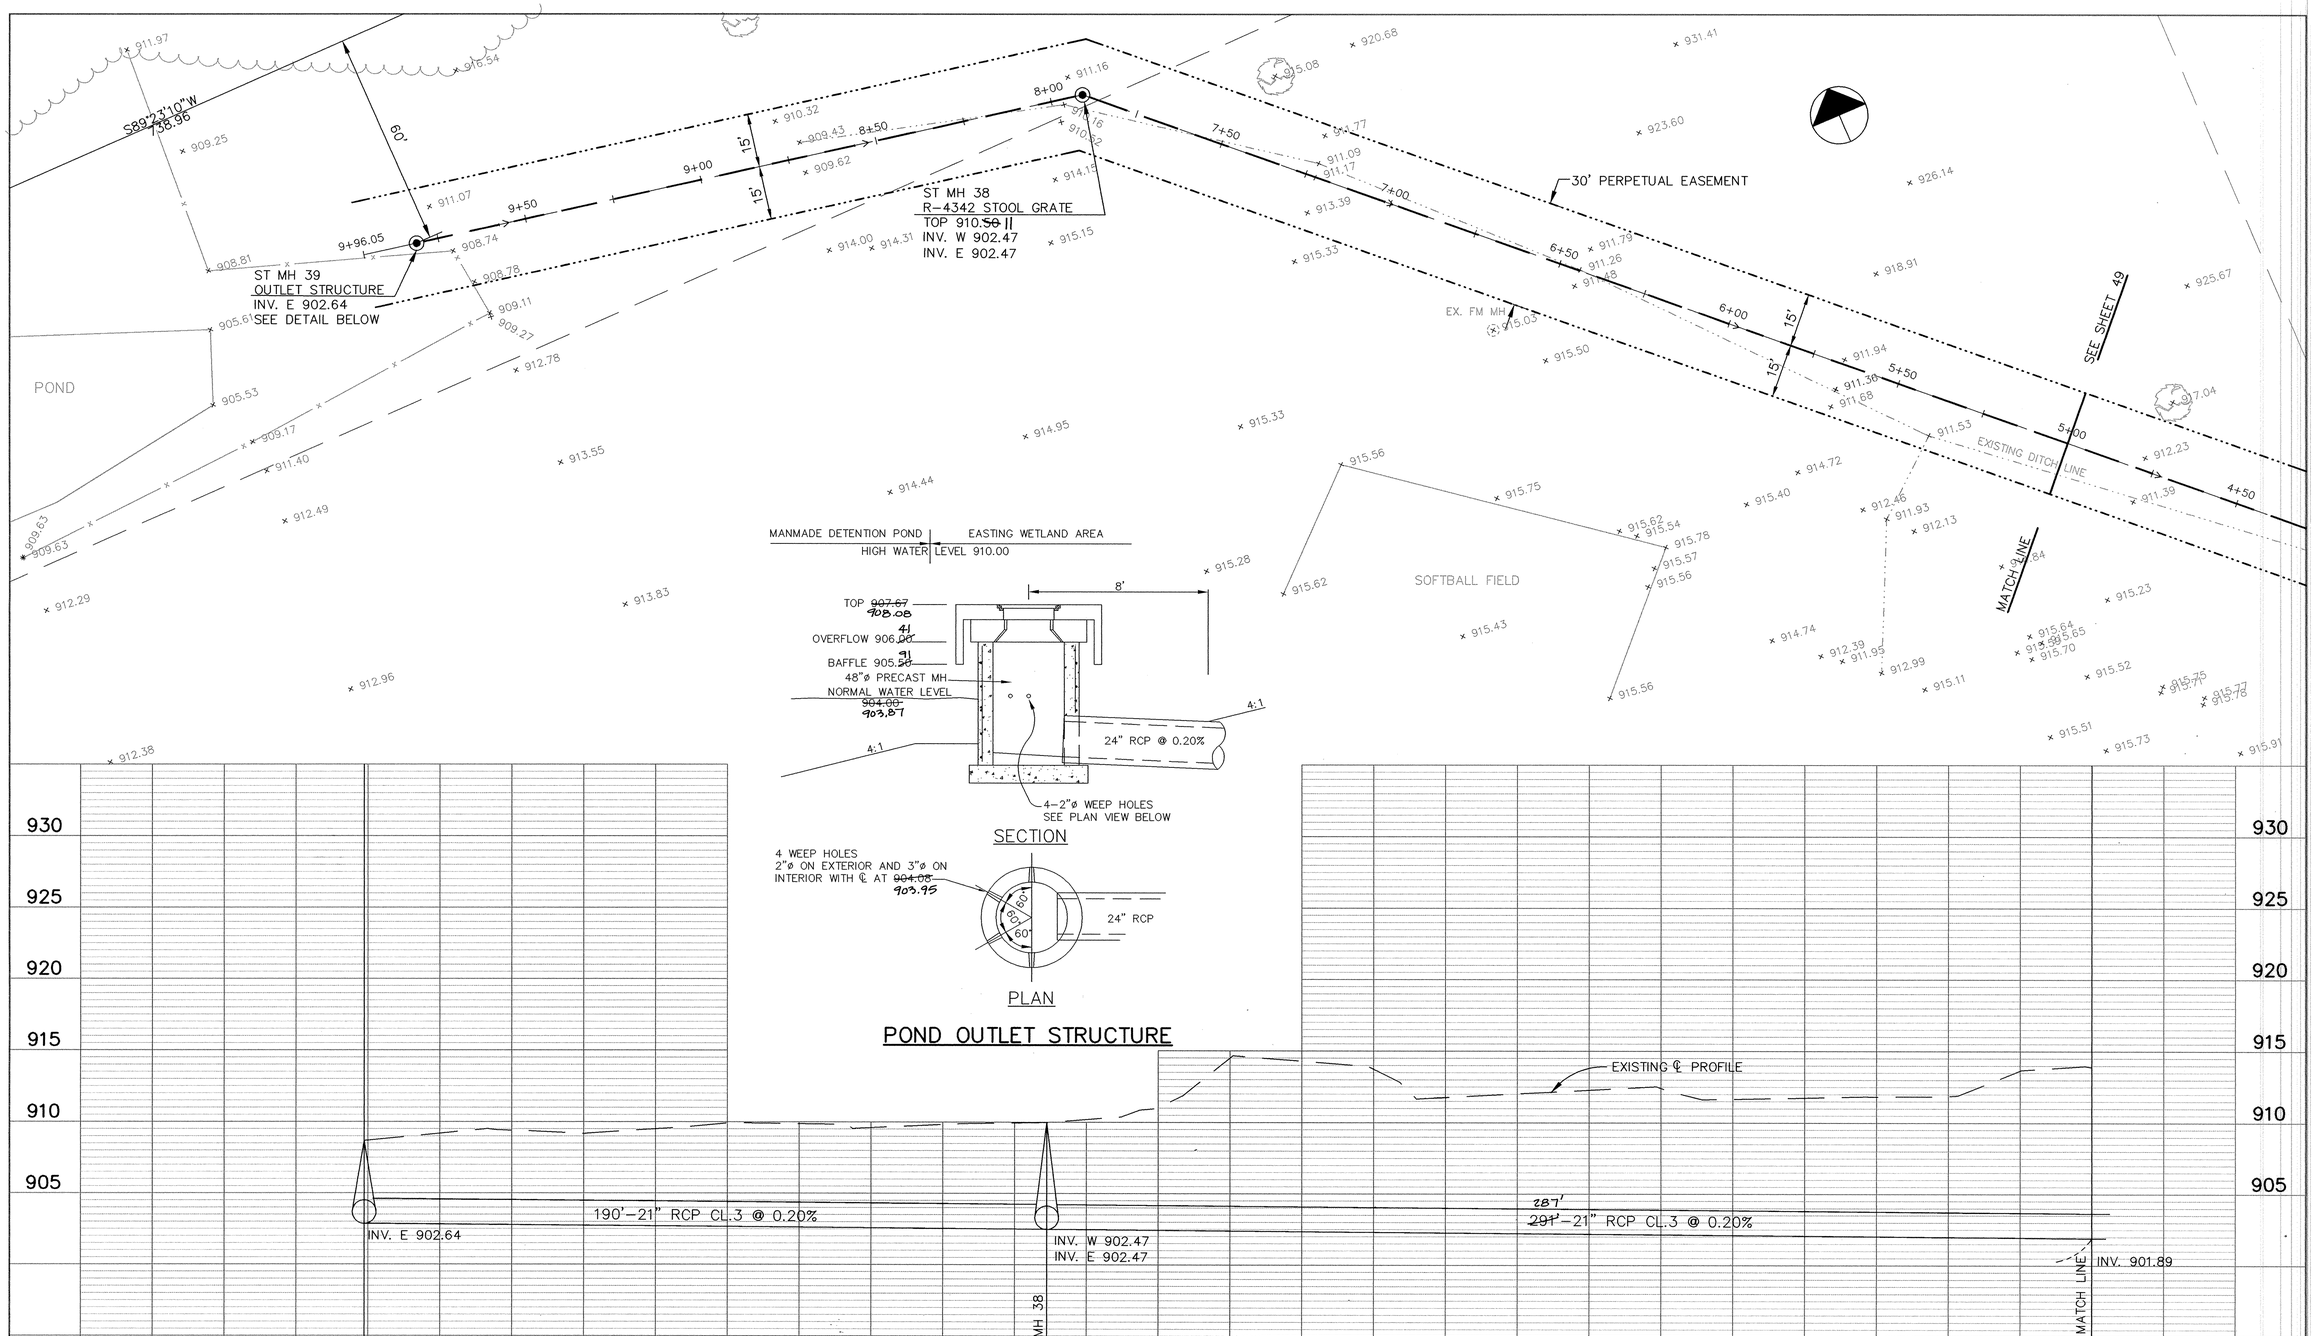

I HEREBY CERTIFY THAT THIS PLAN, SPECIFICATION, OR REPORT WAS PREPARED BY ME OR UNDER MY DIRECT SUPERVISION AND THAT I AM A DULY REGISTERED PROFESSIONAL ENGINEER UNDER THE LAWS OF THE STATE OF MINNESOTA.

Paul Boettcher

DATE 4-29-94 REG.NO. 13929

MSA CONSULTING ENGINEERS

1326 ENERGY PARK DRIVE
ST. PAUL, MINNESOTA 55108
(612) 644-4389

9800 SHELARD PARKWAY
MINNEAPOLIS, MINNESOTA 55441
(612) 546-0432

REVISIONS

DATE	DESCRIPTION

DESIGNED PEB
CHECKED PB
DRAWN JM

GRAPHIC SCALE
0 HORIZ. 20
0 VERT. 5

CITY OF ELK RIVER
DETENTION POND STORM SEWER
OUTLET TO FREEPORT AVENUE

5+00 TO 9+81

DATE APRIL 1994 | SHEET 50 OF 74 SHEETS | PROJECT NO. 230-217

ER217-T1

795

DRAWING NUMBER

DRAWING NUMBER

DRAWING NUMBER

DRAWING NUMBER
SCHOO.95
50

Sun May 1 09:53:01 1994