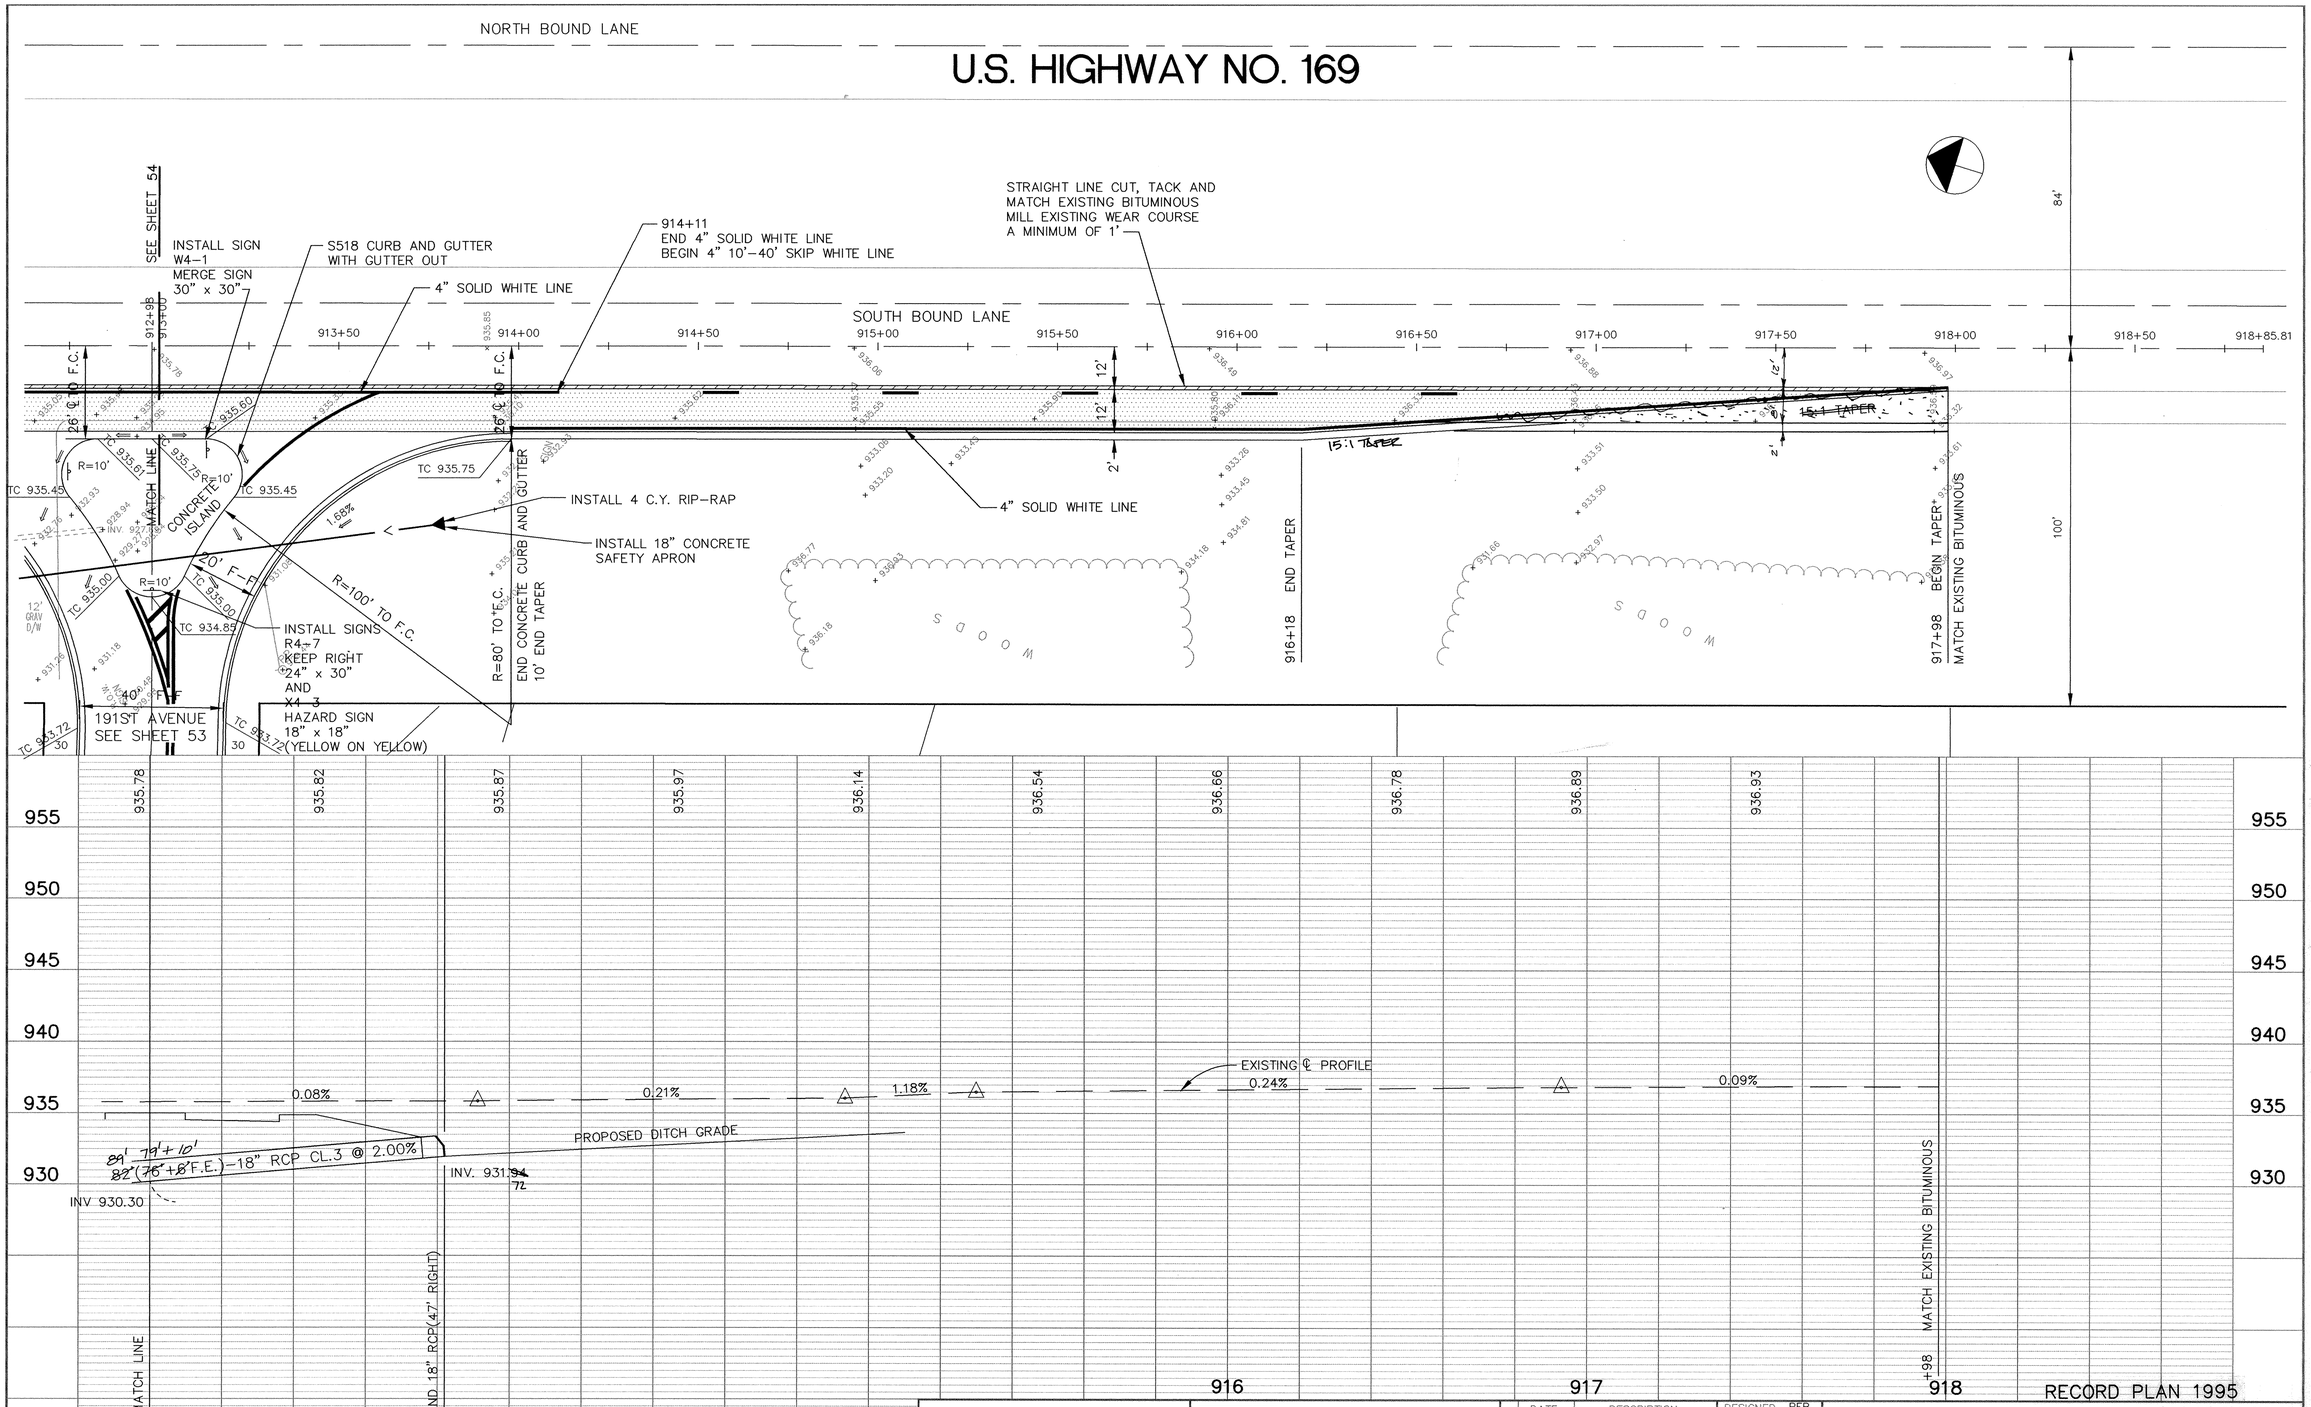

RECORD PLAN 1995

I HEREBY CERTIFY THAT THIS PLAN, SPECIFICATION, OR REPORT WAS PREPARED BY ME OR UNDER MY DIRECT SUPERVISION AND THAT I AM A DULY REGISTERED PROFESSIONAL ENGINEER UNDER THE LAWS OF THE STATE OF MINNESOTA.

Paul Boettcher

DATE 4-29-94 REG.NO. 13929

MSA CONSULTING ENGINEERS

1326 ENERGY PARK DRIVE
ST. PAUL, MINNESOTA 55108
(612) 644-4389

9800 SHELARD PARKWAY
MINNEAPOLIS, MINNESOTA 55441
(612) 546-0432

REVISIONS

DATE	DESCRIPTION

DESIGNED PEB
CHECKED PB
DRAWN CLS
GRAPHIC SCALE
0 HORIZ. 20
0 VERT. 5

CITY OF ELK RIVER
U.S. HWY NO. 169 AND 191ST AVENUE
RIGHT IN/RIGHT OUT

S.A.P. NO. 204-010-02
STA. 913+00 TO 917+98

DATE APRIL 1994 | SHEET 55 OF 74 SHEETS | PROJECT NO. 230-217

DRAWING NUMBER
SCHOO.95
55

Thu Apr 28 04:33:20 1994

790