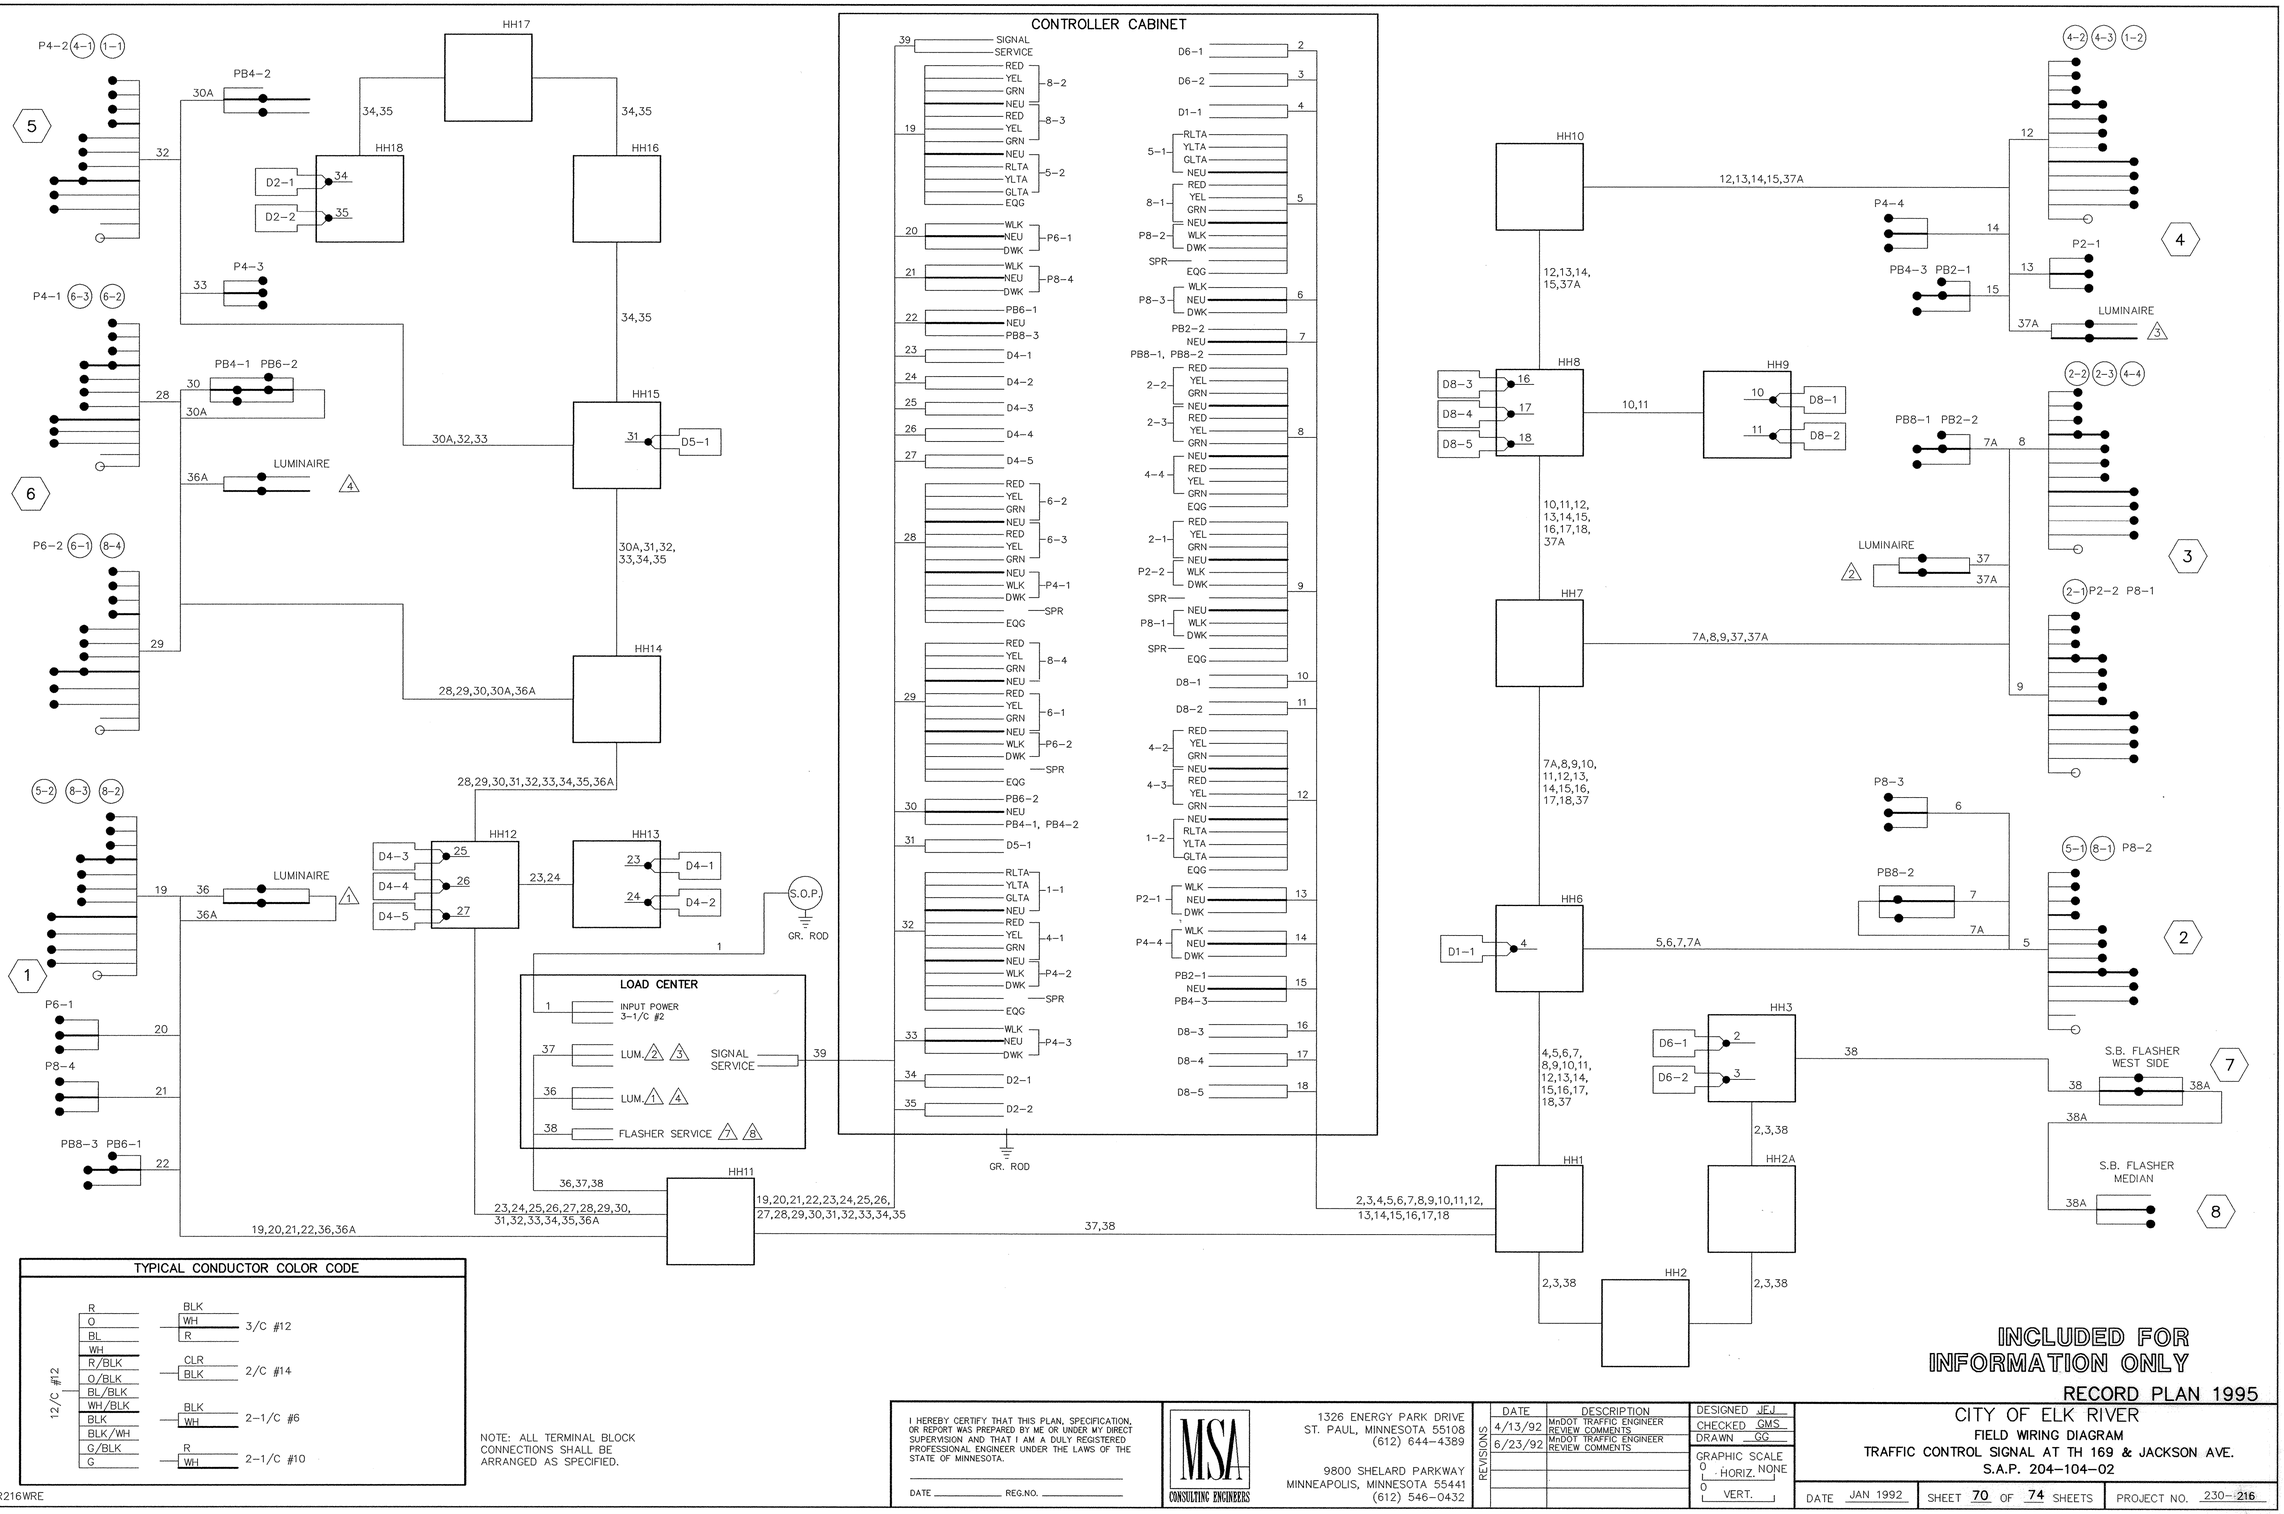

I HEREBY CERTIFY THAT THIS PLAN, SPECIFICATION, OR REPORT WAS PREPARED BY ME OR UNDER MY DIRECT SUPERVISION AND THAT I AM A DULY REGISTERED PROFESSIONAL ENGINEER UNDER THE LAWS OF THE STATE OF MINNESOTA.

DATE _____ REG.NO. _____

MSA CONSULTING ENGINEERS

1326 ENERGY PARK DRIVE
ST. PAUL, MINNESOTA 55108
(612) 644-4389

9800 SHELARD PARKWAY
MINNEAPOLIS, MINNESOTA 55441
(612) 546-0432

REVISIONS	DATE	DESCRIPTION
	4/13/92	MnDOT TRAFFIC ENGINEER REVIEW COMMENTS
	6/23/92	MnDOT TRAFFIC ENGINEER REVIEW COMMENTS

DESIGNED JEJ
CHECKED GMS
DRAWN GG
GRAPHIC SCALE
0 HORIZ. NONE
0 VERT.

CITY OF ELK RIVER

FIELD WIRING DIAGRAM

TRAFFIC CONTROL SIGNAL AT TH 169 & JACKSON AVE.

S.A.P. 204-104-02

DATE JAN 1992 | SHEET 70 OF 74 SHEETS | PROJECT NO. 230-216

775

DRAWING NUMBER SCHOO.95 70

DRAWING NUMBER

SAFCO PRODUCTS • NEW HOPE, MINNESOTA
REORDER BY PART NUMBER 6936

Mon Apr 11 17:27:32 1994