© 2002 Westwood Professional Services, Inc.

Call 48 Hours before digging:
GOPHER STATE ONE CALL
Twin City Area 651-454-0002
Mn. Toll Free 1-800-252-1166

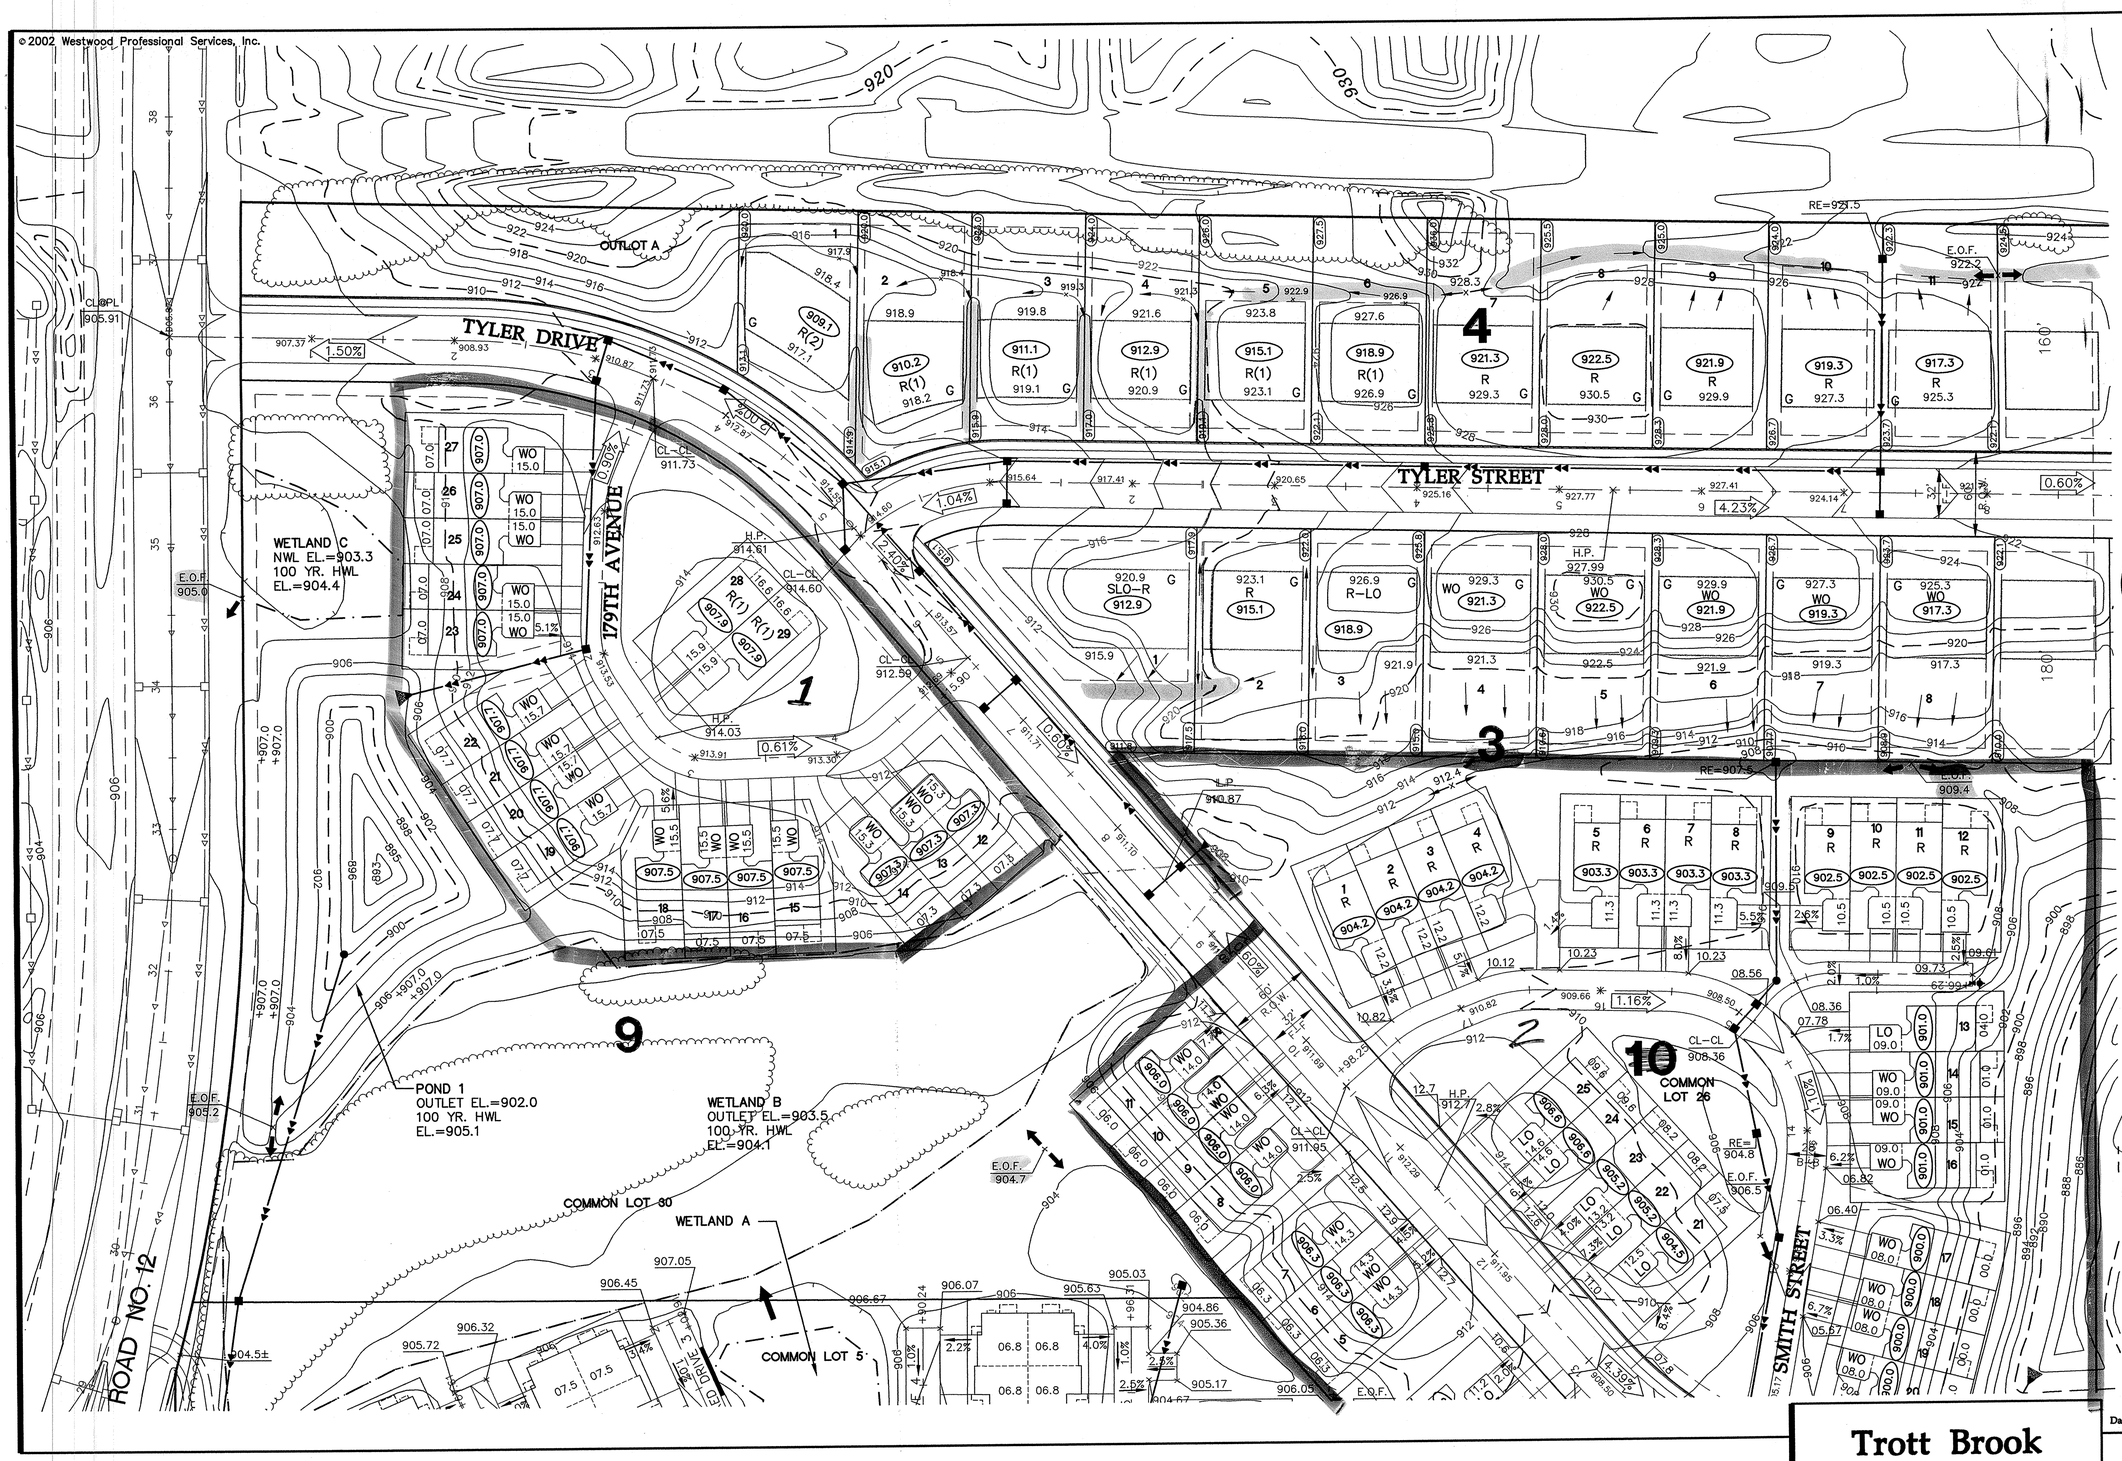

AREA IN TROTT BROOK FARMS SOUTH 2ND ADD

APPROVED
12/6/02 Final SKP
Howard R. Green Co.

(PREVIOUS PLAN WAS APPROVED ON 8/29/01)

= CRITICAL SWALES OR GRADES

0' 50' 100' 150'

LATEST REVISION DATE: 12/01/02
E-3 20011034 20011034DEV2.DWG

Date: 04/01/02 Sheet: 2 OF 3

Trott Brook Farms South

Elk River, Minnesota

Development Plan

Westwood Professional Services, Inc.
7599 Anagram Drive
Eden Prairie, MN 55344
Phone: 952/937-5150 Fax: 952/937-5822

I hereby certify that this plan was prepared by me or under my direct supervision and that I am a duly licensed PROFESSIONAL ENGINEER under the laws of the State of Minnesota.

Francis D. Hagen, II
Date: 12/01/02 License No. 17716

Revisions:
06/25/02 Contour Changes–RNS
07/16/02 City Review–RNS
08/19/02 City Review–CLJ
12/01/02 180th Street Area – JMM

Designed: FDH, II
Checked: FDH, II
Drawn: WH/RNS
Record Drawing by/date:

Prepared for:

D.R. Horton, Inc.
20860 Kenbridge Ct., Suite 100
Lakeville, Minnesota 55044