©2002 Westwood Professional Services, Inc.

Construction Plans

for

Sanitary Sewer, Water Main, Storm Sewer and Streets

for

Trott Brook Crossing -Phase One

Elk River, Minnesota

VICINITY MAP:

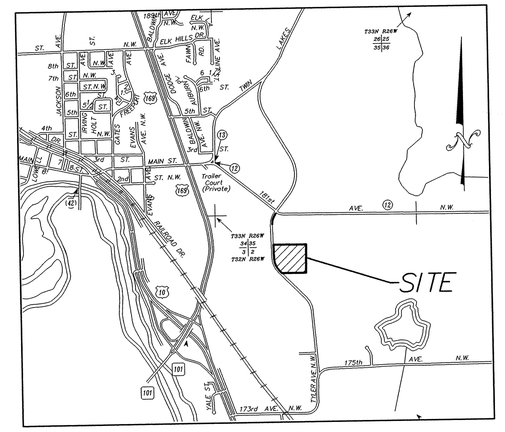

ELK RIVER
No Scale

Prepared for:

Foray Real Estate & Construction
9350 County Road 19
Corcoran, Minnesota 55357
Contact: John Stainbrook
Phone: 763-498-7228
Fax: 763-498-8521

Prepared by:

Westwood Professional Services, Inc.
7599 Anagram Drive
Eden Prairie, MN 55344
Phone: 952/937-5150 Fax: 952/937-5822

Project Number: 20011101
Contact: Jason McCarty

NO.	DATE	REVISION	SHEETS
1	07/22/02	CITY REVIEW	ALL
2	08/08/02	VILLA GATE VALVES ADDED	ALL
3	09/18/02	TYLER STREET WATER MAIN SIZE	1,5
4	01/21/05	RECORD DRAWINGS	ALL

INDEX

SHEET NO.	DESCRIPTION
1	COVER
2	OVERALL PLAN
3	SANITARY SEWER & WATER MAIN – 178th AVENUE
4	SANITARY SEWER & WATER MAIN – TYLER DRIVE
5	SANITARY SEWER & WATER MAIN – TYLER STREET (STA. 9+00 to STA. 16+50)
~~6~~	~~SANITARY SEWER & WATER MAIN – TYLER STREET (STA. 16+50 to STA. 25+58.84)~~ –PHASE 2
~~7~~	~~SANITARY SEWER & WATER MAIN – 177th CIRCLE~~ –PHASE 2
8	STORM SEWER & STREET CONST. – 178th AVENUE
9	STORM SEWER & STREET CONST. – TYLER DRIVE
10	STORM SEWER & STREET CONST. – TYLER STREET (STA. 9+00 to STA. 18+32.15)
~~11~~	~~STORM SEWER & STREET CONST. – TYLER STREET (STA. 18+32.15 to STA. 25+58.84)~~ –PHASE 2
~~12~~	~~STORM SEWER & STREET CONST. – 177th CIRCLE~~ –PHASE 2
13	STORM SEWER & STREET CONST. – REAR YARDS
14–18	DETAILS

CONTRACTOR: RYAN CONTRACTING CO.
RECORD DRAWING
CONFORMING TO CONSTRUCTION RECORDS.
BY AL SPILLES DATE 01/21/05
WESTWOOD PROFESSIONAL SERVICES

Construction Plans

for

Sanitary Sewer, Water Main, Storm Sewer and Streets

for

Trott Brook Crossing -Phase One
Elk River, Minnesota

Date: 06/14/02 Sheet: 1 of 18

E-3 20011101CV01.DWG

P:\20011101\dwg\RECORD\20011101CV01.dwg 01/14/2005 01:57:30 PM CST

DRAWING NUMBER

DRAWING NUMBER

DRAWING NUMBER

DRAWING NUMBER
TROTC1.02
1