©2002 Westwood Professional Services, Inc.

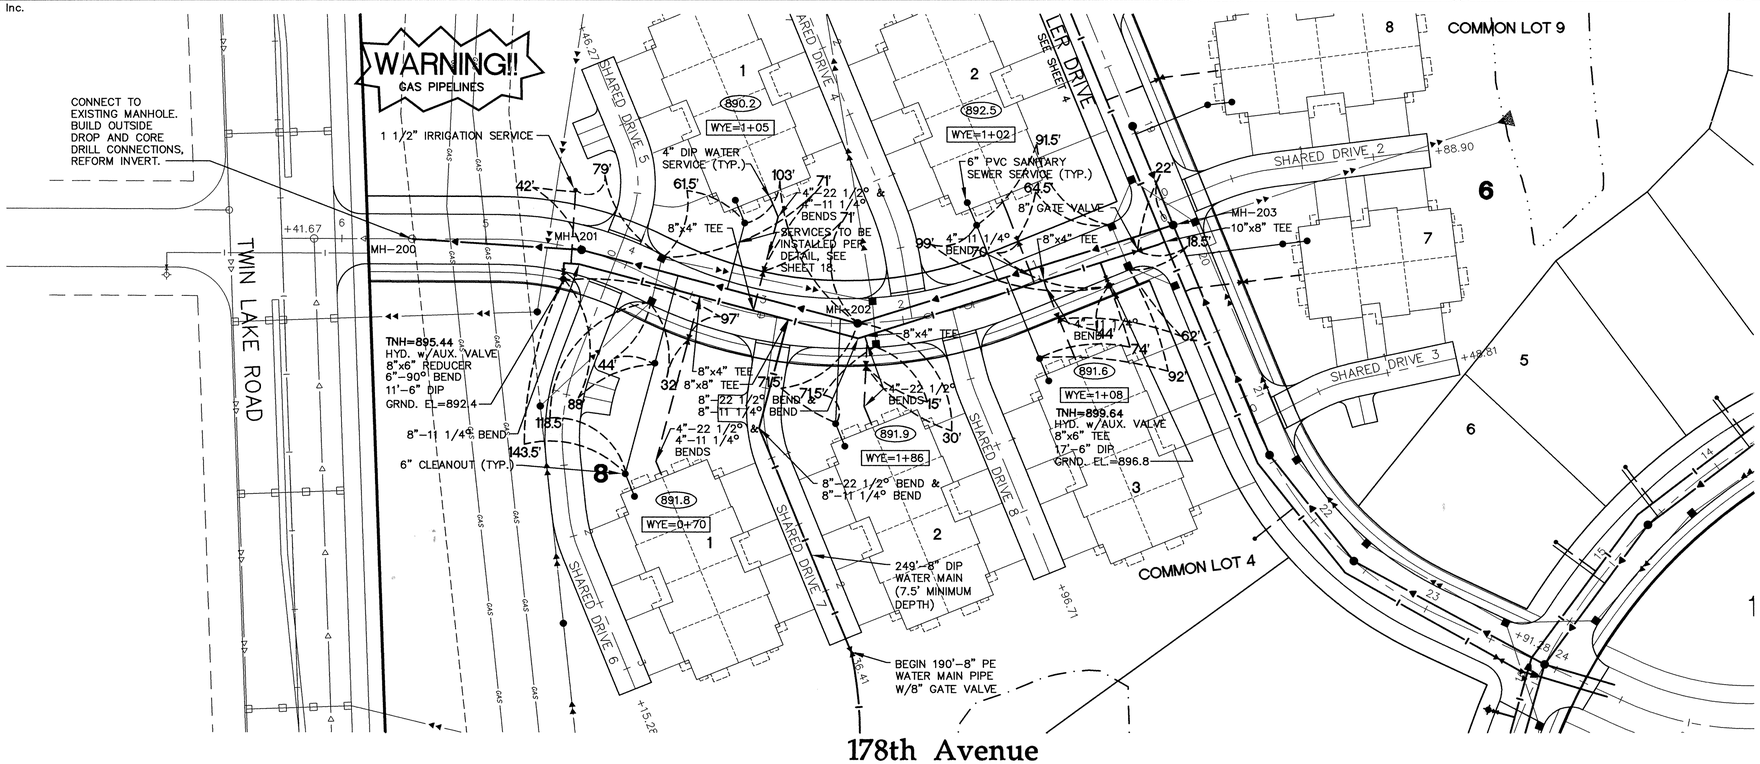

Call 48 Hours before digging:
GOPHER STATE ONE CALL
Twin City Area 651-454-0002
Mn. Toll Free 1-800-252-1166

GENERAL NOTES:

(XXX.X) DENOTES SANITARY SEWER SERVICE INVERT @ TOWNHOME PROPERTY LINE.

[WYE=X+XX] DENOTES SANITARY SEWER SERVICE WYE LOCATED ON MAINLINE FROM DOWN STREAM M.H.

FLAG HYDRANTS.

EXTEND RODS ON DEEP VALVES.

ALL DROP MANHOLES TO BE CONSTRUCTED USING OUTSIDE DROPS.

HYDRANTS TO BE PLACED 5' BEHIND CURB

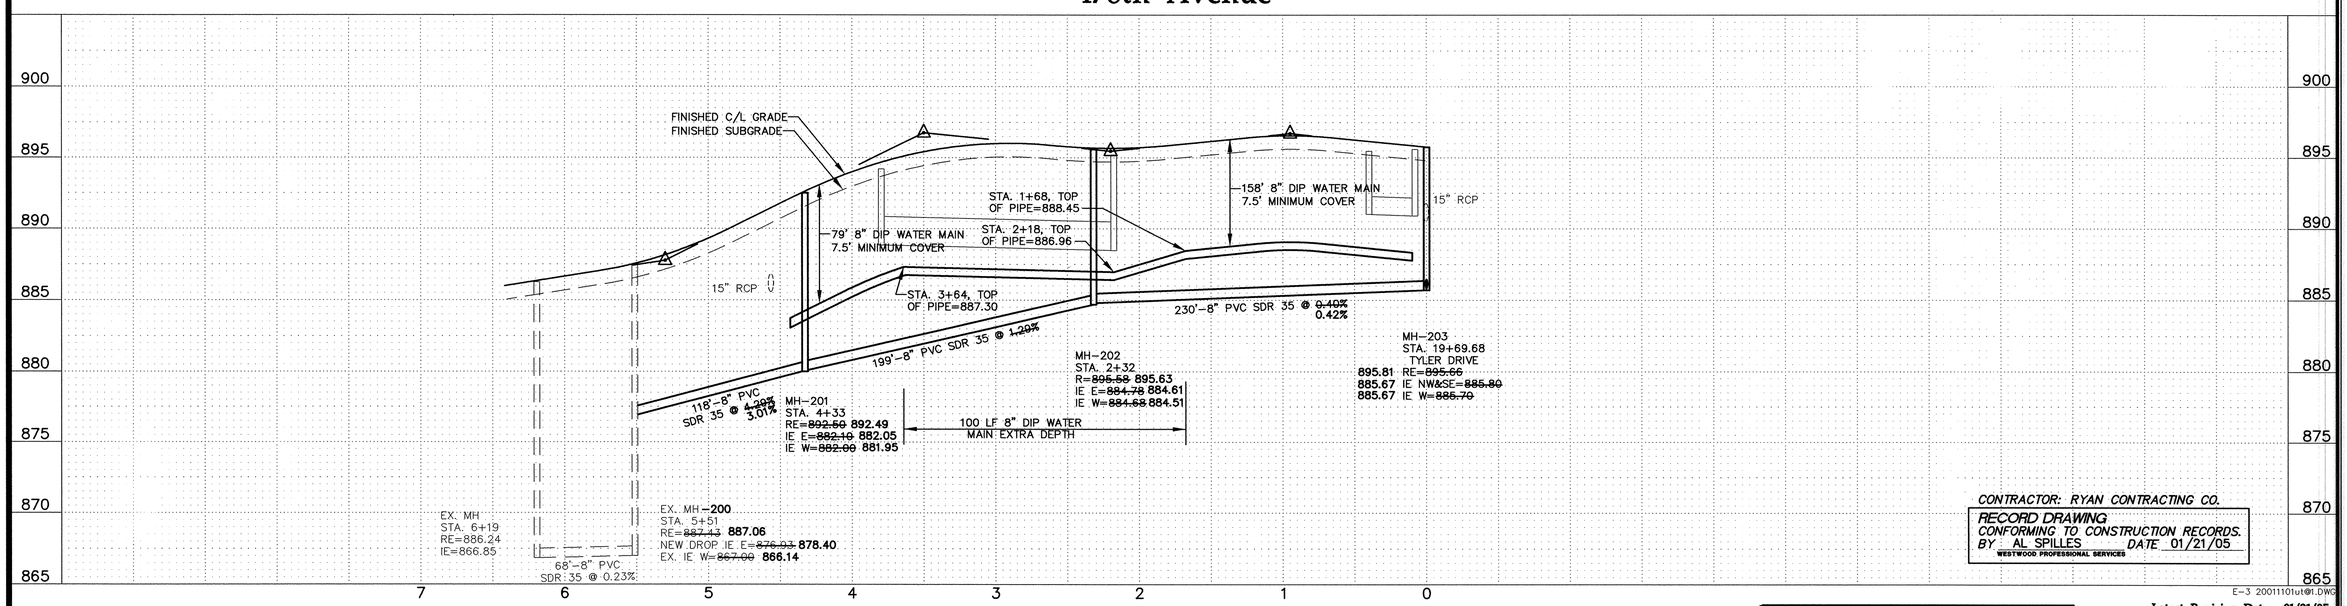

CONTRACTOR: RYAN CONTRACTING CO.
RECORD DRAWING
CONFORMING TO CONSTRUCTION RECORDS.
BY AL SPILLES DATE 01/21/05
WESTWOOD PROFESSIONAL SERVICES

E-3 20011101ut01.DWG

Latest Revision Date: 01/21/05
Date: 06/14/02 Sheet: 3 OF 18

Westwood Professional Services, Inc.
7599 Anagram Drive
Eden Prairie, MN 55344
Phone: 952/937-5150 Fax: 952/937-5822

I hereby certify that this plan was prepared by me or under my direct supervision and that I am a duly licensed PROFESSIONAL ENGINEER under the laws of the State of Minnesota.

Francis D Hagen, II
Date: 01/21/05 License No. 17716

Revisions:
07/22/02 City Review-RNS
08/08/02 Villa Gate Valves Added-RNS
01/21/05 RECORD DRAWING (AS/GKB)

Designed: JMM
Checked: FDH, II
Drawn: WH
Record Drawing by/date: AS 1/21/05

Prepared for:
Foray Real Estate & Construction
9350 County Road 19
Corcoran, Minnesota 55357

Trott Brook Crossing Phase One
Elk River, Minnesota

Sanitary Sewer and Water Main Construction Plans
178th Avenue

DRAWING NUMBER
TROTC1.02
3

P:\20011101\dwg\RECORD\20011101ut01.dwg 01/17/2005 07:44:38 AM CST