©1999 Westwood Professional Services, Inc.

Call 48 Hours before digging:
**GOPHER STATE ONE CALL**
Twin/City Area 651-454-0002
Mn./Toll Free 1-800-252-1166

## GENERAL NOTES:

(XXX.X) DENOTES SANITARY SEWER SERVICE INVERT @ ROW LINE. ALL SERVICES SHALL BE EXTENDED 9' INTO PROPERTY. WHERE SIDEWALK IS BEING CONSTRUCTED.

WYE=X+XX DENOTES SANITARY SEWER SERVICE WYE LOCATED ON MAINLINE FROM DOWN STREAM M.H.

FLAG HYDRANTS.

EXTEND RODS ON DEEP VALVES.

ALL DROP MANHOLES TO BE CONSTRUCTED USING OUTSIDE DROPS.

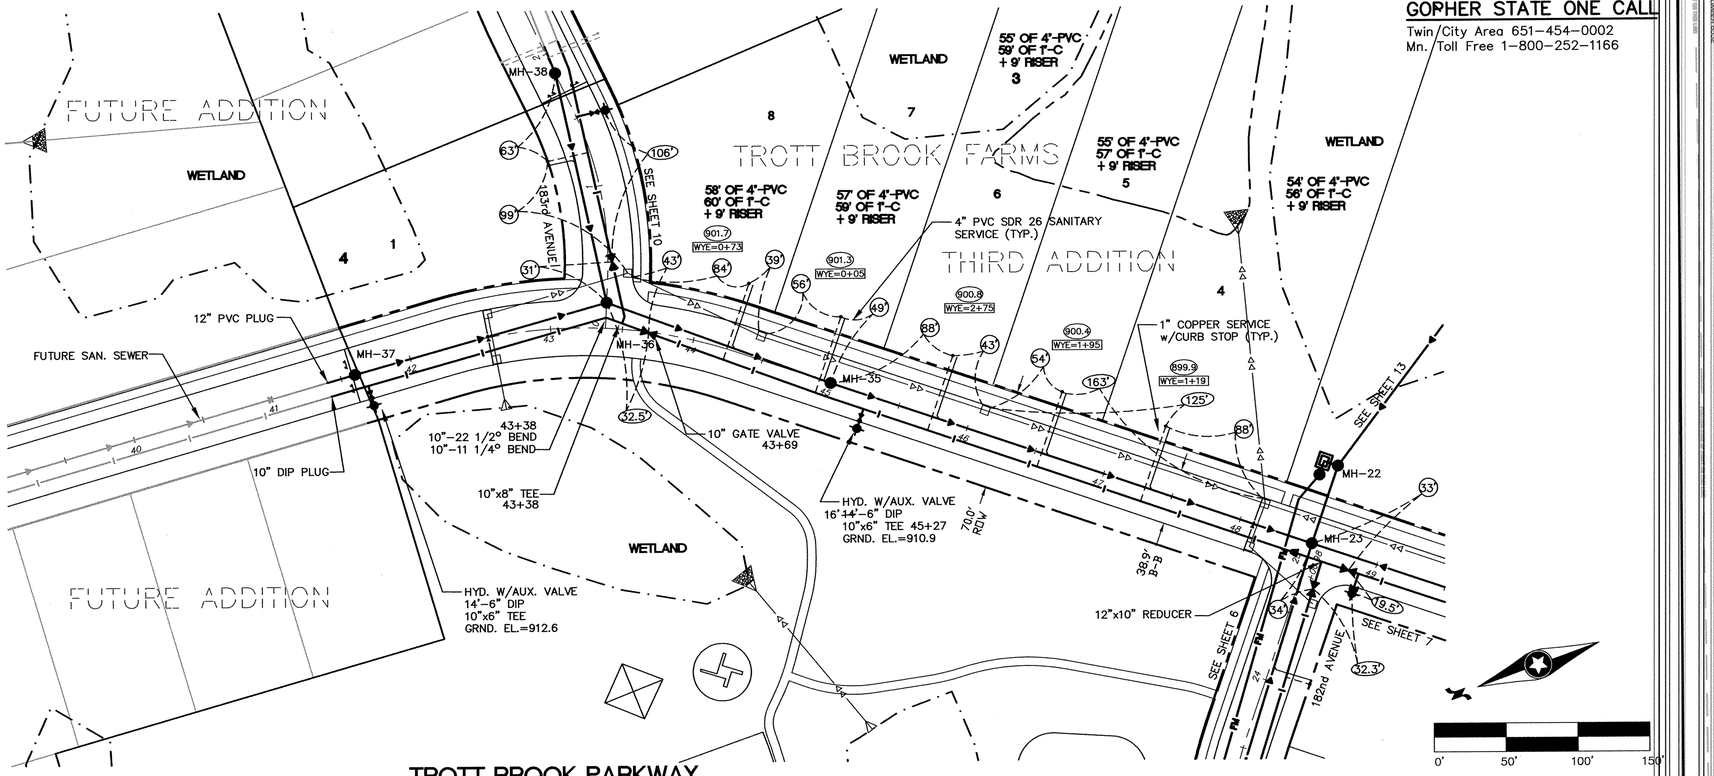


## TROTT BROOK PARKWAY

CONTRACTOR: RYAN CONTRACTING, INC.

RECORD DRAWING
CONFORMING TO CONSTRUCTION RECORDS.
BY S. HUTTNER DATE 7/20/01
WESTWOOD PROFESSIONAL SERVICES

LATEST REVISION DATE: 7/27/99

REVISIONS
6/28/99
7/23/99 PER CITY REDLINES
7/27/99 PER CITY REDLINES

Westwood
Westwood Professional Services, Inc
7599 Anagram Drive
Eden Prairie, MN 55344
612 937-5150

I hereby certify that this plan was prepared by me or under my direct supervision and that I am a duly registered PROFESSIONAL ENGINEER under the laws of the State of Minnesota.

DATE 7/27/99 REG. NO. 17716

| | | | |
|---|---|---|---|
| DESIGNED | FDH, II | CHECKED | FDH, II |
| DRAWN | WH | RECORD DRAWING BY/DATE | |

PREPARED FOR:
D.R. Horton, INC.
3459 Washington Drive
Suite 204
Eagan, Minnesota 55122

# Trott Brook Farms
Elk River, Minnesota

## Sanitary Sewer & Water Main Construction Plan

DATE 6/1/99
SHEET 8 OF 32

96367 6367UTF6.DWG

P:\96367\dwg\6367UTF6.dwg 07/27/99 042952 PM CDT

DRAWING NUMBER
SAFCO PRODUCTS • NEW HOPE, MINNESOTA
REORDER BY PART NUMBER 63052

DRAWING NUMBER
TROTT1-4.99
8