©1998 Westwood Professional Services, Inc.

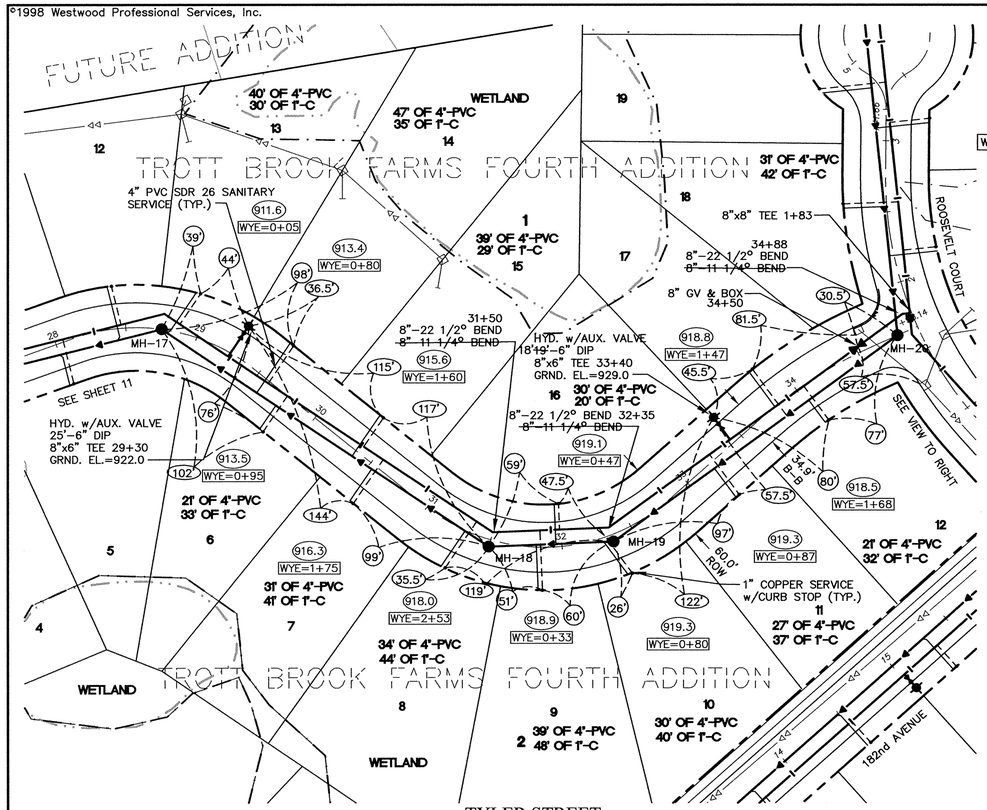

TYLER STREET

GENERAL NOTES:

XXX.X — DENOTES SANITARY SEWER SERVICE INVERT @ ROW LINE. ALL SERVICES SHALL BE EXTENDED 9' INTO PROPERTY WHERE SIDEWALK IS BEING CONSTRUCTED.

WYE=X+XX — DENOTES SANITARY SEWER SERVICE WYE LOCATED ON MAINLINE FROM DOWN STREAM M.H.

FLAG HYDRANTS.

EXTEND RODS ON DEEP VALVES.

CONTRACTOR: RYAN CONTRACTING, INC.
RECORD DRAWING
CONFORMING TO CONSTRUCTION RECORDS.
BY S. HUTTNER DATE 7/20/01
WESTWOOD PROFESSIONAL SERVICES

Call 48 Hours before digging:
GOPHER STATE ONE CALL
Twin City Area 651-454-0002
Mn. Toll Free 1-800-252-1166

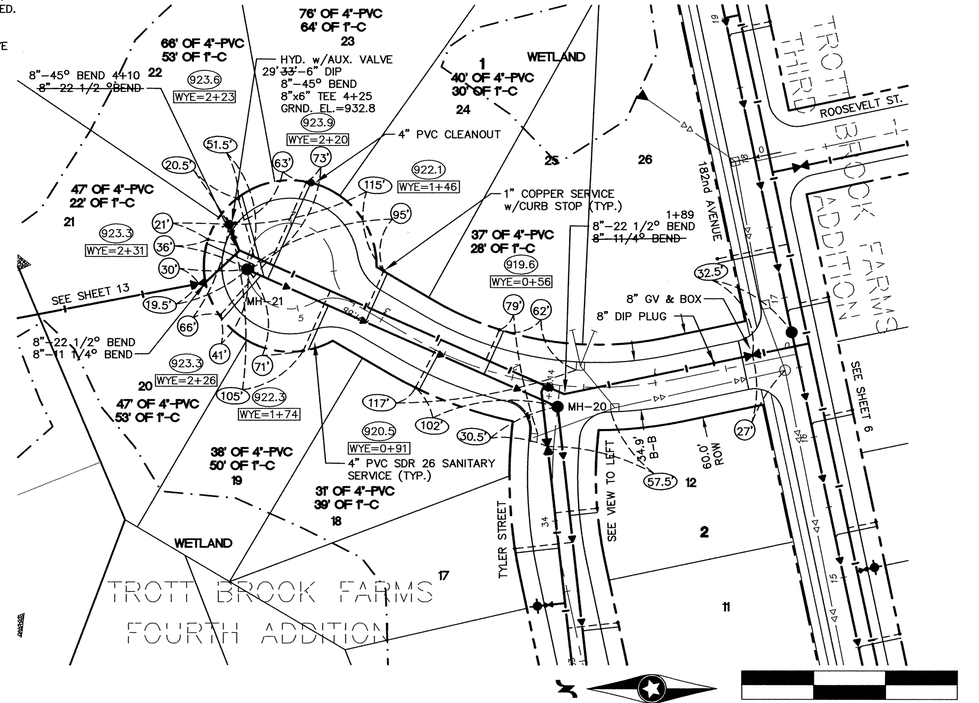

ROOSEVELT CIRCLE

0' 50' 100' 150'

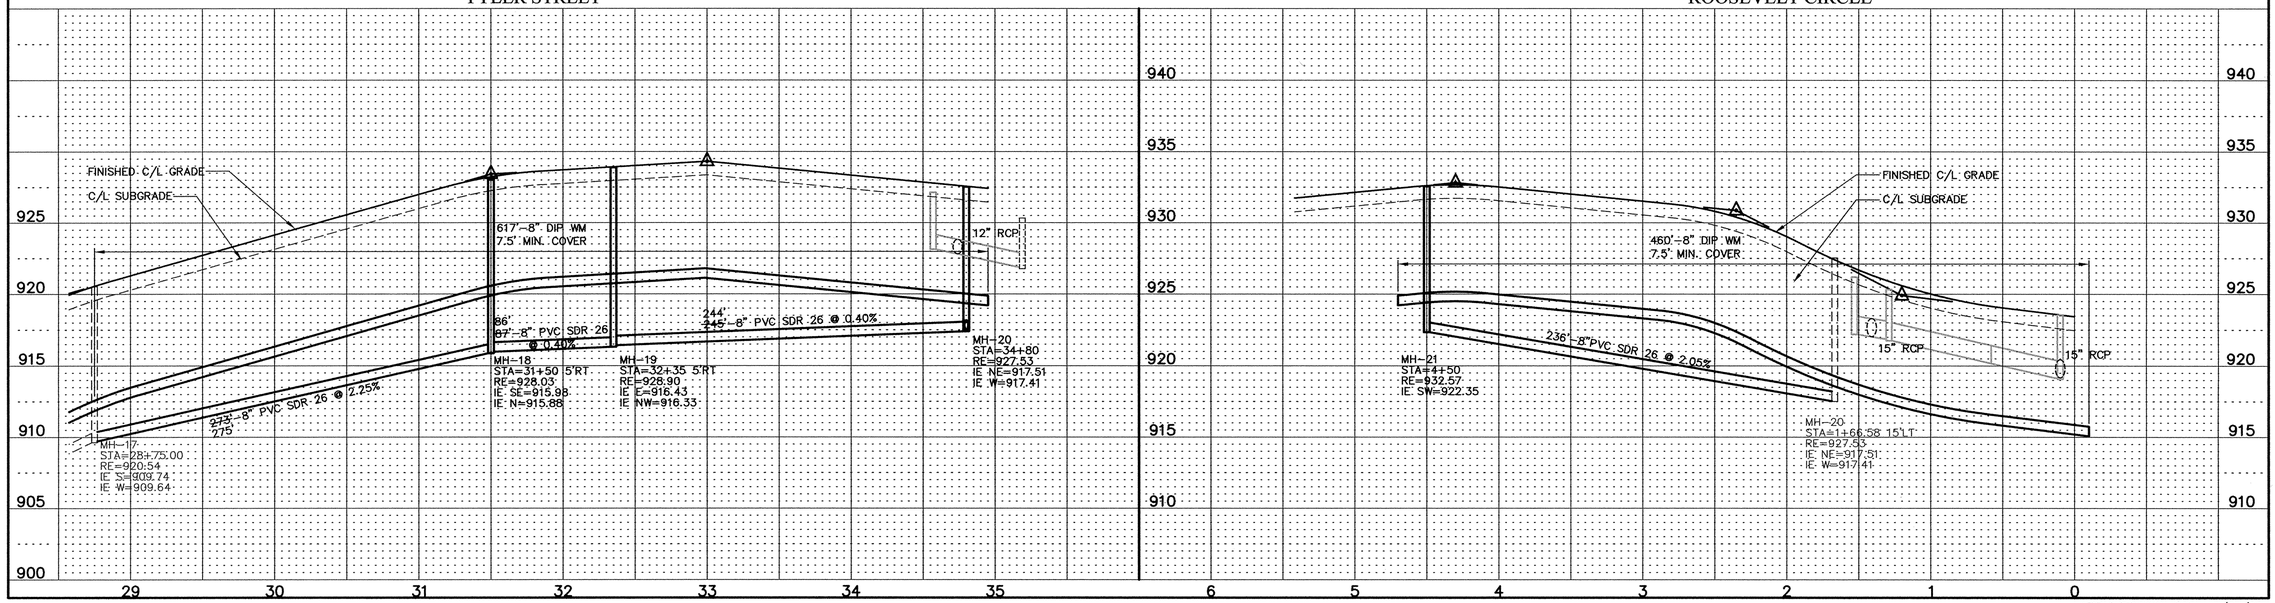

LATEST REVISION DATE: 7/27/99

REVISIONS
6/28/99
7/23/99 PER CITY REDLINES
7/27/99 PER CITY REDLINES

Westwood
Westwood Professional Services, Inc
7599 Anagram Drive
Eden Prairie, MN 55344
612 937-5150

I hereby certify that this plan was prepared by me or under my direct supervision and that I am a duly registered PROFESSIONAL ENGINEER under the laws of the State of Minnesota.

DATE 7/27/99 REG. NO. 17716

DESIGNED	FDH, II	CHECKED	FDH, II
DRAWN	WH	RECORD DRAWING BY/DATE	

PREPARED FOR:
D.R. Horton, INC.
3459 Washington Drive
Suite 204
Eagan, Minnesota 55122

Trott Brook Farms
Elk River, Minnesota

Sanitary Sewer & Water Main Construction Plan

DATE 6/1/99
SHEET 12 OF 32

96367 6367UT10.DWG

P:\96367\dwg\6367UT10.dwg 07/27/99 04:56:30 PM CDT

DRAWING NUMBER
SAFCO PRODUCTS • NEW HOPE, MINNESOTA
REORDER BY PART NUMBER 6958
DRAWING NUMBER
SAFCO PRODUCTS • NEW HOPE, MINNESOTA
REORDER BY PART NUMBER 6958
DRAWING NUMBER
TROTT1-4.99
12
SAFCO PRODUCTS • NEW HOPE, MINNESOTA
REORDER BY PART NUMBER 6958