©1999 Westwood Professional Services, Inc.

GENERAL NOTES:

(XXX.X) DENOTES SANITARY SEWER SERVICE INVERT @ PROPERTY LINE. ALL SERVICES SHALL BE EXTENDED 9' INTO PROPERTY. SANITARY SEWER SERVICE PIPE SHALL BE CALCULATED @ 2.0% FOR STUB INVERT EL.

WYE=X+XX DENOTES SANITARY SEWER SERVICE WYE LOCATED ON MAINLINE FROM DOWN STREAM M.H.

FLAG HYDRANTS.

EXTEND RODS ON DEEP VALVES.

ALL DROP MANHOLES TO BE CONSTRUCTED USING OUTSIDE DROPS.

Call 48 Hours before digging:
GOPHER STATE ONE CALL
Twin City Area 651-454-0002
Mn. Toll Free 1-800-252-1166

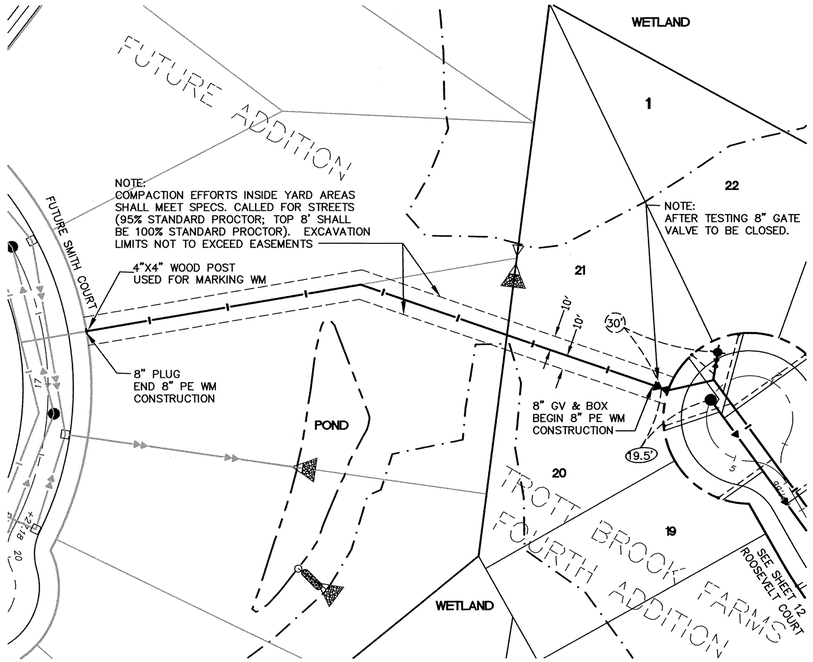

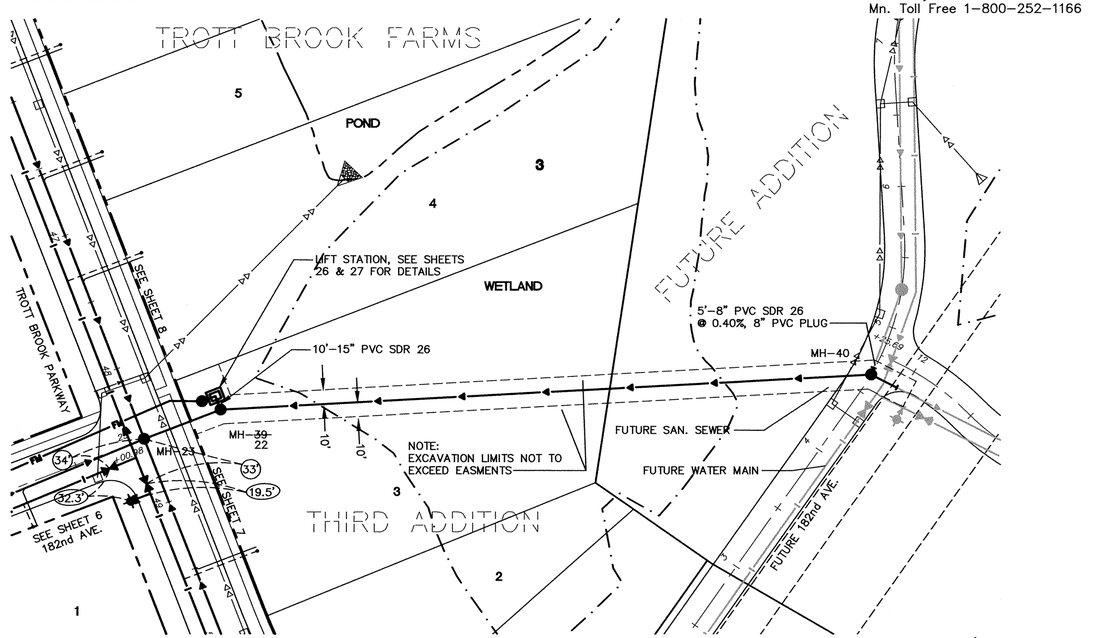

CONTRACTOR: RYAN CONTRACTING, INC.

RECORD DRAWING
CONFORMING TO CONSTRUCTION RECORDS.
BY S. HUTTNER *DATE* 7/20/01
WESTWOOD PROFESSIONAL SERVICES

0' 50' 100' 150'

WATER MAIN PROFILE

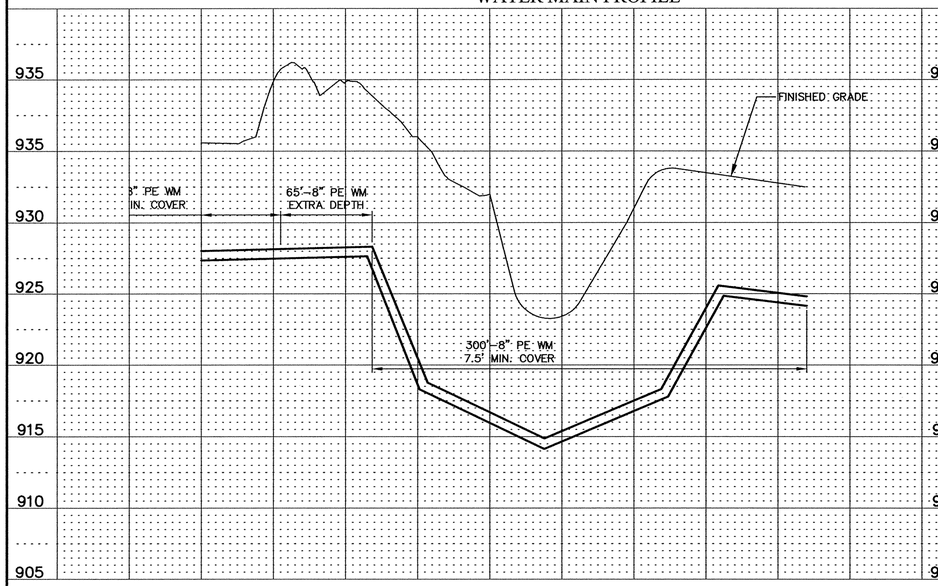

SANITARY SEWER PROFILE

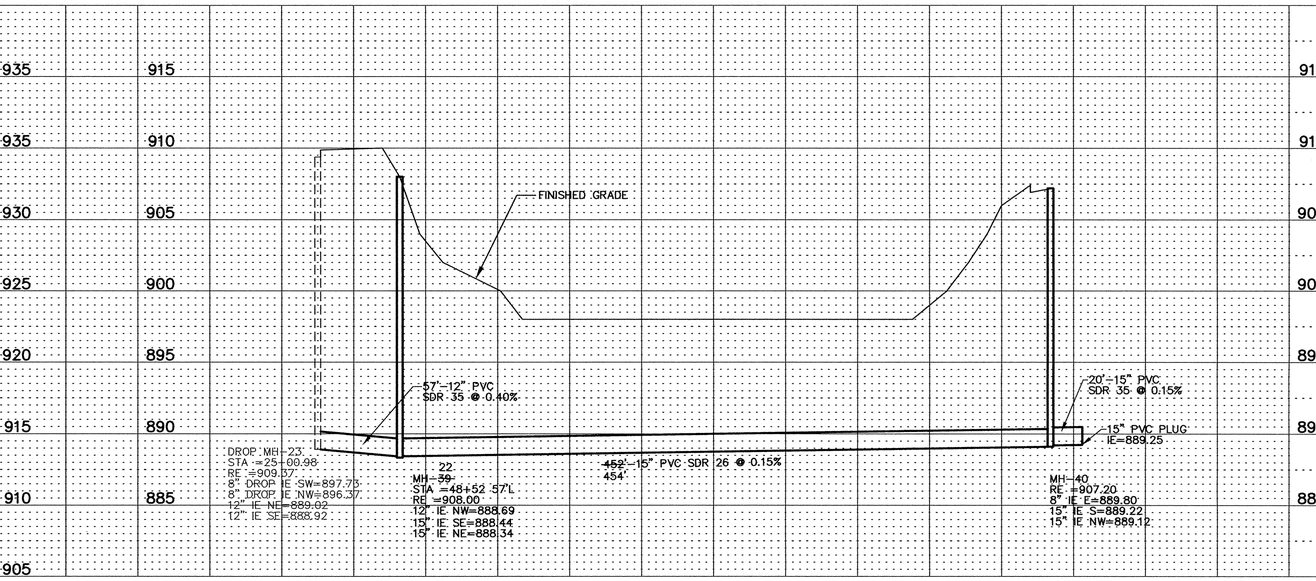

LATEST REVISION DATE: 7/27/99

REVISIONS
6/28/99
7/23/99 PER CITY REDLINES
7/27/99 PER CITY REDLINES

Westwood
Westwood Professional Services, Inc
7599 Anagram Drive
Eden Prairie, MN 55344
612 937-5150

I hereby certify that this plan was prepared by me or under my direct supervision and that I am a duly registered PROFESSIONAL ENGINEER under the laws of the State of Minnesota.

DATE 7/27/99 REG. NO. 17716

DESIGNED	FDH, II	CHECKED	FDH, II
DRAWN	WH	RECORD DRAWING BY/DATE	

PREPARED FOR:
D.R. Horton, INC.
3459 Washington Drive
Suite 204
Eagan, Minnesota 55122

Trott Brook Farms
Elk River, Minnesota

Sanitary Sewer & Water Main Construction Plan

DATE 6/1/99
SHEET 13 OF 32

96367 6367UT11.DWG

P:\96367\dwg\6367UT11.dwg 07/27/99 05:00:00 PM CDT

DRAWING NUMBER
SAFCO PRODUCTS • NEW HOPE, MINNESOTA
REORDER BY PART NUMBER 6552

DRAWING NUMBER
TROTT 1-4 99
13