©1999 Westwood Professional Services, Inc.

GENERAL NOTES:

- RADIUS TO BE B618 C. & G. AS PER CITY DETAIL (TYP.)
- 85.90 DENOTES GUTTERLINE ELEVATION AT INTERSECTIONS
- DENOTES OUTPUT CURB & GUTTER
- ALL RCP SHALL BE CLASS 4, UNLESS OTHERWISE NOTED

CASTING NOTE:

ALL CATCH BASIN CASTINGS IN CURB SHALL BE SUMPED 0.15 FEET AND MANHOLE CASTINGS IN PAVED AREAS SHALL BE SUMPED 0.05 FEET. RIM ELEVATIONS ON PLAN PROFILES REFLECT THE SUMPED ELEVATIONS.

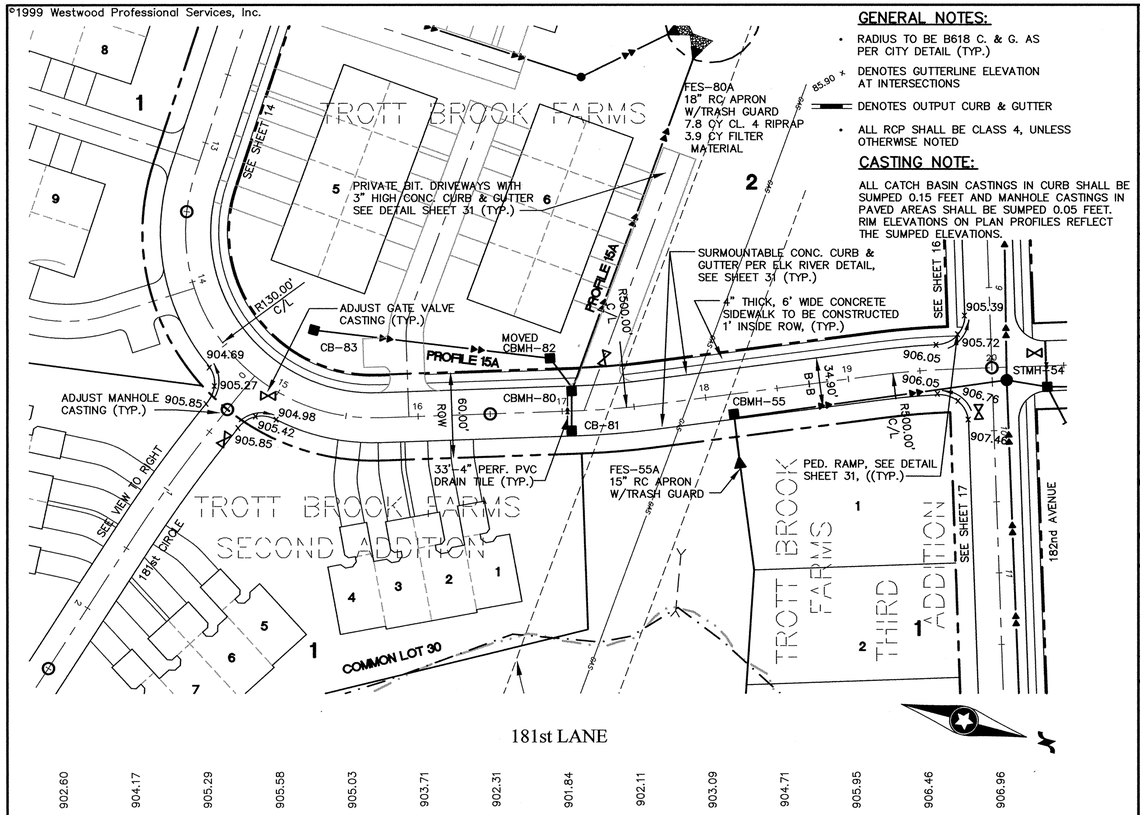

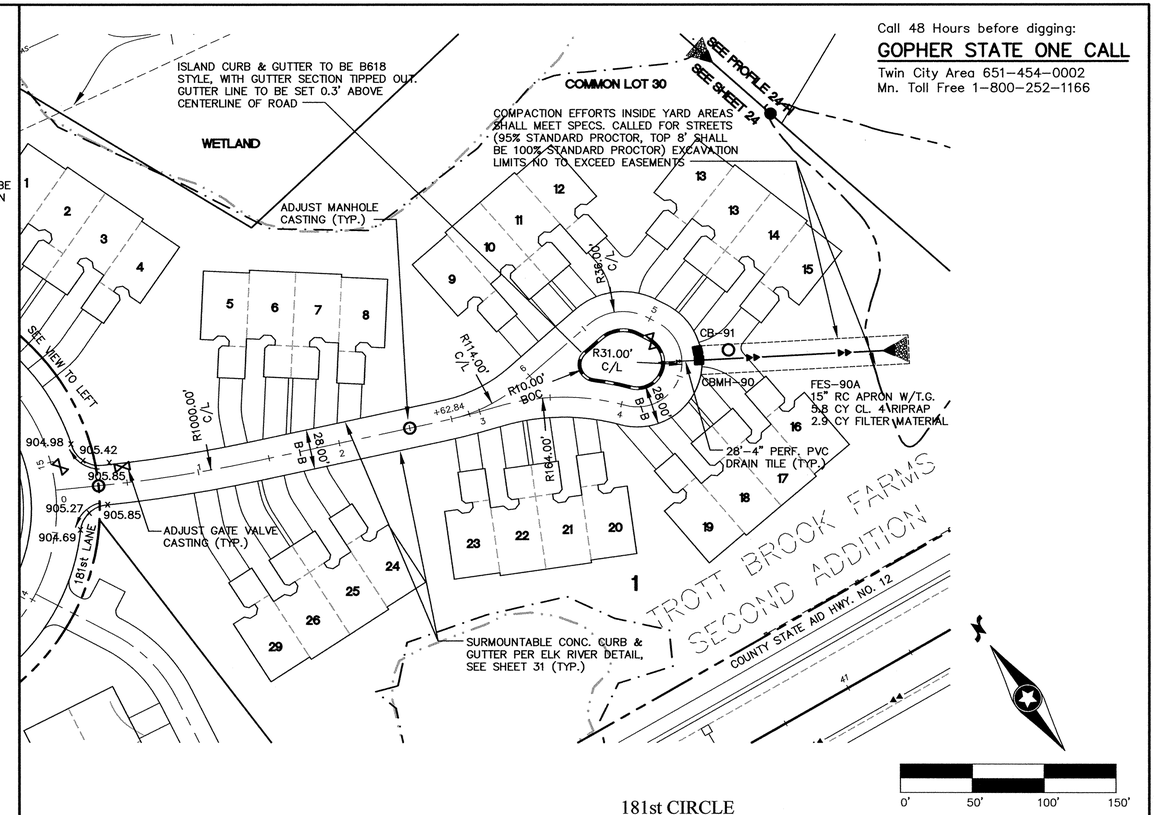

Call 48 Hours before digging:
GOPHER STATE ONE CALL
Twin City Area 651-454-0002
Mn. Toll Free 1-800-252-1166

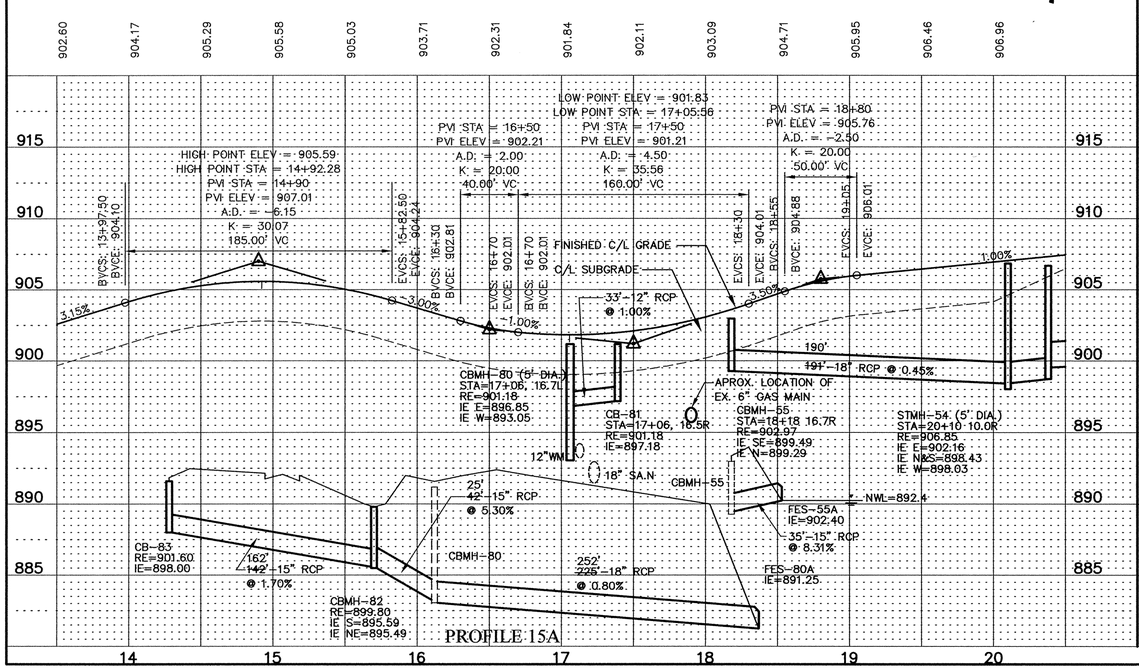

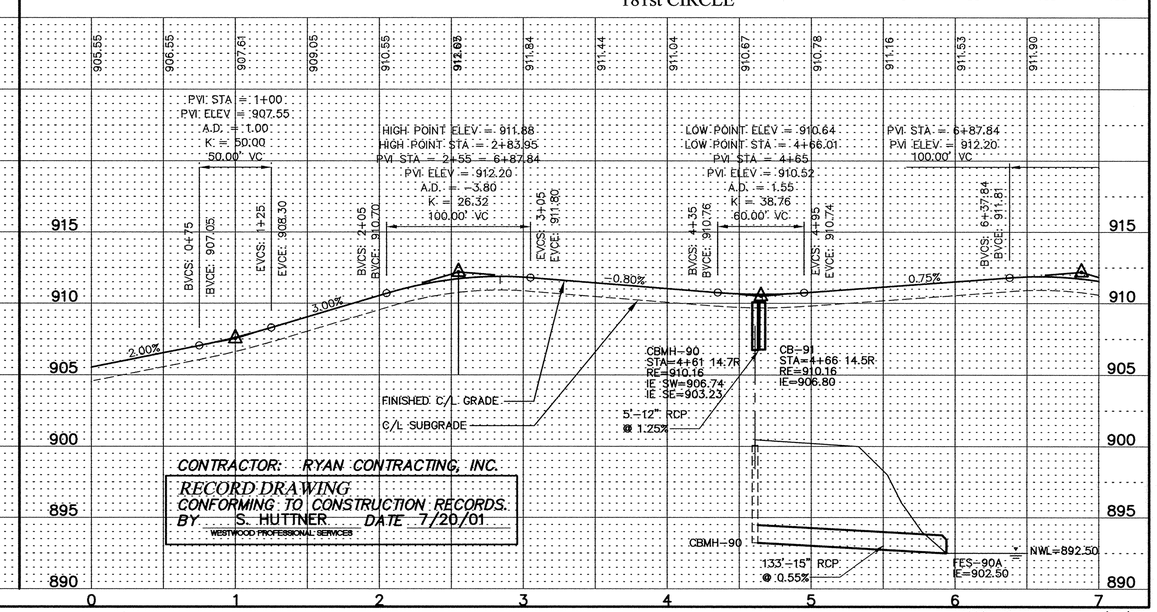

LATEST REVISION DATE: 7/27/99

REVISIONS
6/28/99
7/23/99 PER CITY REDLINES
7/27/99 PER CITY REDLINES

Westwood
Westwood Professional Services, Inc
7599 Anagram Drive
Eden Prairie, MN 55344
612 937-5150

I hereby certify that this plan was prepared by me or under my direct supervision and that I am a duly registered PROFESSIONAL ENGINEER under the laws of the State of Minnesota.

DATE 7/27/99 REG. NO. 17716

DESIGNED	FDH, II	CHECKED	FDH, II
DRAWN	WH	RECORD DRAWING BY/DATE	

PREPARED FOR:
D.R. Horton, INC.
3459 Washington Drive
Suite 204
Eagan, Minnesota 55122

Trott Brook Farms
Elk River, Minnesota

Storm Sewer & Street Construction Plan

DATE 6/1/99
SHEET 15 OF 32

96367 6367STF2.DWG

P:\96367\dwg\6367STF2.dwg 07/27/99 05:11:56 PM CDT

DRAWING NUMBER
DRAWING NUMBER
DRAWING NUMBER
DRAWING NUMBER
TROTT1-4.99
15

SAFCO PRODUCTS • NEW HOPE, MINNESOTA
REORDER BY PART NUMBER 6553