©2000 Westwood Professional Services, Inc.

Construction Plans

for

Sanitary Sewer, Water Main, Storm Sewer and Streets

for

Trott Brook Farms Fifth Addition

Elk River, Minnesota

Prepared for:

D.R. Horton. Inc.
3459 Washington Drive, Suite 204
Eagan, Mnnesota 55122
Contact: Don Patton
Phone: (651) 454–4663

Prepared by:

Westwood Professional Services, Inc.
7599 Anagram Drive
Eden Prairie, MN 55344
Phone: 952/937-5150 Fax: 952/937-5822

Project Number: 99605.03
Contact: Fran Hagen, II

Vicinity Map

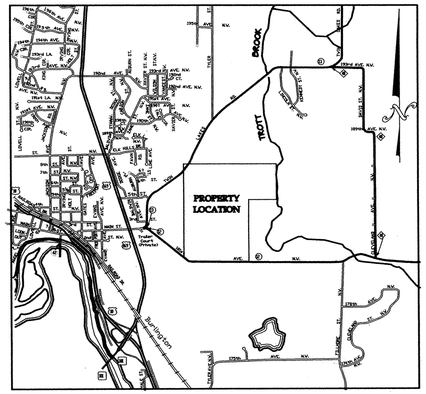

(Not to Scale)

CONTRACTOR: RYAN CONTRACTING, INC.

RECORD DRAWING
CONFORMING TO CONSTRUCTION RECORDS.
BY K. WOOD DATE 3/14/01
WESTWOOD PROFESSIONAL SERVICES

INDEX	
SHEET NO.	DESCRIPTION
1	COVER
2	OVERALL PLAN
3	SANITARY SEWER & WATER MAIN – 182ND AVENUE
4	SANITARY SEWER & WATER MAIN – 181ST LANE
5	STORM SEWER & STREET CONST. – 182ND AVENUE
6	STORM SEWER & STREET CONST. – 181ST LANE
7	STORM SEWER & STREET CONST. – PROFILE 7A/PROFILE 7B
8	SANITARY SEWER DETAILS
9	WATER MAIN DETAILS
10	STORM SEWER DETAILS
11	STREET DETAILS

NO.	DATE	REVISION	SHEETS
1	7/18/00	PER CITY REVIEW	1–7
2	8/18/00	LOWER SANITARY SEWER, REVISE WM	1–7
3	8/29/00	SANITARY SEWER MAIN SDR 35/26	1,3,4
4	10/16/00	SW GRADING REVISION	1,4,6,7

AS-BUILT NOTE: SERVICE TIES ARE TO THE CURB BOX.

Construction Plans
for
Sanitary Sewer, Water Main, Storm Sewer and Streets
for
Trott Brook Farms Fifth Addition
Elk River, Minnesota

DATE **5/1/00**

SHEET **1 of 11**

P:\99605\dwg\As-Built\9605CVF1.DWG 03/16/01 08:03:23 AM CST

D-11 99605 9605CVF1.DWG

DRAWING NUMBER
TROTT5.00
1
SAFCO PRODUCTS • NEW HOPE, MINNESOTA
REORDER BY PART NUMBER 65502

DRAWING NUMBER
SAFCO PRODUCTS • NEW HOPE, MINNESOTA
REORDER BY PART NUMBER 65502

DRAWING NUMBER
SAFCO PRODUCTS • NEW HOPE, MINNESOTA
REORDER BY PART NUMBER 65502

DRAWING NUMBER
SAFCO PRODUCTS • NEW HOPE, MINNESOTA
REORDER BY PART NUMBER 65502

5 Addition—2000