©2000 Westwood Professional Services, Inc.

Call 48 Hours before digging:
GOPHER STATE ONE CALL
Twin City Area 651-454-0002
Mn. Toll Free 1-800-252-1166

CONTRACTOR: RYAN CONTRACTING, INC.

RECORD DRAWING
CONFORMING TO CONSTRUCTION RECORDS.
BY K. WOOD DATE 3/14/01
WESTWOOD PROFESSIONAL SERVICES

STORM SEWER CASTING SCHEDULE

STRUCTURE NUMBER	STRUCTURE TYPE	STRUCTURE DIA.	CASTING TYPE
51	FES	21"	-
52	CBMH	48"	R-3508-A2
53	CBMH	48"	R-3067-V
54	CBMH	48"	R-3508-A2
55	CB	2'x3'	R-3067-V
56	FES	12"	
57	STMH	48"	R-1733
58	FES	12"	
60	FES	24"	
61	CBMH	48"	R-3067-V
62	CBMH	48"	R-3067-V
63	FES	12"	
64	CBMH	48"	R-3067-V
65	CBMH	48"	R-3508-A2
66	CBMH	48"	R-3508-A2
67	CBMH	48"	R-3067-V
68	FES	12"	
69	CBMH	48"	R-3508-A2
70	CBMH	48"	R-3067-V
71	CB	2'x3'	R-3067-V
72	CBMH	48"	R-3067-V
73	CBMH	48"	R-3508-A2
74	CBMH	48"	R-3508-A2
75	CBMH	48"	R-3067-V
76	CB	2'x3'	R-3067-V
77	CBMH	48"	R-3067-V
78	CBMH	48"	R-3067-V
79	CB	2'x3'	R-3067-V
80	FES	24"	
81	STMH	48"	R-1733
82	STMH	48"	R-1733
83	FES	24"	
84	FES	12"	
85	OCS	48"	SEE DETAIL
86	FES	12"	
87	OCS	48"	SEE DETAIL

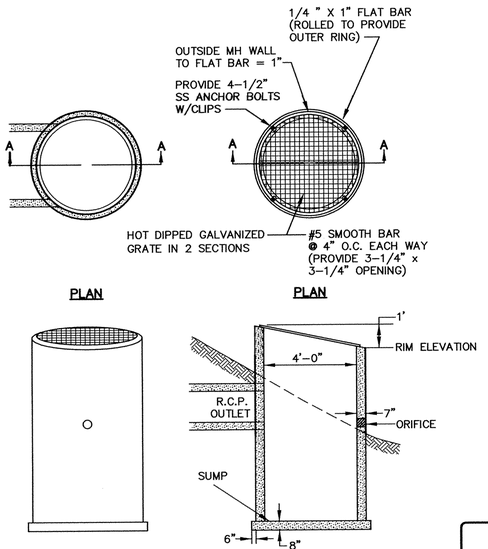

POND OUTLET STRUCTURE
N.T.S.

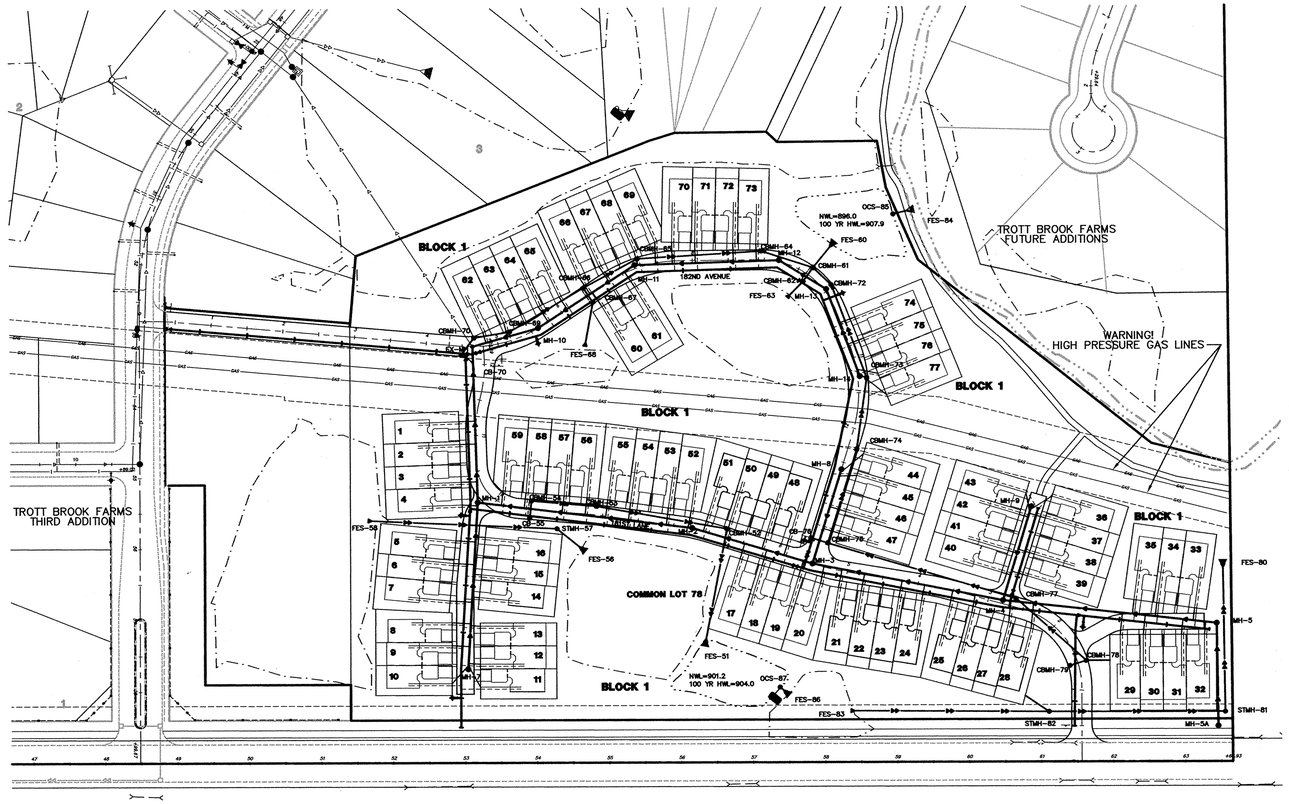

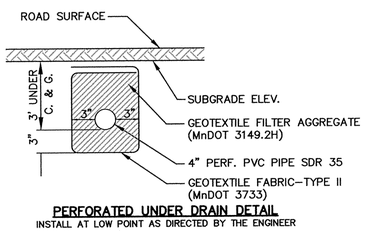

PERFORATED UNDER DRAIN DETAIL
INSTALL AT LOW POINT AS DIRECTED BY THE ENGINEER

PERFORATED DRAIN TILE

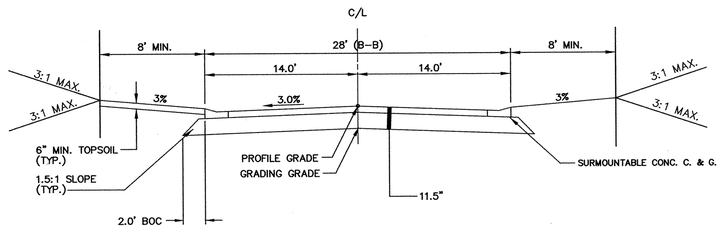

28' B-B TYPICAL SECTION FOR PRIVATE STREET
N.T.S.

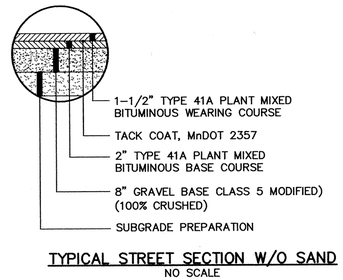

TYPICAL STREET SECTION W/O SAND
NO SCALE

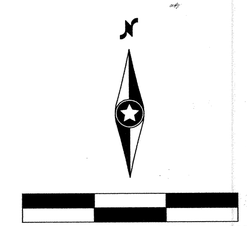

LEGEND

	FUTURE	EXISTING	PROPOSED
Sanitary Sewer			
Water			
Hyd. w\Valve			
Storm Sewer			

P:\99605\dwg\As-Built\9605DAF1.DWG 03/16/01 08:05:27 AM CST

D-11 99605 9605OAF1.DWG

Westwood Professional Services, Inc.
7599 Anagram Drive
Eden Prairie, MN 55344
Phone: 952/937-5150 Fax: 952/937-5822

I hereby certify that this plan was prepared by me or under my direct supervision and that I am a duly registered PROFESSIONAL ENGINEER under the laws of the State of Minnesota.
Date: 8/18/00 Reg. No. 17716

Revisions:
7/18/00 PER CITY REVIEW
5/18/00 WATER MAIN REVISION

Designed: JMMc
Checked: FDH, II
Drawn: MKW
Record Drawing by/date:

Prepared for:
D.R. Horton, Inc.
3459 Washington Drive, Suite 204
Eagan, Minnesota 55122

Trott Brook Farms Fifth Addition

Elk River, Minnesota

Overall Plan

Date: 5/1/2000 Sheet: 2 OF 11

DRAWING NUMBER
TROTT5.00
2

DRAWING NUMBER
SAFCO PRODUCTS • NEW HOPE, MINNESOTA
REORDER BY PART NUMBER 6502

DRAWING NUMBER
SAFCO PRODUCTS • NEW HOPE, MINNESOTA
REORDER BY PART NUMBER 6502

DRAWING NUMBER
SAFCO PRODUCTS • NEW HOPE, MINNESOTA
REORDER BY PART NUMBER 6502