©2000 Westwood Professional Services, Inc.

GENERAL NOTES:

(XXX.X) DENOTES SANITARY SEWER SERVICE INVERT @ TOWNHOME PROPERTY LINE.

WYE=X+XX DENOTES SANITARY SEWER SERVICE WYE LOCATED ON MAINLINE FROM DOWN STREAM M.H.

FLAG HYDRANTS.

EXTEND RODS ON DEEP VALVES.

ALL DROP MANHOLES TO BE CONSTRUCTED USING OUTSIDE DROPS.

ALL SANITARY SEWER MAIN SHALL BE SDR 35 UNLESS OTHERWISE NOTED.

Call 48 Hours before digging:
GOPHER STATE ONE CALL
Twin City Area 651-454-0002
Mn. Toll Free 1-800-252-1166

CONTRACTOR: RYAN CONTRACTING, INC.
RECORD DRAWING
CONFORMING TO CONSTRUCTION RECORDS.
BY K. WOOD DATE 3/14/01
WESTWOOD PROFESSIONAL SERVICES

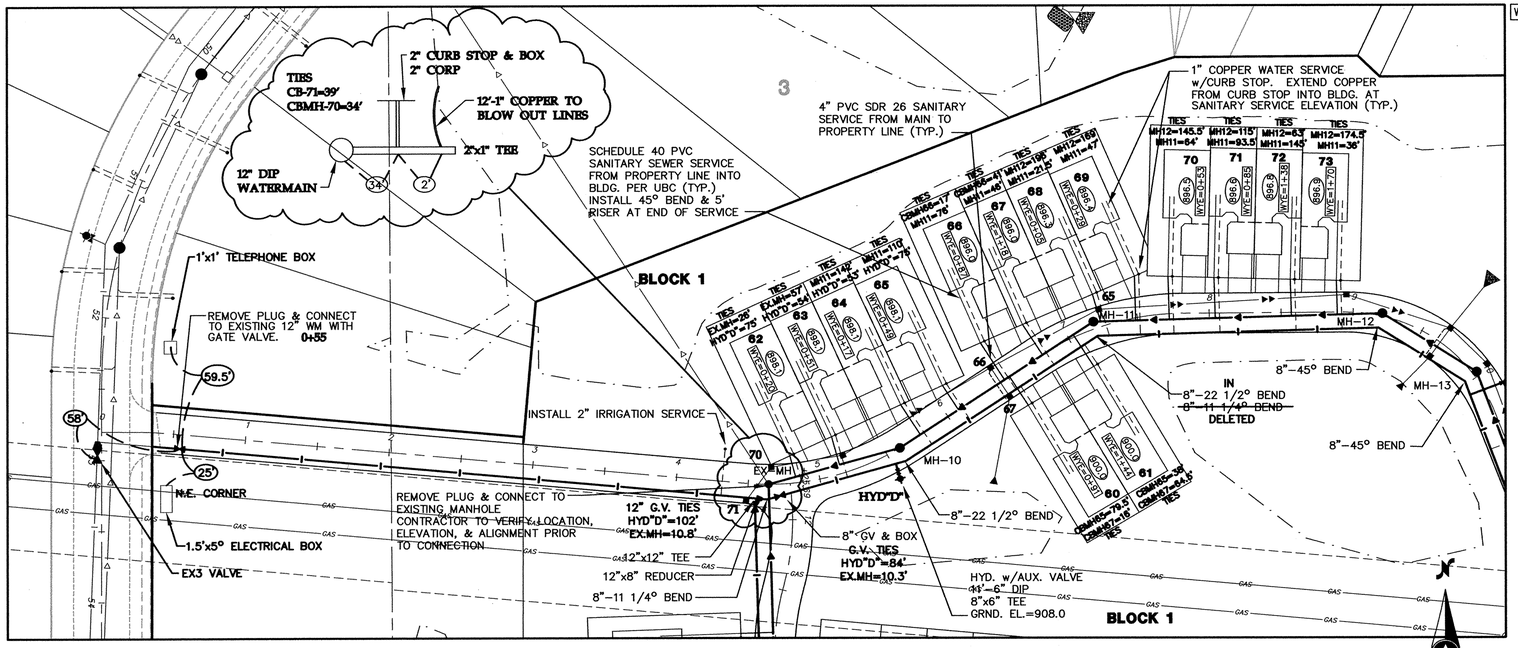

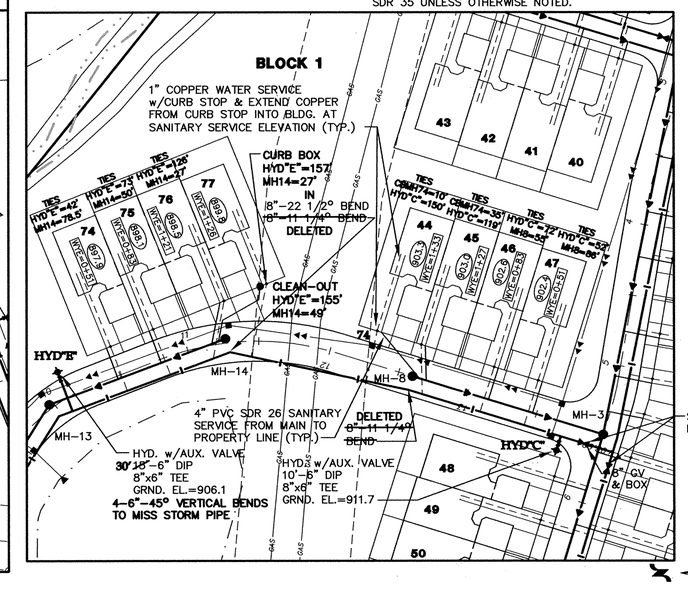

0' 50' 100' 150'

AS-BUILT NOTE: ALL TIES TO CURB BOX.

182ND AVENUE

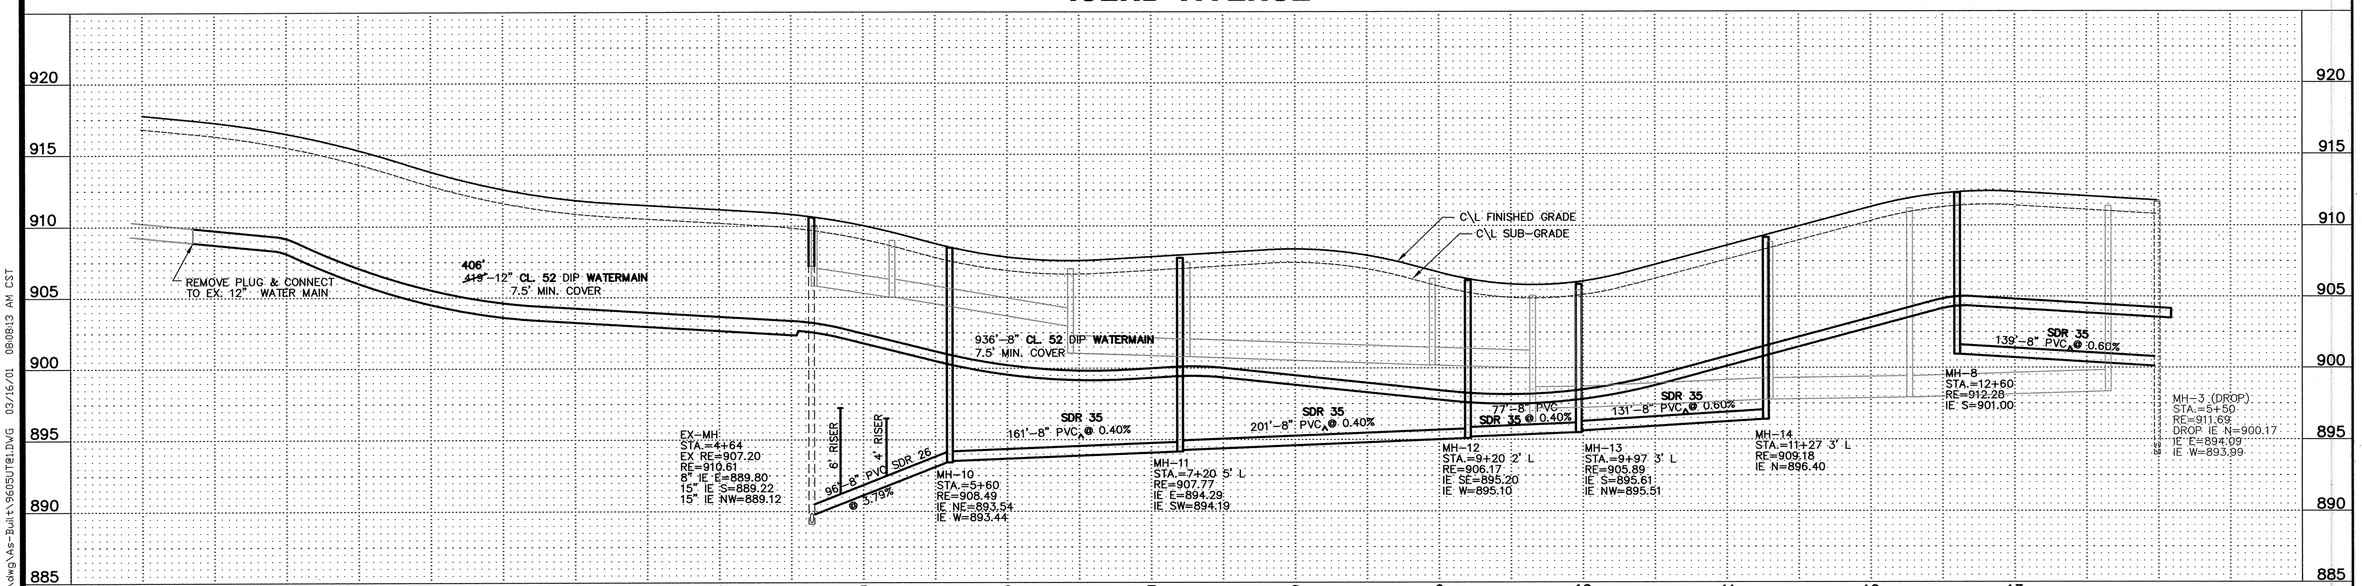

D-11 99605 9605UTF1.DWG

P:\99605\dwg\As-Built\9605UT01.DWG 03/16/01 08:08:13 AM CST

Westwood Professional Services, Inc.
7599 Anagram Drive
Eden Prairie, MN 55344
Phone: 952/937-5150 Fax: 952/937-5822

I hereby certify that this plan was prepared by me or under my direct supervision and that I am a duly registered PROFESSIONAL ENGINEER under the laws of the State of Minnesota.

Date: 8/29/00 Reg. No. 17716

Revisions:
7/18/00 Per City Review
8/18/00 Lower Sanitary Sewer
8/29/00 SANITARY SEWER SDR 35/26

Designed:	JMMc
Checked:	FDH, II
Drawn:	MKW
Record Drawing by/date:	

Prepared for:

D.R. Horton, Inc.
3459 Washington Drive, Suite 204
Eagan, Minnesota 55122

Trott Brook Farms Fifth Addition

Elk River, Minnesota

Date: 5/1/2000 Sheet: 3 OF 11

Sanitary Sewer and Water Main Construction Plans

182ND Avenue

DRAWING NUMBER
DRAWING NUMBER
DRAWING NUMBER
DRAWING NUMBER
TROTT5.00
3