©2000 Westwood Professional Services, Inc.

Call 48 Hours before digging:
GOPHER STATE ONE CALL
Twin City Area 651-454-0002
Mn. Toll Free 1-800-252-1166

GENERAL NOTES:

- RADIUS TO BE B618 C. & G. WITH 10' TRANSITION FROM SURMOUNTABLE CURB
- 11.90 × DENOTES GUTTERLINE ELEVATION AT INTERSECTIONS
- ALL RCP SHALL BE CLASS 4, UNLESS OTHERWISE NOTED

CASTING NOTE:

ALL CATCH BASIN CASTINGS IN CURB SHALL BE SUMPED 0.15 FEET AND MANHOLE CASTINGS IN PAVED AREAS SHALL BE SUMPED 0.05 FEET. RIM ELEVATIONS ON PLAN PROFILES REFLECT THE SUMPED ELEVATIONS.

CONTRACTOR: RYAN CONTRACTING, INC.
RECORD DRAWING
CONFORMING TO CONSTRUCTION RECORDS.
BY K. WOOD DATE 3/14/01
WESTWOOD PROFESSIONAL SERVICES

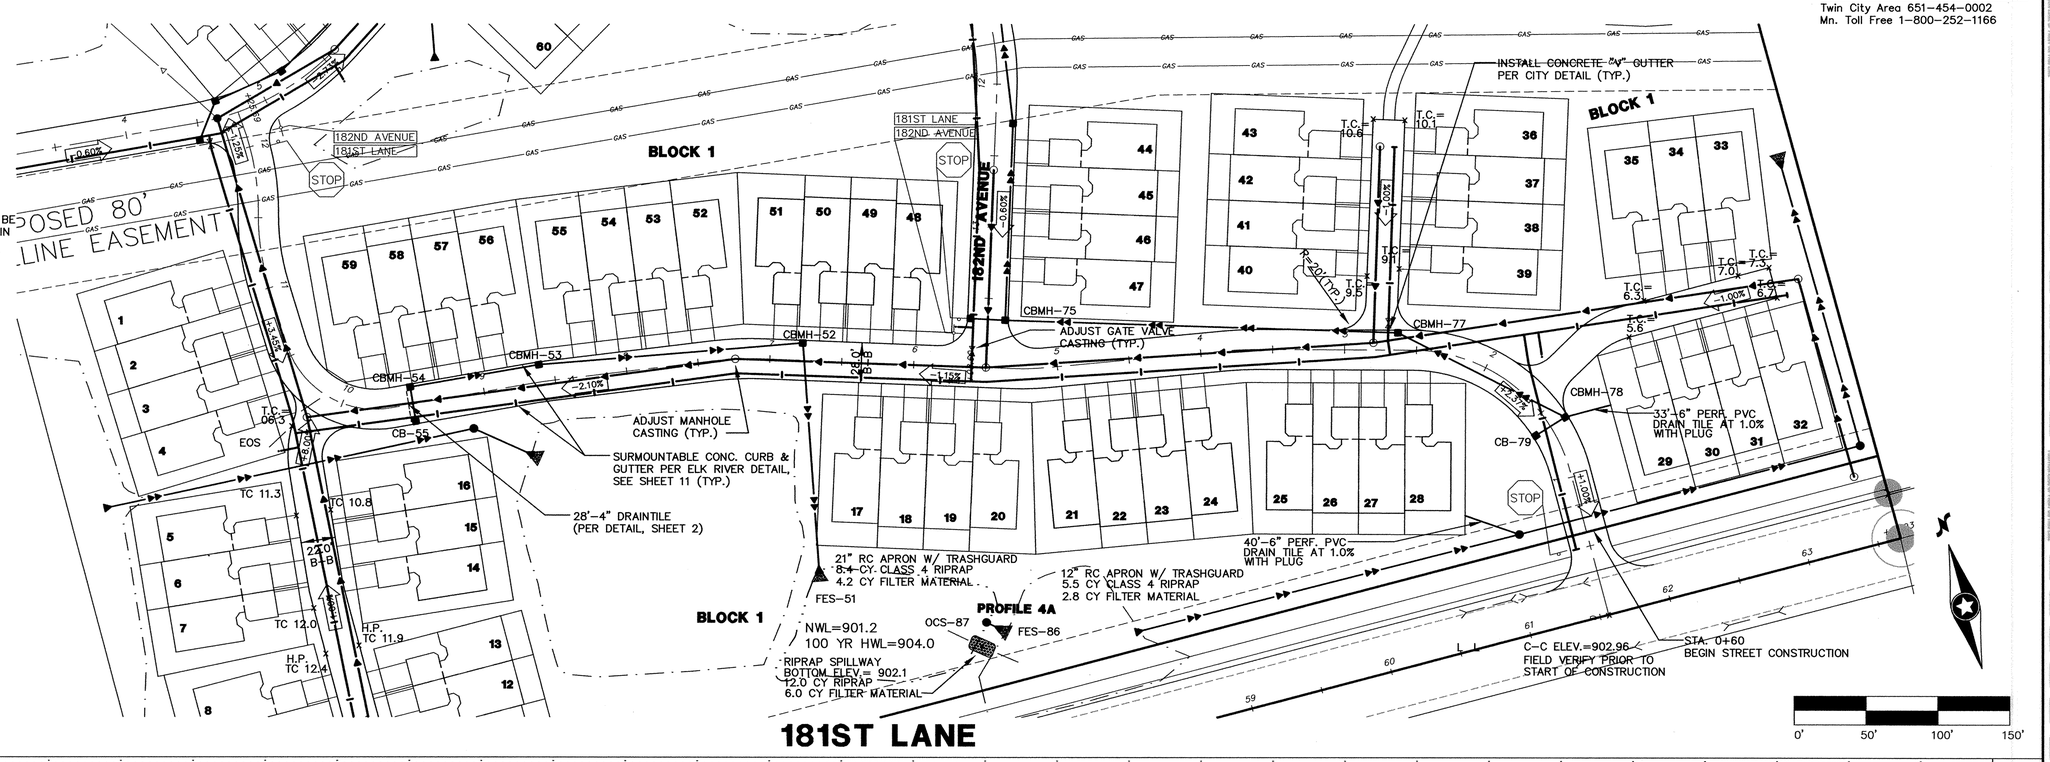

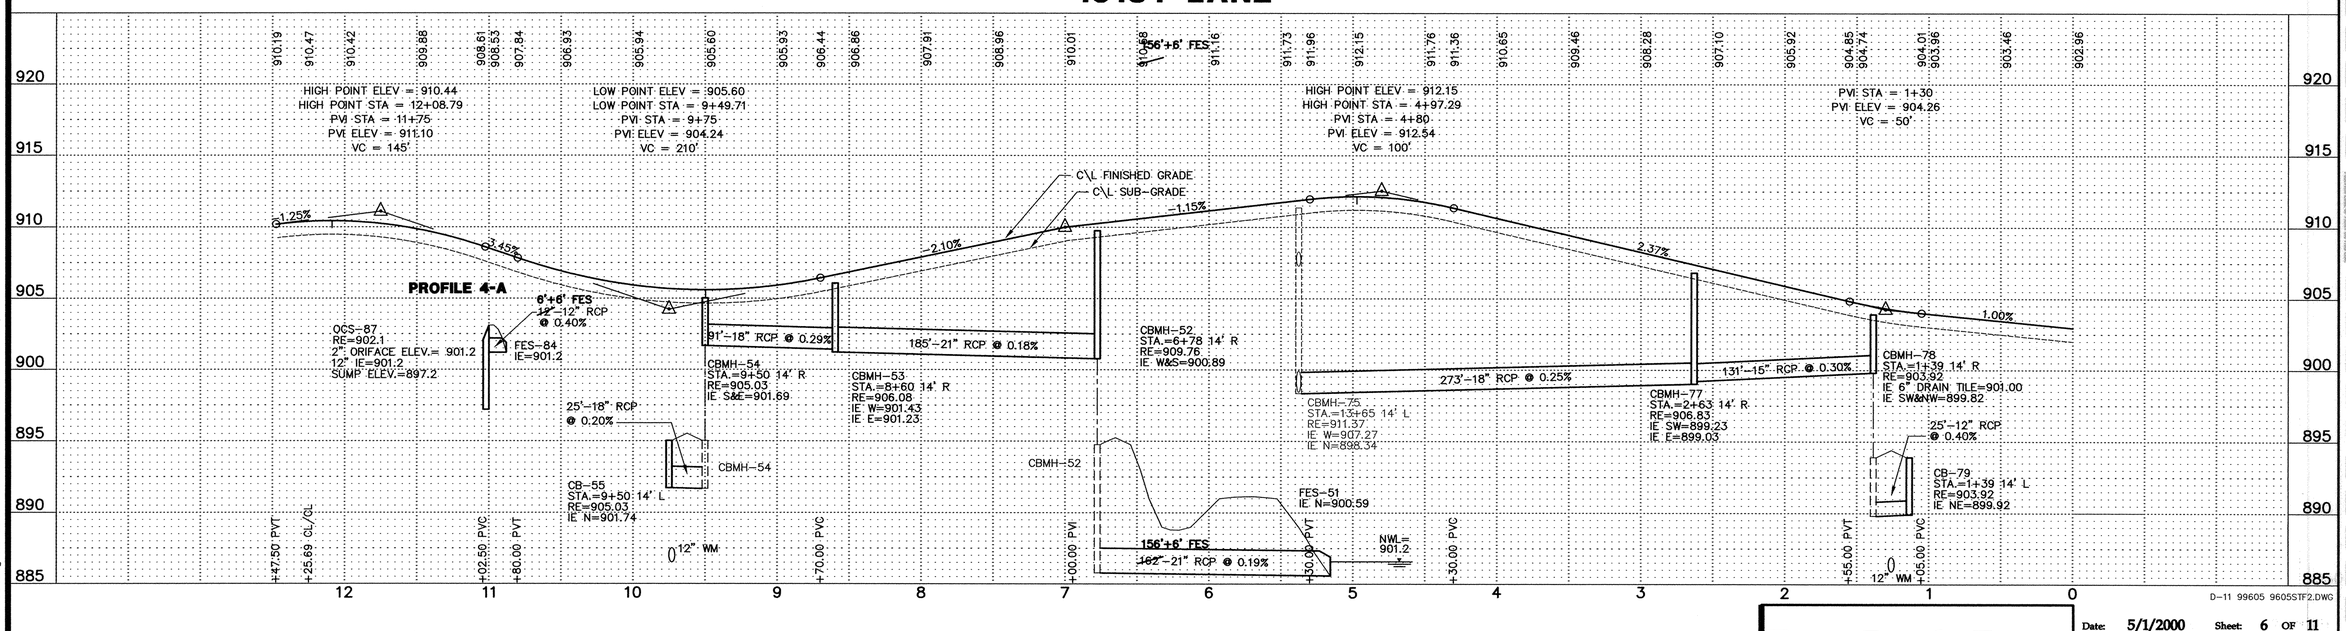

D-11 99605 9605STF2.DWG

P:\99605\dwg\As-Built\9605ST82.DWG 03/16/01 07:32:09 AM CST

Westwood Professional Services, Inc.
7599 Anagram Drive
Eden Prairie, MN 55344
Phone: 952/937-5150 Fax: 952/937-5822

I hereby certify that this plan was prepared by me or under my direct supervision and that I am a duly registered PROFESSIONAL ENGINEER under the laws of the State of Minnesota.

Date: 10/16/00 Reg. No. 17716

Revisions:
7/18/00 Per City Review
10/16/00 SW Grading Revision-WH

Designed: FDH, II
Checked: FDH, II
Drawn: MKW
Record Drawing by/date:

Prepared for:

D.R. Horton, Inc.
3459 Washington Drive, Suite 204
Eagan, Minnesota 55122

Trott Brook Farms Fifth Addition

Elk River, Minnesota

Date: 5/1/2000 Sheet: 6 OF 11

Storm Sewer and Street Construction Plans

181st Lane

DRAWING NUMBER
TROTT5.00
6

SAFCO PRODUCTS • NEW HOPE, MINNESOTA
REORDER BY PART NUMBER 62026