©2000 Westwood Professional Services, Inc.

Call 48 Hours before digging:
**GOPHER STATE ONE CALL**
Twin City Area 651-454-0002
Mn. Toll Free 1-800-252-1166

CONTRACTOR: RYAN CONTRACTING, INC.
RECORD DRAWING
CONFORMING TO CONSTRUCTION RECORDS.
BY K. WOOD DATE 3/14/01
WESTWOOD PROFESSIONAL SERVICES







0' 50' 100' 150'

## PROFILE 7A

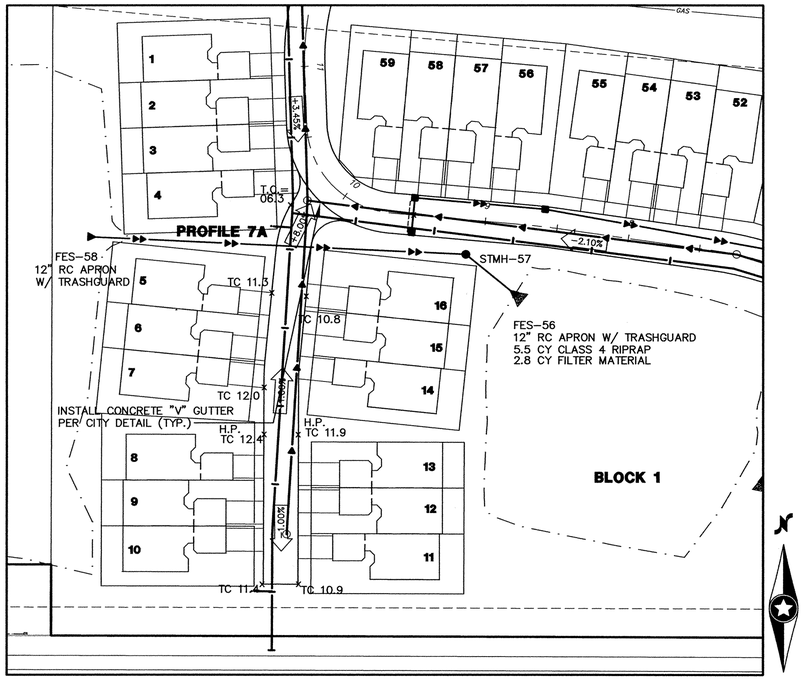


## PROFILE 7B

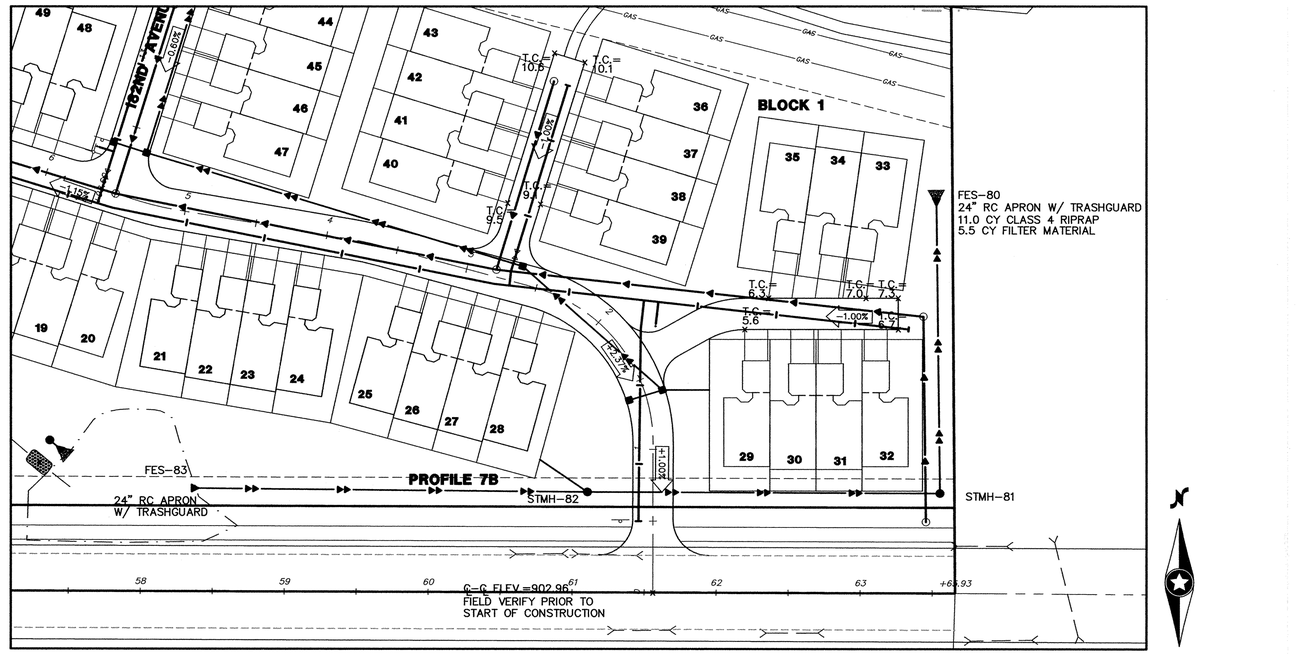


D-11 99605 9605STF3.DWG

P:\99605\dwg\As-Built\9605ST03.dwg 03/15/01 08:16:53 AM CST

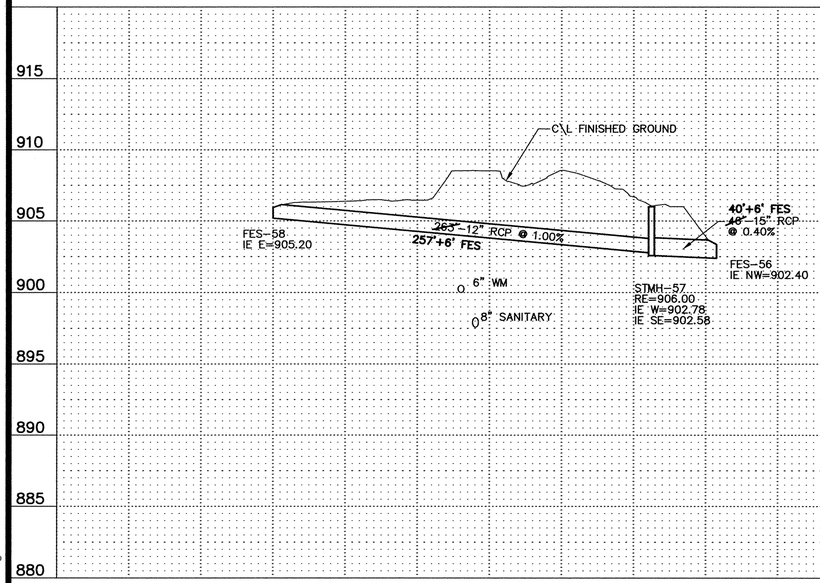**Westwood** Professional Services, Inc.
7599 Anagram Drive
Eden Prairie, MN 55344
Phone: 952/937-5150 Fax: 952/937-5822

I hereby certify that this plan was prepared by me or under my direct supervision and that I am a duly registered PROFISSIONAL ENGINEER under the laws of the State of Minnesota.

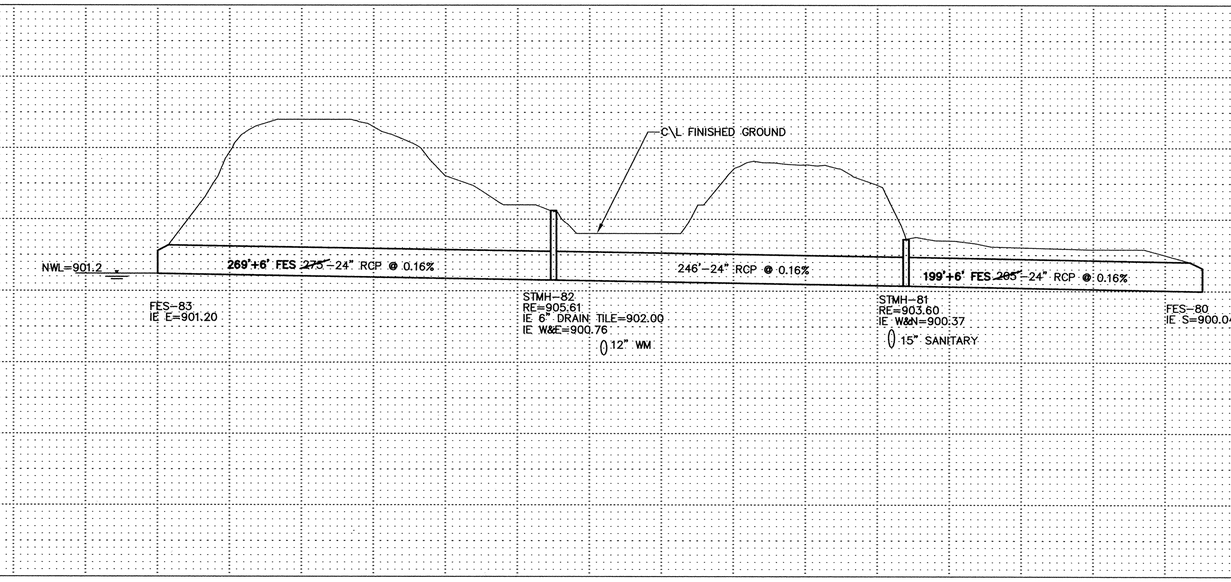Date: 10/16/00 Reg. No. 17716

Revisions:
7/18/00 Per City Review
10/16/00 SW Grading Revisions--WH

Designed: FDH, II
Checked: FDH, II
Drawn: MKW
Record Drawing by/date:

Prepared for:

**D.R. Horton, Inc.**
3459 Washington Drive, Suite 204
Eagan, Minnesota 55122

# Trott Brook Farms Fifth Addition

Elk River, Minnesota

Date: 5/1/2000 Sheet: 7 OF 11

**Storm Sewer Profile and Construction Plans**

Profile A & B

DRAWING NUMBER
TROTT5.00
7

SAFCO PRODUCTS • NEW HOPE, MINNESOTA
REORDER BY PART NUMBER 6552