©2001 Westwood Professional Services, Inc.

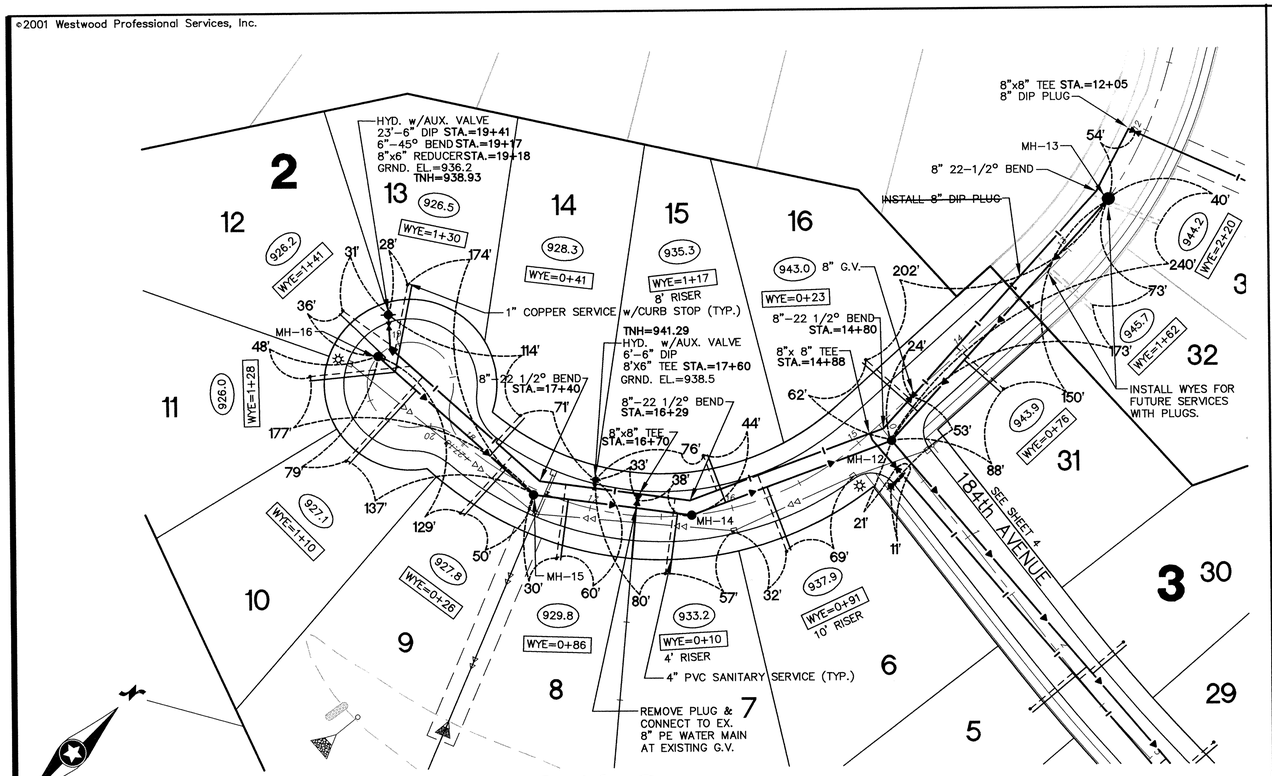

Smith Court

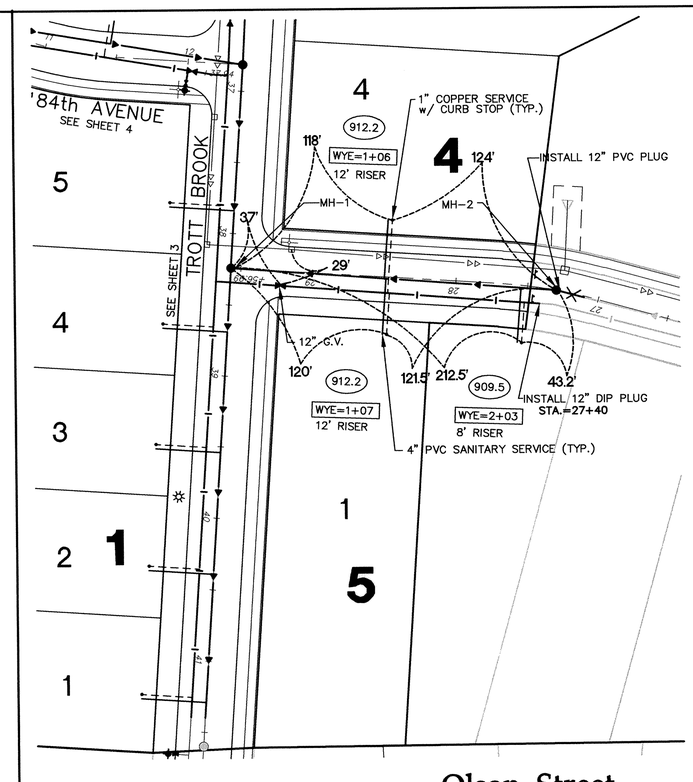

Olson Street

Call 48 Hours before digging:
GOPHER STATE ONE CALL
Twin City Area 651-454-0002
Mn. Toll Free 1-800-252-1166

GENERAL NOTES:

(XXX.X) DENOTES SANITARY SEWER SERVICE INVERT @ ROW LINE. ALL SERVICES SHALL BE EXTENDED 9' INTO PROPERTY WHERE SIDEWALK IS BEING CONSTRUCTED.

WYE=X+XX DENOTES SANITARY SEWER SERVICE WYE LOCATED ON MAINLINE FROM DOWN STREAM M.H.

FLAG HYDRANTS.

EXTEND RODS ON DEEP VALVES.

ALL DROP MANHOLES TO BE CONSTRUCTED USING OUTSIDE DROPS.

SANITARY SEWER & WATER SERVICES TO BE EXTENDED 10' PAST R.O.W. ON ALL LOTS

0' 50' 100' 150'

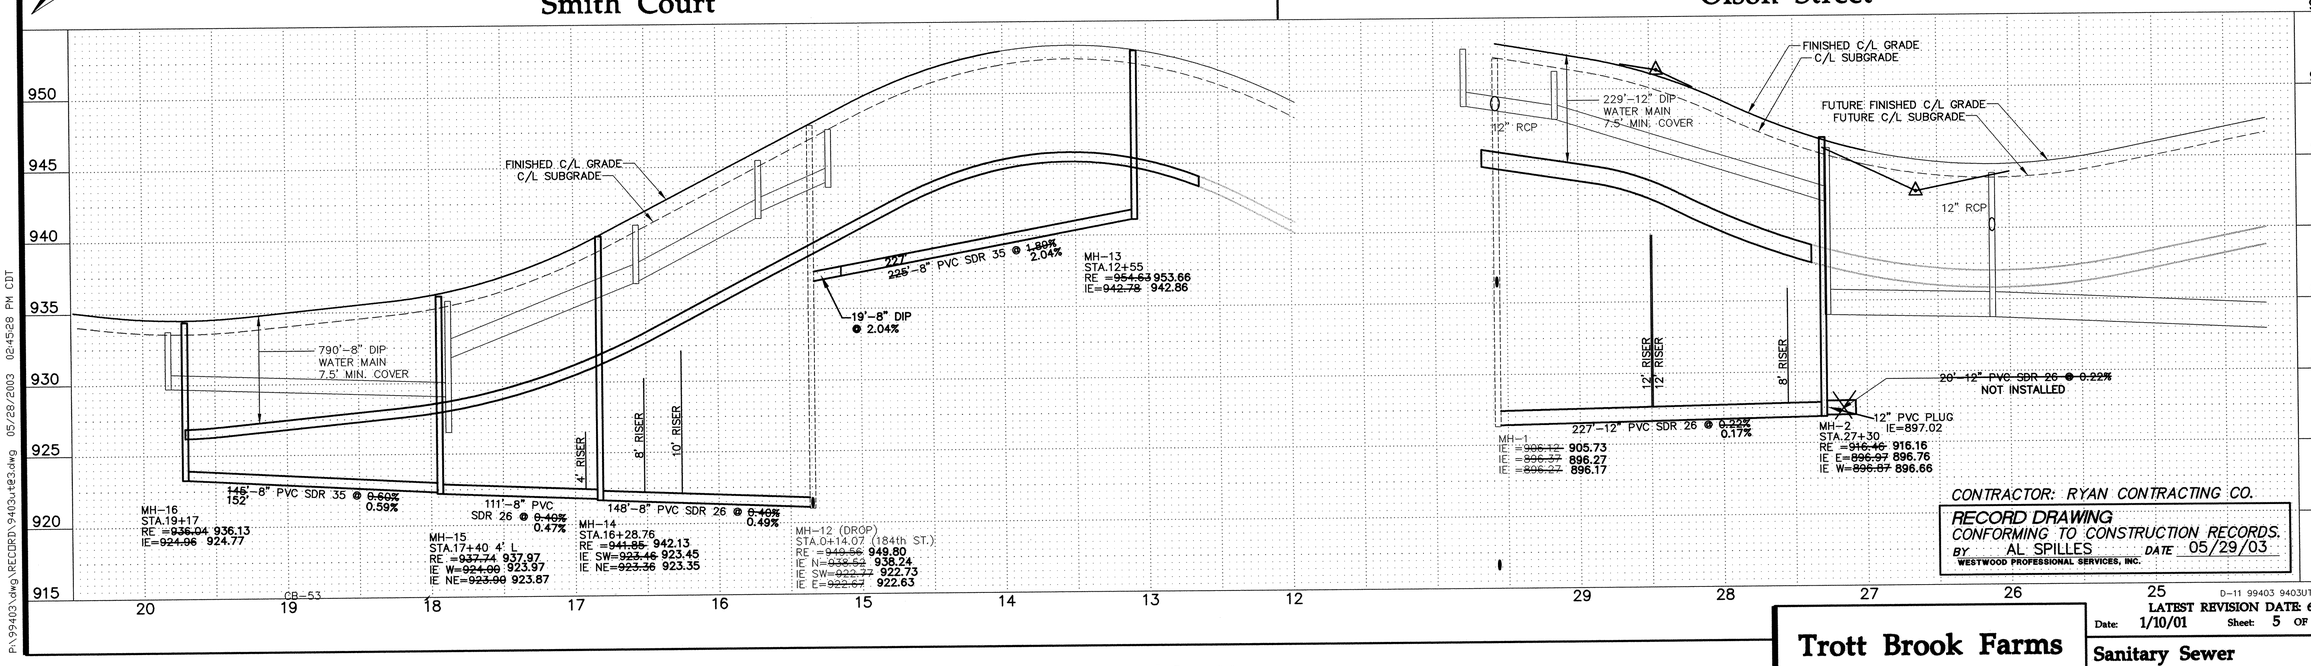

P:\99403\dwg\RECORD\9403ut03.dwg 05/28/2003 02:45:28 PM CDT

D-11 99403 9403UT03.DWG

LATEST REVISION DATE: 6/25/01

Date: 1/10/01 Sheet: 5 OF 18

Westwood Professional Services, Inc.
7599 Anagram Drive
Eden Prairie, MN 55344
Phone: 952/937-5150 Fax: 952/937-5822

I hereby certify that this plan was prepared by me or under my direct supervision and that I am a duly licensed PROFESSIONAL ENGINEER under the laws of the State of Minnesota.

Francis D. Hagen, II

Date: 05/29/03 License No. 17716

Revisions:

4/2/01	PER CITY REVIEW
5/3/01	PER CITY REVIEW
6/4/01	PER CITY REVIEW
6/14/01	CITY WM REVISION
6/25/01	SAN. SEW. REVISION
05/29/03	RECORD DRAWINGS (AS/GKB)

Designed: JMM
Checked: FDH, II
Drawn: WH / KMW
Record Drawing by/date: 5/29/03 AS

Prepared for:
D.R. Horton, Inc. - Minnesota
3459 Washington Drive, Suite 204
Eagan, Minnesota 55122

Trott Brook Farms 6th Addition

Elk River, Minnesota

Sanitary Sewer and Water Main Construction Plans

Smith Court & Olson Street

DRAWING NUMBER

DRAWING NUMBER TROTT6.02 5