©2002 Westwood Professional Services, Inc.

Construction Plans

for

Sanitary Sewer, Water Main, Storm Sewer and Streets

for

Trott Brook Farms South

Elk River, Minnesota

Prepared for:

D. R. Horton, Inc. - Minnesota
20860 Kenbridge Court
Lakeville, Minnesota 55044
Contact: Tom Bakritges
Phone: (952) 985-7826
Fax: (952) 985-7800

Prepared by:

Westwood Professional Services, Inc.
7599 Anagram Drive
Eden Prairie, MN 55344
Phone: 952/937-5150 Fax: 952/937-5822

Project number: 20011034
Contact: Jason McCarty

Vicinity Map

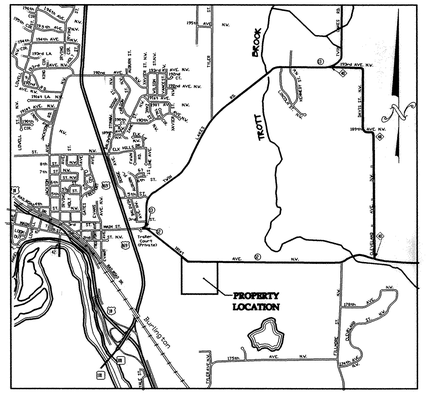

(Not to Scale)

INDEX

SHEET NO.	DESCRIPTION
1	COVER
2	OVERALL PLAN & TWIN LAKES ROAD MEDIAN WORK
3	SANITARY SEWER & WATER MAIN – SHARED DRIVE 12
4	SANITARY SEWER & WATER MAIN – VICTORIA CIRCLE (Sta. 0+00 to Sta. 11+54.50)
5	SANITARY SEWER & WATER MAIN – SMITH STREET (Sta. 11+54.50 to Sta. 17+98.03)
6	SANITARY SEWER & WATER MAIN – TYLER DRIVE (Sta. 6+42 to Sta. 16+46.59)
7	SANITARY SEWER & WATER MAIN – TYLER DRIVE (Sta. 0+00 to Sta. 6+42) AND 180th AVENUE (Sta. 0+00 to Sta. 5+15.90)
8	SANITARY SEWER & WATER MAIN – TYLER STREET (Sta. 0+00 to Sta. 8+90)
9	WATER MAIN – C.S.A.H. No. 12 (Sta. 36+00 to Sta. 45+00)
10	WATER MAIN – C.S.A.H. No. 12 (Sta. 45+00 to Sta. 53+00)
11	STORM SEWER & STREET CONST. – TYLER DRIVE (Sta. 0+00 to Sta. 6+75) AND 180th AVENUE (Sta. 0+00 to Sta. 5+15.90)
12	STORM SEWER & STREET CONST. – TYLER DRIVE (Sta. 6+75 to Sta. 16+46.59)
13	STORM SEWER & STREET CONST. – SMITH STREET (Sta. 11+54.50 to Sta. 17+98.03)
14	STORM SEWER & STREET CONST. – VICTORIA CIRCLE (Sta. 3+25 to Sta. 11+54.50)
15	STORM SEWER & STREET CONST. – VICTORIA CIRCLE (Sta. 0+00 to Sta. 3+25) AND REAR YARDS
16	STORM SEWER & STREET CONST. – TYLER STREET (Sta. 0+00 to Sta. 8+90)
17–21	DETAILS

NO.	DATE	REVISION	SHEETS
1	06/27/02	CITY REVIEW	ALL
2	08/01/02	ADD GATE VALVES FOR VILLAS	ALL
3	02/06/03	REVISE GRADES NE AREA	ALL
4	02/15/05	RECORD DRAWINGS	ALL

CONTRACTOR: RYAN CONTRACTING CO.

RECORD DRAWING
CONFORMING TO CONSTRUCTION RECORDS.
BY AL SPILLES *DATE* 02/15/05
WESTWOOD PROFESSIONAL SERVICES

Construction Plans

for

Sanitary Sewer, Water Main, Storm Sewer and Streets

for

Trott Brook Farms South
Elk River, Minnesota

Date: 05/28/02 **Sheet: 1 of 21**

6-3 20011034CV01.DWG

DRAWING NUMBER
SAFCO PRODUCTS • NEW HOPE, MINNESOTA
REORDER BY PART NUMBER 65302
POSITION EDGE OF PRINT ON THIS LINE

DRAWING NUMBER
SAFCO PRODUCTS • NEW HOPE, MINNESOTA
REORDER BY PART NUMBER 65302
POSITION EDGE OF PRINT ON THIS LINE

DRAWING NUMBER
SAFCO PRODUCTS • NEW HOPE, MINNESOTA
REORDER BY PART NUMBER 65302
POSITION EDGE OF PRINT ON THIS LINE

DRAWING NUMBER
TROTTS.02
1
SAFCO PRODUCTS • NEW HOPE, MINNESOTA
REORDER BY PART NUMBER 65302
POSITION EDGE OF PRINT ON THIS LINE

2002

P:\20011034\dwg\RECORD\20011034CV01.dwg 2/14/2005 7:56:04 AM CST