©2002 Westwood Professional Services, Inc.

Call 48 Hours before digging:
GOPHER STATE ONE CALL
Twin City Area 651-454-0002
Mn. Toll Free 1-800-252-1166

GENERAL NOTES:

XXX.X — DENOTES SANITARY SEWER SERVICE INVERT @ TOWNHOME PROPERTY LINE.

WYE=X+XX — DENOTES SANITARY SEWER SERVICE WYE LOCATED ON MAINLINE FROM DOWN STREAM M.H.

FLAG HYDRANTS.

EXTEND RODS ON DEEP VALVES.

ALL DROP MANHOLES TO BE CONSTRUCTED USING OUTSIDE DROPS.

HYDRANTS TO BE PLACED 5' BEHIND CURB

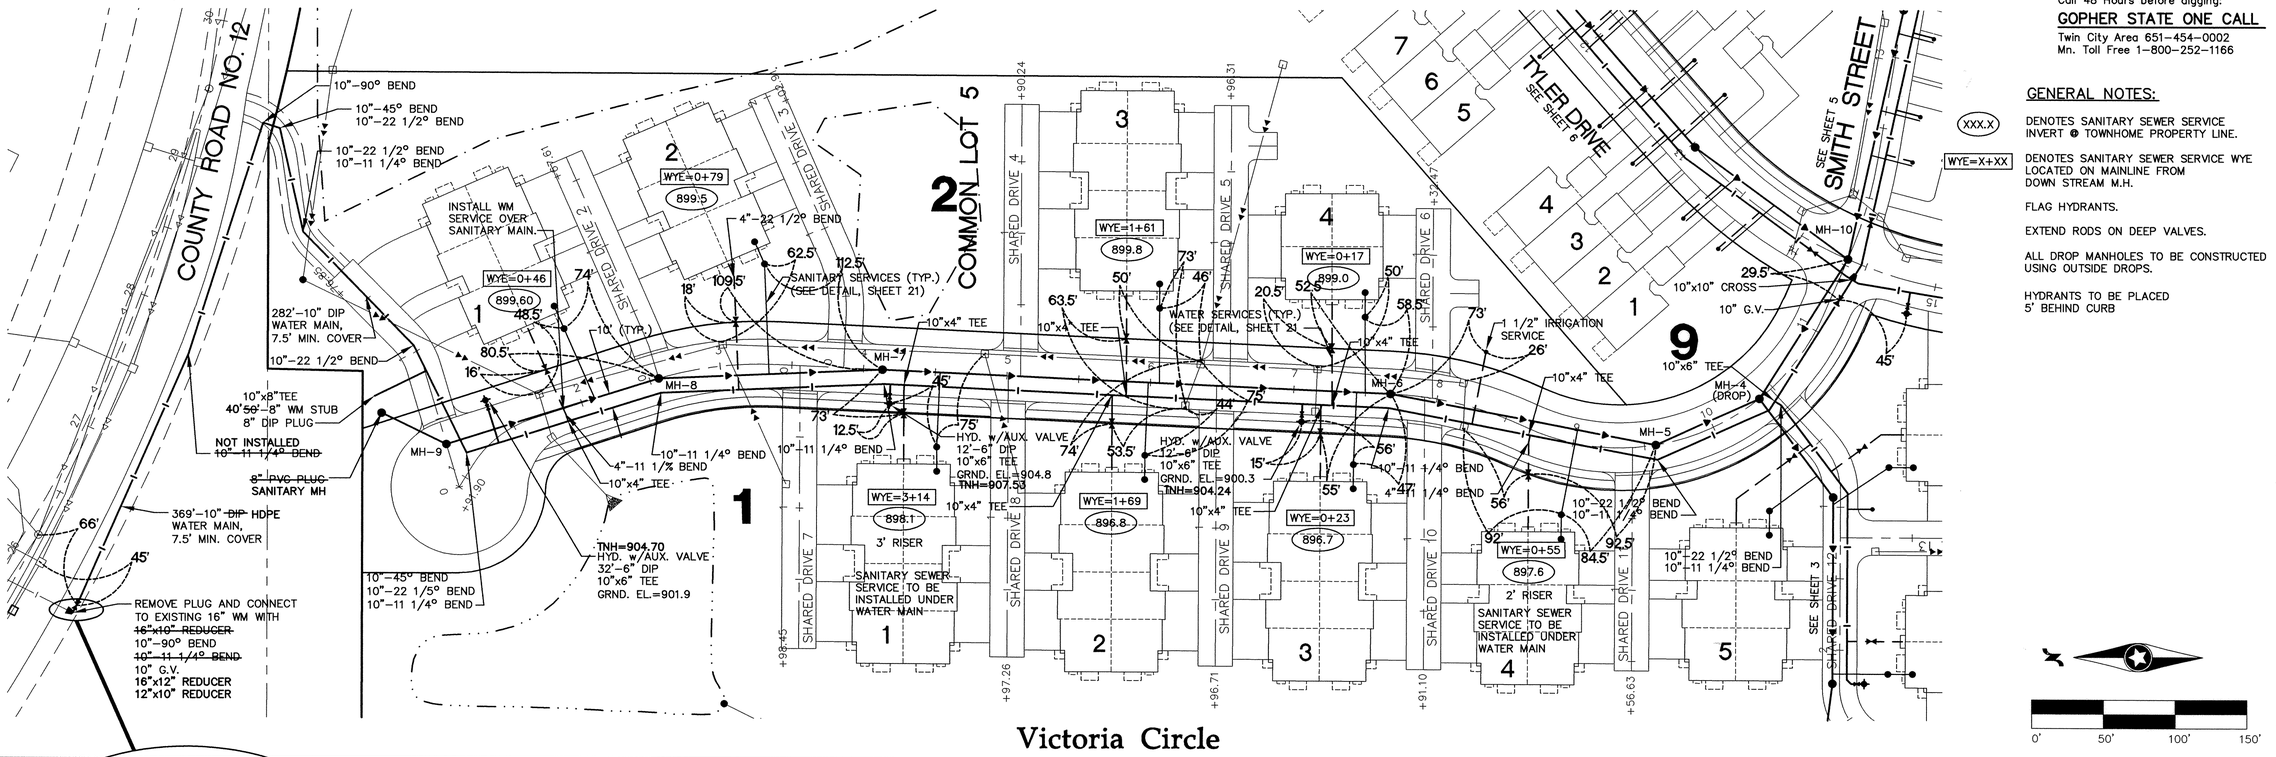

Victoria Circle

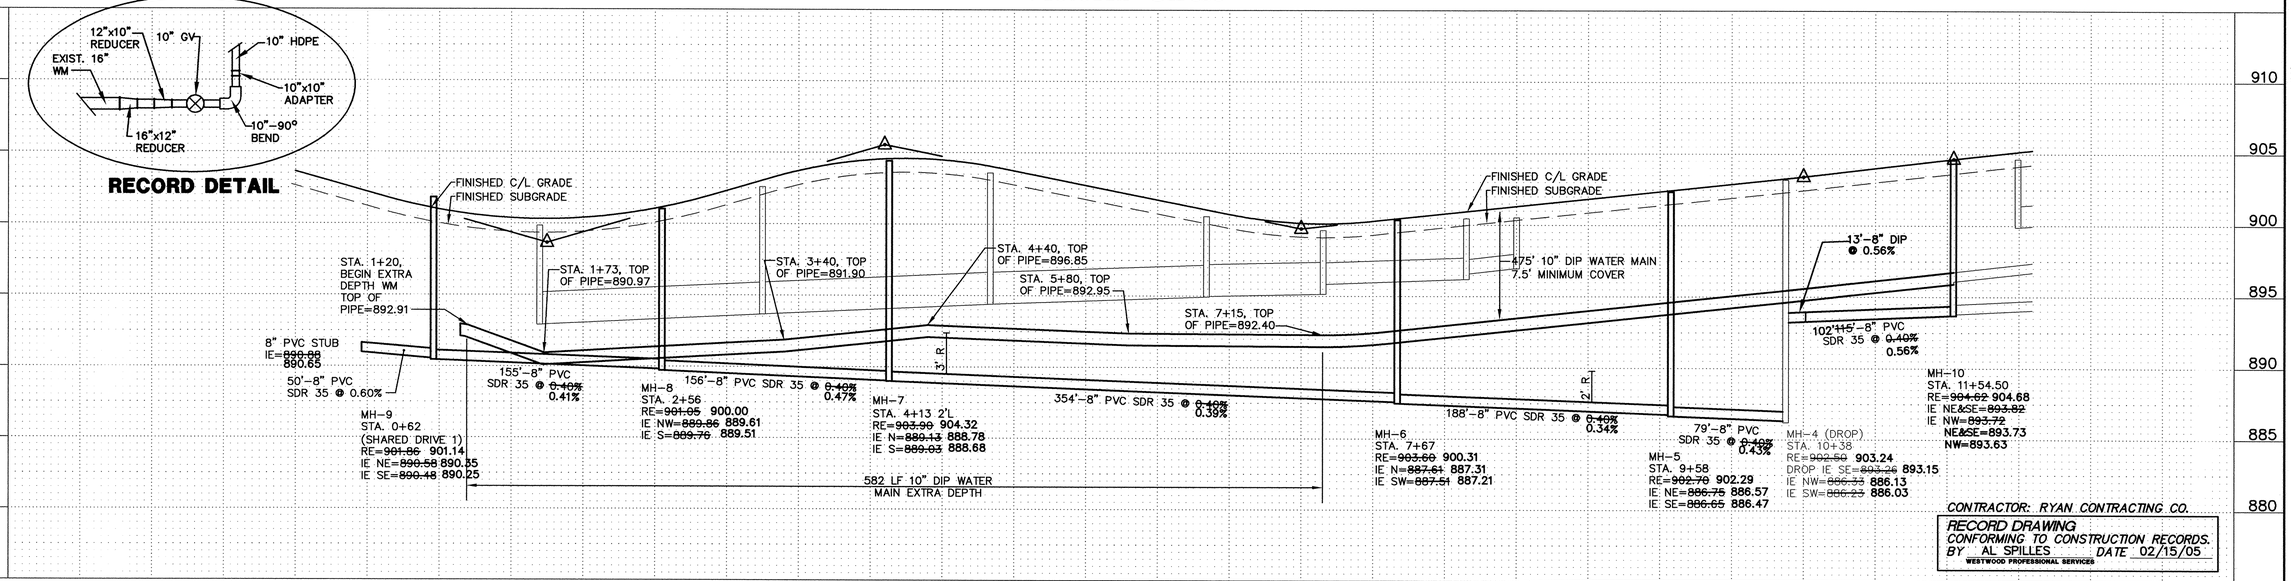

CONTRACTOR: RYAN CONTRACTING CO.

RECORD DRAWING
CONFORMING TO CONSTRUCTION RECORDS.
BY AL SPILLES DATE 02/15/05
WESTWOOD PROFESSIONAL SERVICES

LATEST REVISION DATE: 02/15/05
E-3 20011034UT@2.DWG

P:\20011034\dwg\RECORD\20011034ut@2.dwg 2/14/2005 2:06:38 PM CST

Westwood Professional Services, Inc.
7599 Anagram Drive
Eden Prairie, MN 55344
Phone: 952/937-5150 Fax: 952/937-5822

I hereby certify that this plan was prepared by me or under my direct supervision and that I am a duly licensed PROFESSIONAL ENGINEER under the laws of the State of Minnesota.
Francis D. Hagen, II
Date: 02/15/05 License No. 17716

Revisions:
06/27/02 City Review-RNS
08/01/02 Add G.V.'s for Vlvs-RNS
02/06/03 Revise Grades NE Area-CLJ
06/17/04 RECORD DRAWNG (AS/GKB)
02/15/05 RECORD DRAWNG-CITY REVS. (GKB)

Designed: JMM/FDH, II
Checked: FDH, II
Drawn: WH/RNS
Record Drawing by/date: GKB 2/15/05

Prepared for:
D. R. Horton, Inc. - Minnesota
20860 Kenbridge Court, Suite 100
Lakeville, Minnesota 55044

Trott Brook Farms South

Elk River, Minnesota

Sanitary Sewer and Water Main Construction Plans

Victoria Circle (Sta. 0+00 to Sta. 11+54.50)

Date: 05/28/02 Sheet: 4 OF 21

DRAWING NUMBER
DRAWING NUMBER
DRAWING NUMBER
TROTTS.02
4