©2002 Westwood Professional Services, Inc.

Call 48 Hours before digging:
GOPHER STATE ONE CALL
Twin City Area 651-454-0002
Mn. Toll Free 1-800-252-1166

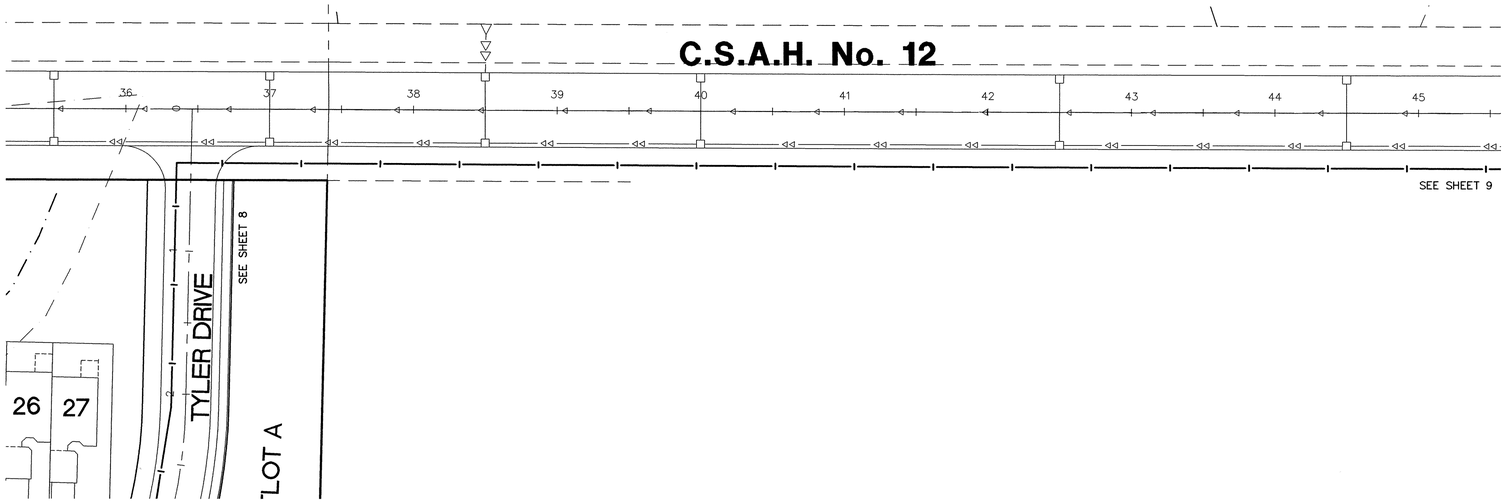

GENERAL NOTES:

(XXX.X) DENOTES SANITARY SEWER SERVICE INVERT @ TOWNHOME PROPERTY LINE.

WYE=X+XX DENOTES SANITARY SEWER SERVICE WYE LOCATED ON MAINLINE FROM DOWN STREAM M.H.

FLAG HYDRANTS.

EXTEND RODS ON DEEP VALVES.

ALL DROP MANHOLES TO BE CONSTRUCTED USING OUTSIDE DROPS.

HYDRANTS TO BE PLACED 5' BEHIND CURB

N

0' 50' 100' 150'

C.S.A.H. No. 12

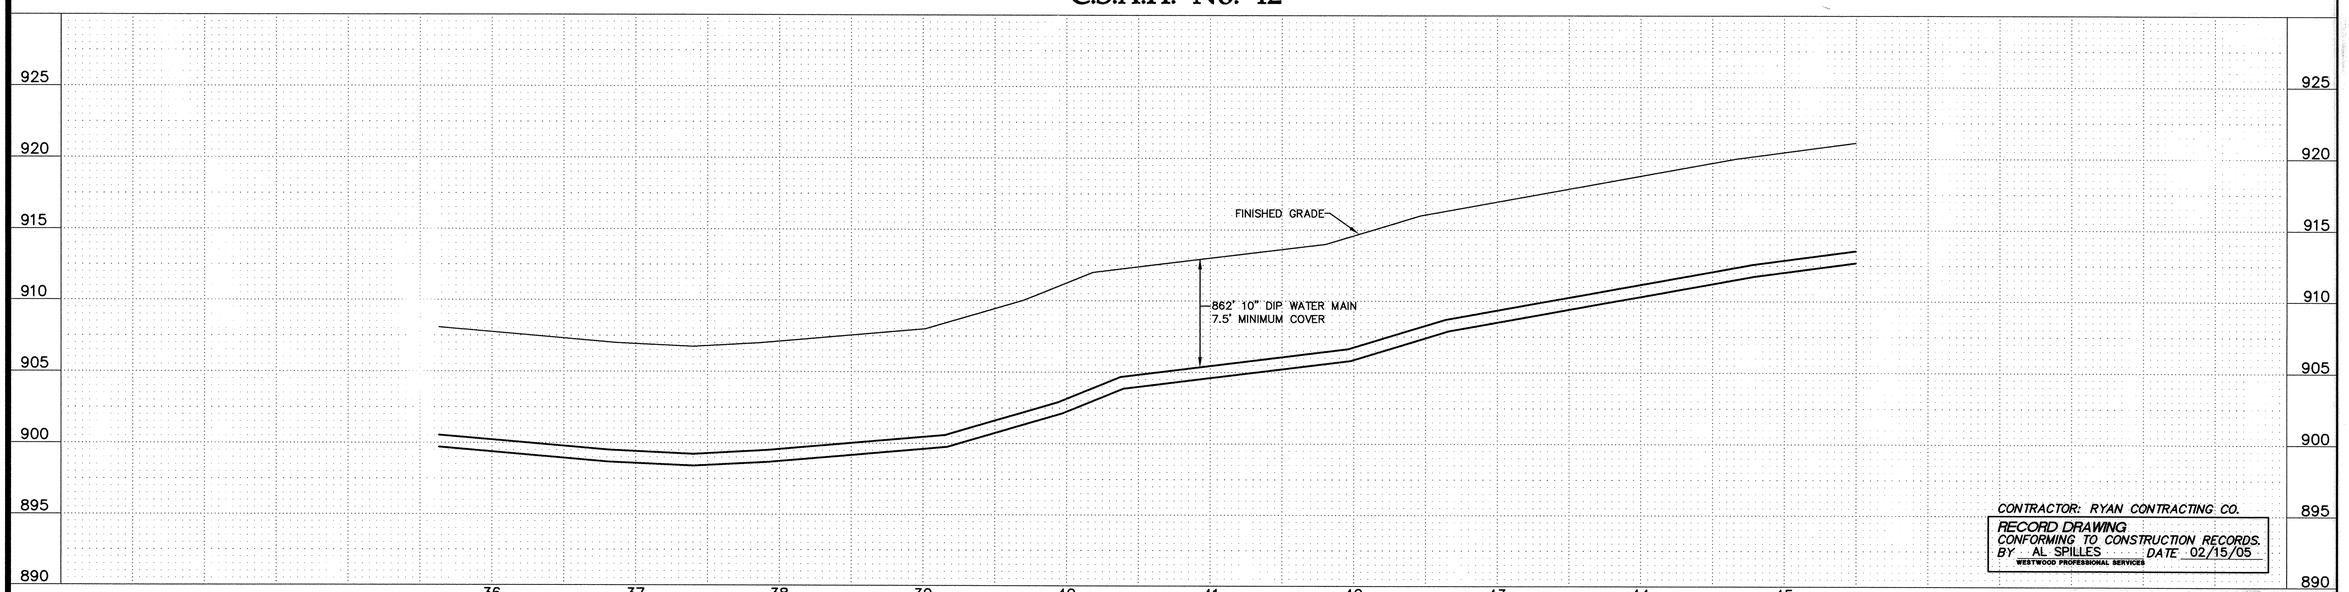

CONTRACTOR: RYAN CONTRACTING CO.

RECORD DRAWING
CONFORMING TO CONSTRUCTION RECORDS.
BY AL SPILLES DATE 02/15/05
WESTWOOD PROFESSIONAL SERVICES

LATEST REVISION DATE: 02/15/05
E-3 20011034UT@7.DWG
Date: 05/28/02 Sheet: 9 OF 21

P:\20011034\dwg\RECORD\20011034ut@7.dwg 2/14/2005 9:45:47 AM CST

Westwood Professional Services, Inc.
7599 Anagram Drive
Eden Prairie, MN 55344
Phone: 952/937-5150 Fax: 952/937-5822

I hereby certify that this plan was prepared by me or under my direct supervision and that I am a duly licensed PROFESSIONAL ENGINEER under the laws of the State of Minnesota.

Francis D. Hagen, II
Date: 02/15/05 License No. 17716

Revisions:
06/27/02 City Review-RNS
08/01/02 Add G.V.'s for Villas-RNS
06/17/04 RECORD DRAWING (AS/GKB)
02/15/05 RECORD DRAWING-CITY REVS. (GKB)

Designed: JMM/FDH, II
Checked: FDH, II
Drawn: WH/RNS
Record Drawing by/date: GKB 2/15/05

Prepared for:
D. R. Horton, Inc. - Minnesota
20860 Kenbridge Court, Suite 100
Lakeville, Minnesota 55044

Trott Brook Farms South

Elk River, Minnesota

Water Main Construction Plans
C.S.A.H. No. 12 (Sta. 36+00 to Sta. 45+00)

DRAWING NUMBER
TROTTS.02
9

SAFCO PRODUCTS • NEW HOPE, MINNESOTA
RECORDS BY PART NUMBER 63202
POSITION SIDE OF FRONT ON TRIM LINE