TWIN LAKES TOWNHOMES

PHASE III CONSTRUCTION

SANITARY SEWER, WATERMAIN, STORM SEWER AND STREET CONSTRUCTION

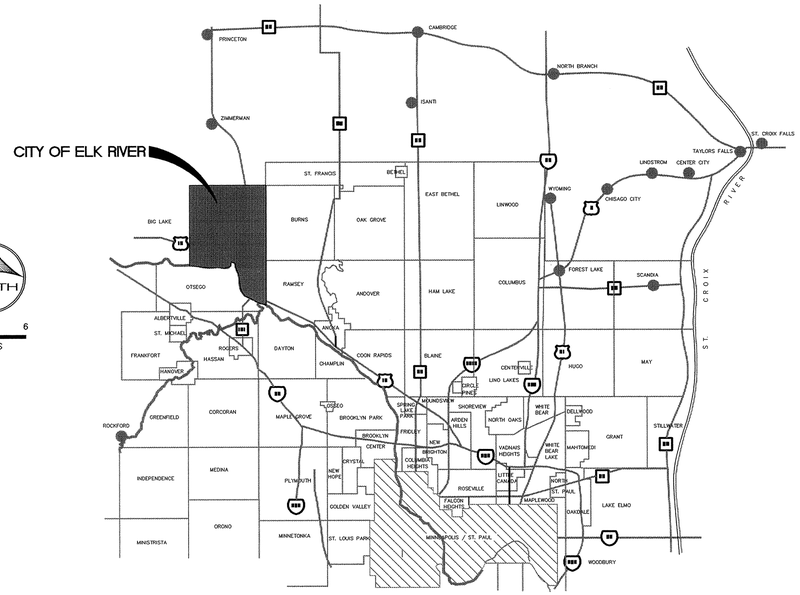

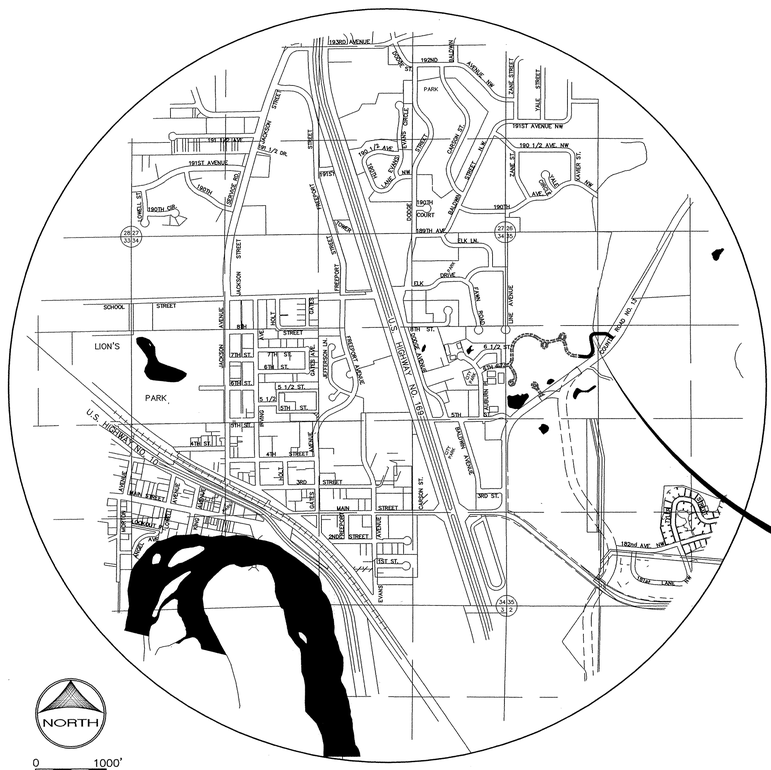

LOCATION MAP

PROJECT LOCATION

ASBUILT
RECORD PLAN
APRIL 2002

I HEREBY CERTIFY THAT THIS PLAN, SPECIFICATION, OR REPORT WAS PREPARED BY ME OR UNDER MY DIRECT SUPERVISION AND THAT I AM A DULY LICENSED PROFESSIONAL ENGINEER UNDER THE LAWS OF THE STATE OF MINNESOTA.

TERRY J. MAURER

DATE _____ LIC.NO. 15316

1326 ENERGY PARK DRIVE
ST. PAUL, MINNESOTA 55108
(651) 644-4389

Howard R. Green Company
CONSULTING ENGINEERS

PREPARED FOR:

City of Elk River

JULY 2001

SHEET 1 OF 11

April 02, 2002 12:45:42 p.m.
809783J\Phase III-Asbuilts\809783-T.DWG

DRAWING NUMBER

DRAWING NUMBER

DRAWING NUMBER
TWINL3.01
1