TWIN LAKES ESTATES
SANITARY SEWER, WATERMAIN, STORM SEWER AND STREET CONSTRUCTION PLANS
ELK RIVER, MINNESOTA

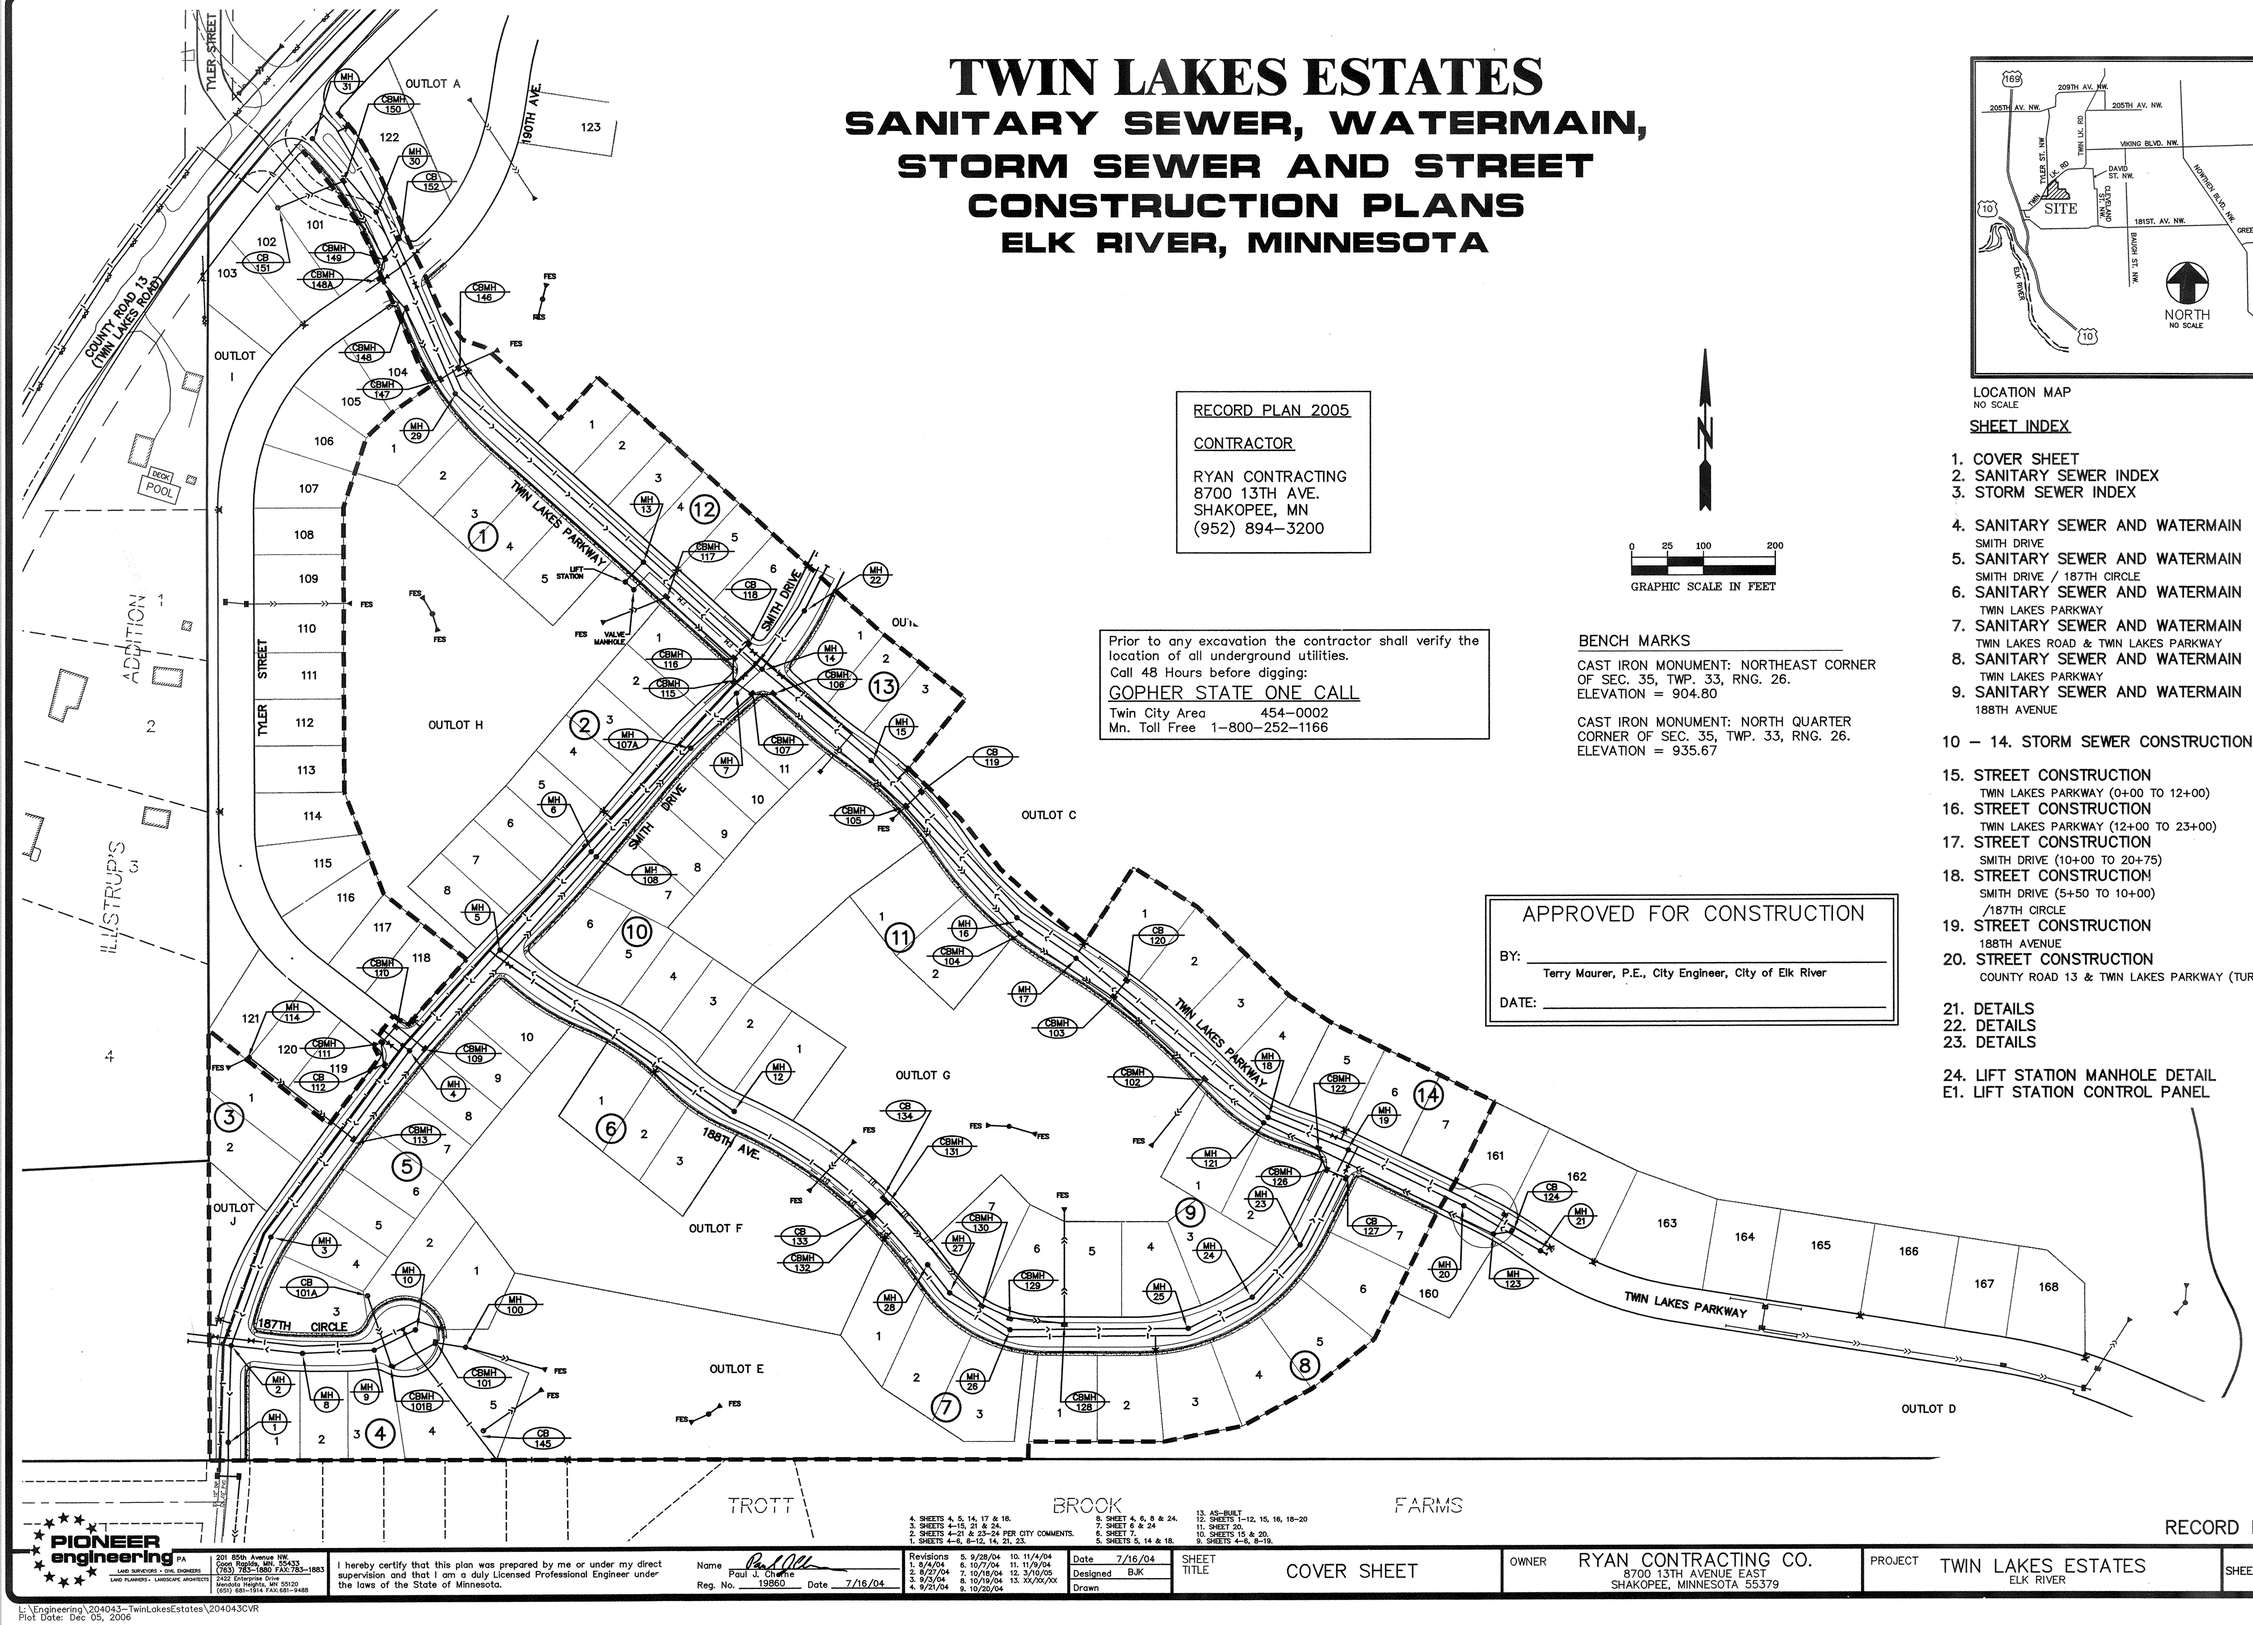
TYLER STREET
COUNTY ROAD 13 (TWIN LAKES ROAD)
OUTLOT A
190TH AVE.
OUTLOT I
OUTLOT H
OUTLOT C
OUTLOT G
OUTLOT F
OUTLOT J
OUTLOT E
OUTLOT D
TWIN LAKES PARKWAY
SMITH DRIVE
TYLER STREET
188TH AVE.
187TH CIRCLE
LIFT STATION
VALVE-MANHOLE
DECK
POOL
ADDITION
ILLSTRUP'S
TROTT BROOK FARMS
MH 31
CBMH 150
MH 30
CB 152
CB 151
CBMH 149
CBMH 148A
CBMH 146
CBMH 148
CBMH 147
MH 29
CBMH 117
CB 118
MH 22
MH 13
CBMH 116
CBMH 115
MH 14
CBMH 108
MH 15
CB 119
MH 107A
CBMH 107
MH 7
MH 6
CBMH 105
MH 108
MH 5
MH 16
CBMH 104
CB 120
MH 17
CBMH 103
MH 18
CBMH 102
CBMH 122
MH 19
CB 134
CBMH 131
MH 12
CBMH 111
CB 112
CBMH 109
MH 4
CBMH 113
CBMH 110
MH 114
MH 3
CB 101A
MH 10
MH 100
CBMH 101
CBMH 101B
MH 2
MH 8
MH 9
MH 1
CB 145
CB 133
CBMH 132
CBMH 130
MH 27
CBMH 129
MH 28
MH 26
CBMH 128
MH 25
MH 24
CB 127
CBMH 126
MH 23
CB 124
MH 21
MH 20
MH 123
