TYLER STREET

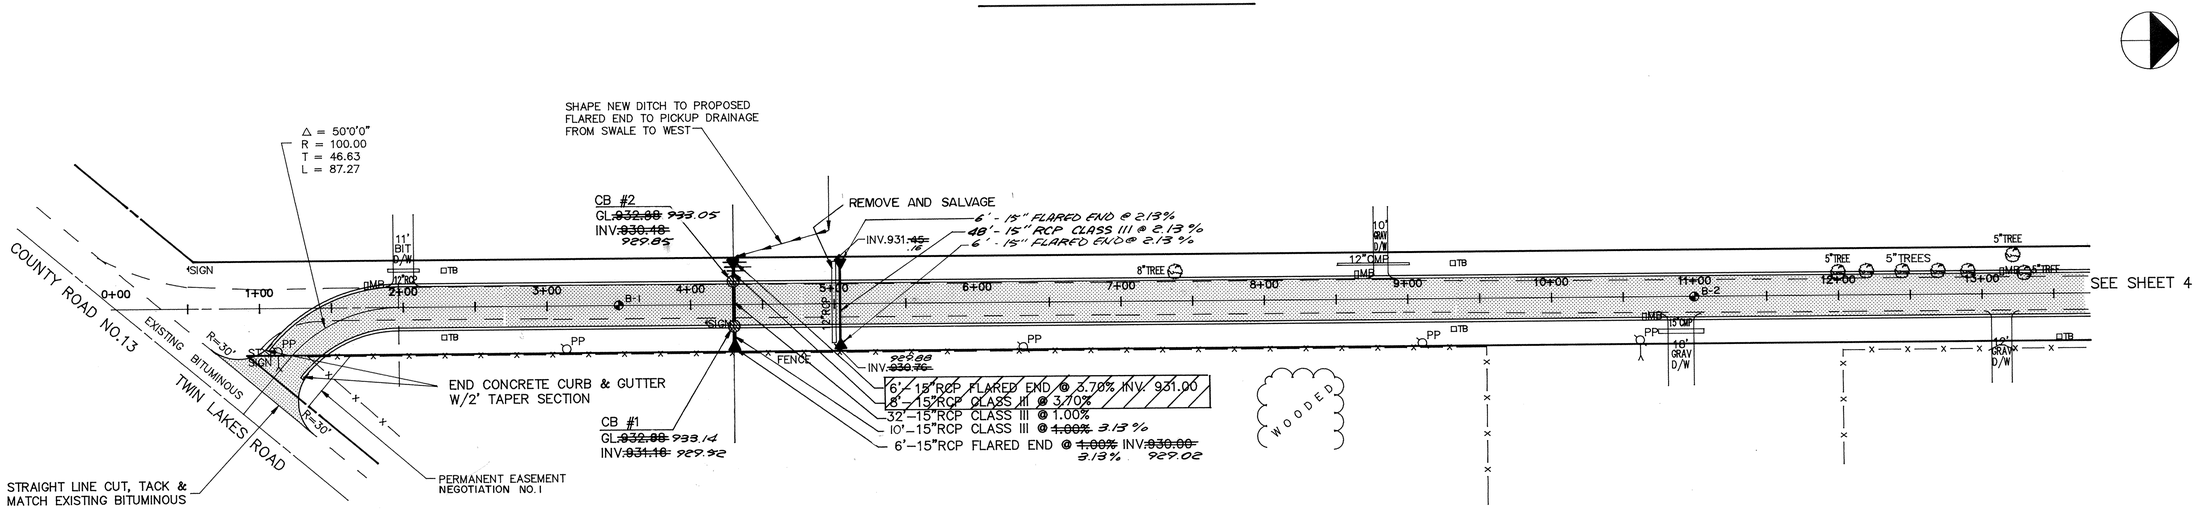

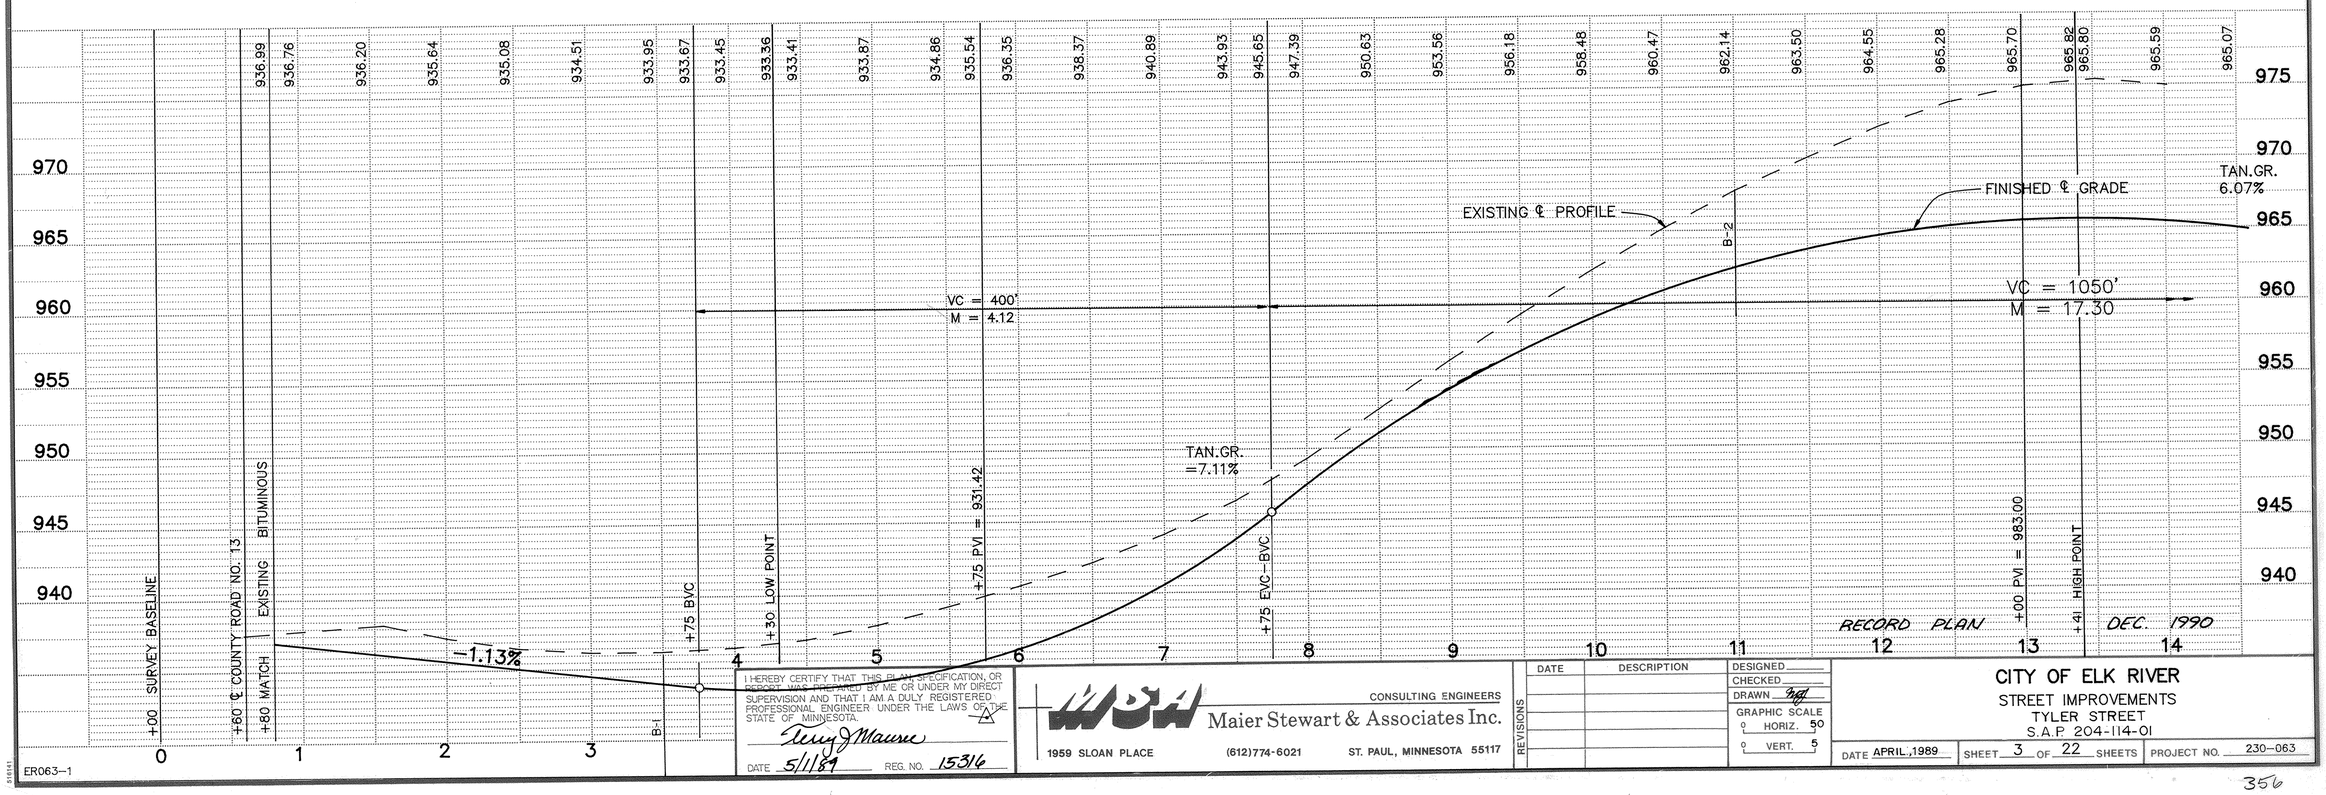

I HEREBY CERTIFY THAT THIS PLAN, SPECIFICATION, OR REPORT WAS PREPARED BY ME OR UNDER MY DIRECT SUPERVISION AND THAT I AM A DULY REGISTERED PROFESSIONAL ENGINEER UNDER THE LAWS OF THE STATE OF MINNESOTA.

Terry J. Maurer

DATE 5/1189 REG. NO. 15316

MSA Maier Stewart & Associates Inc. CONSULTING ENGINEERS

1959 SLOAN PLACE (612)774-6021 ST. PAUL, MINNESOTA 55117

REVISIONS	DATE	DESCRIPTION

DESIGNED
CHECKED
DRAWN MJP
GRAPHIC SCALE
HORIZ. 50
VERT. 5

CITY OF ELK RIVER
STREET IMPROVEMENTS
TYLER STREET
S.A.P. 204-114-01

DATE APRIL, 1989 SHEET 3 OF 22 SHEETS PROJECT NO. 230-063

ER063-1

356

DRAWING NUMBER

SAFCO PRODUCTS • NEW HOPE, MINNESOTA
REORDER BY PART NUMBER 6582

DRAWING NUMBER
TYLER 90
3