
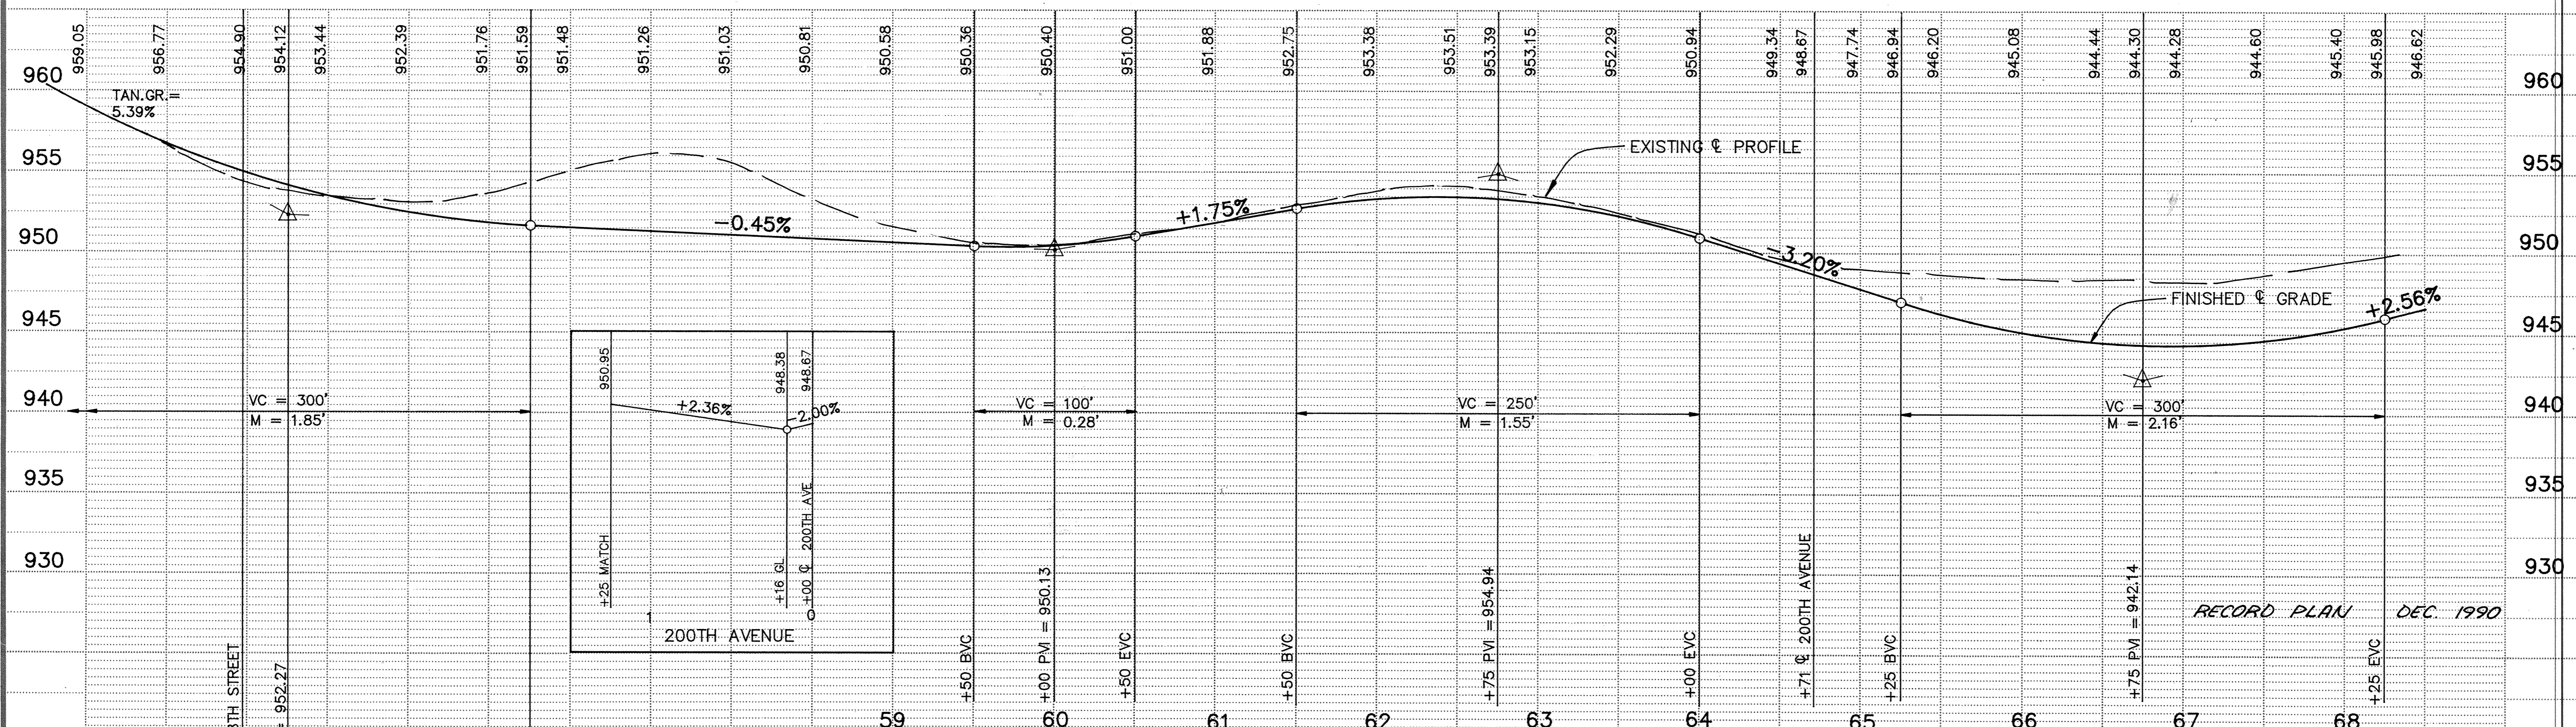


TYLER STREET

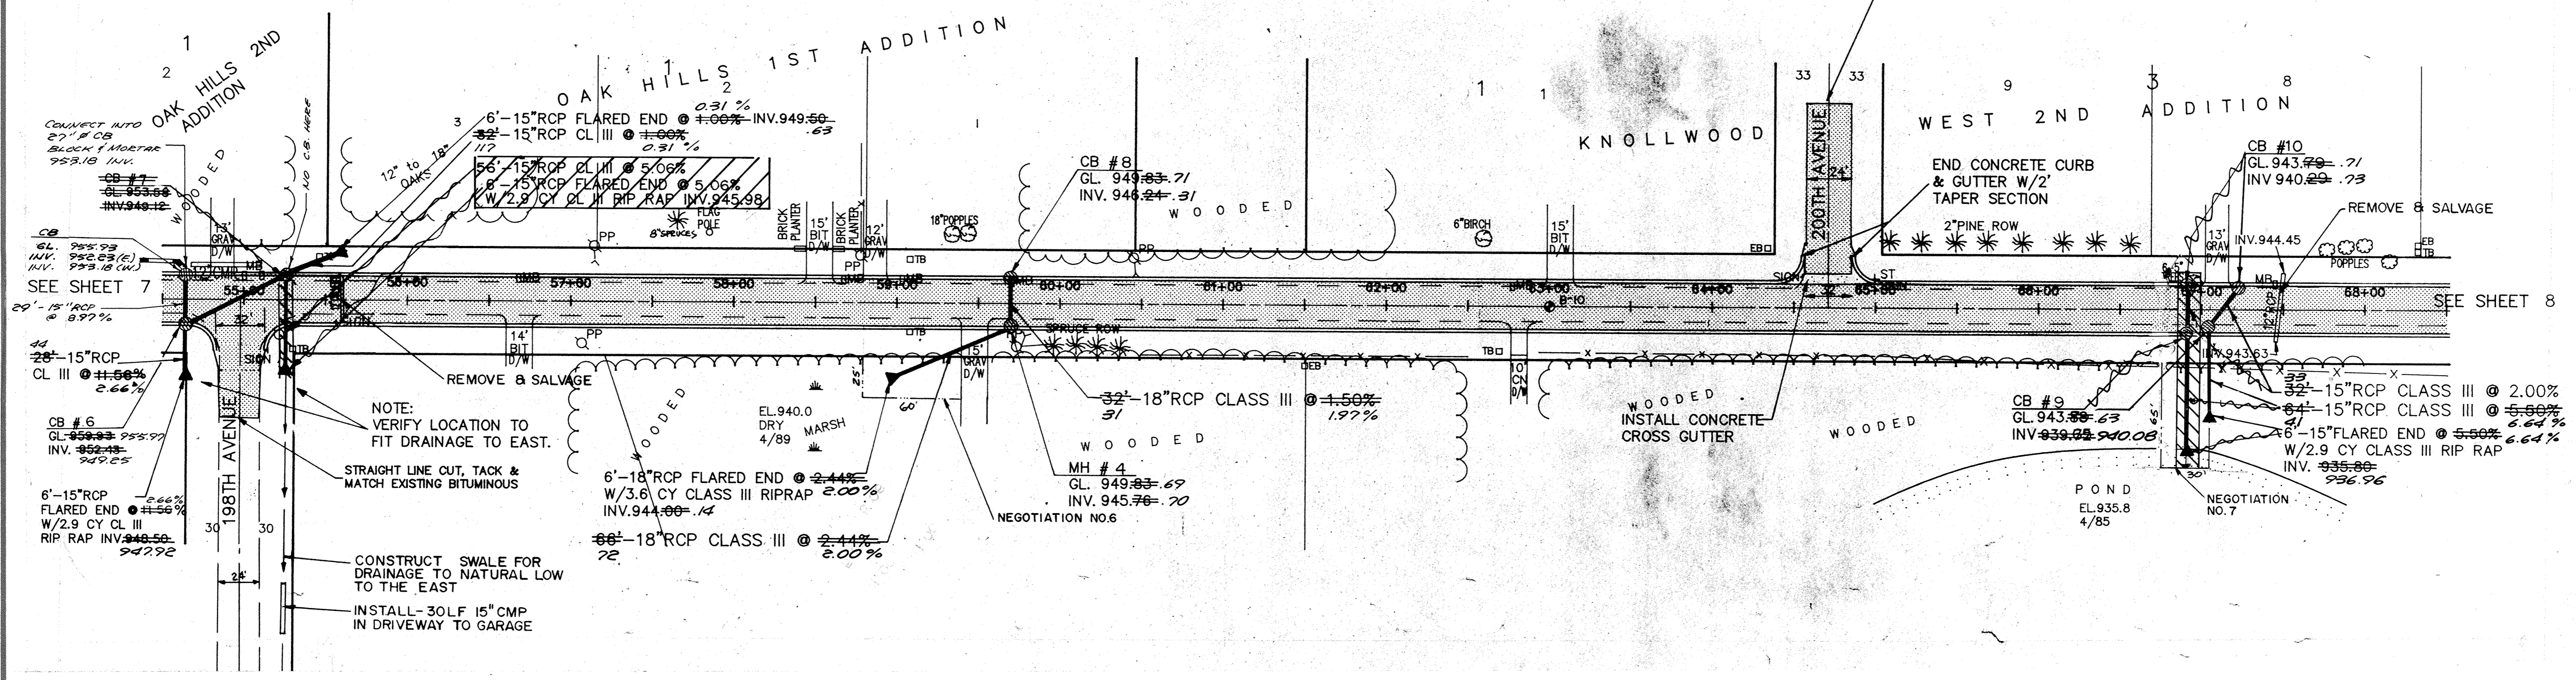

I HEREBY CERTIFY THAT THIS PLAN, SPECIFICATION, OR REPORT WAS PREPARED BY ME OR UNDER MY DIRECT SUPERVISION AND THAT I AM A DULY REGISTERED PROFESSIONAL ENGINEER UNDER THE LAWS OF THE STATE OF MINNESOTA.

DATE _____ REG. NO. _____

Maier Stewart & Associates Inc.
 CONSULTING ENGINEERS
 1959 SLOAN PLACE (612) 774-6021 ST. PAUL, MINNESOTA 55117

DATE	DESCRIPTION	DESIGNED	CHECKED
7/5/89	STREET GRADES		
REVISIONS	DATE	DESCRIPTION	BY

CITY OF ELK RIVER
 STREET IMPROVEMENTS
 TYLER STREET
 SAP 204-114-01

DATE APRIL, 1989 SHEET 7 OF 22 SHEETS PROJECT NO. 230-063

DRAWING NUMBER
 TYLER 90
 350