



SDCO PRODUCTS • NEW HOPE, PENNSYLVANIA
REORDER BY PART NUMBER 8552

SDCO PRODUCTS • NEW HOPE, PENNSYLVANIA
REORDER BY PART NUMBER 8552

SDCO PRODUCTS • NEW HOPE, PENNSYLVANIA
REORDER BY PART NUMBER 8552

SDCO PRODUCTS • NEW HOPE, PENNSYLVANIA
REORDER BY PART NUMBER 8552

STATION	AREAS in SQ FT		VOLUMES in CU. YDS.	
	CUT	FILL	CUT	FILL
6+00	166	31	286	109
6+50	143	87	247	165
7+00	124	91	213	194
7+50	106	118	178	226
8+00	86	126	182	117
8+50	111	0	221	0
9+00	128	0	248	0
9+50	140	0	295	0
10+00	178	0	365	0
10+50	216	0	443	0
11+00	262	0	532	0
11+50	313	0	705	0
12+00	449	0	962	0
12+50	589	0	4877	811

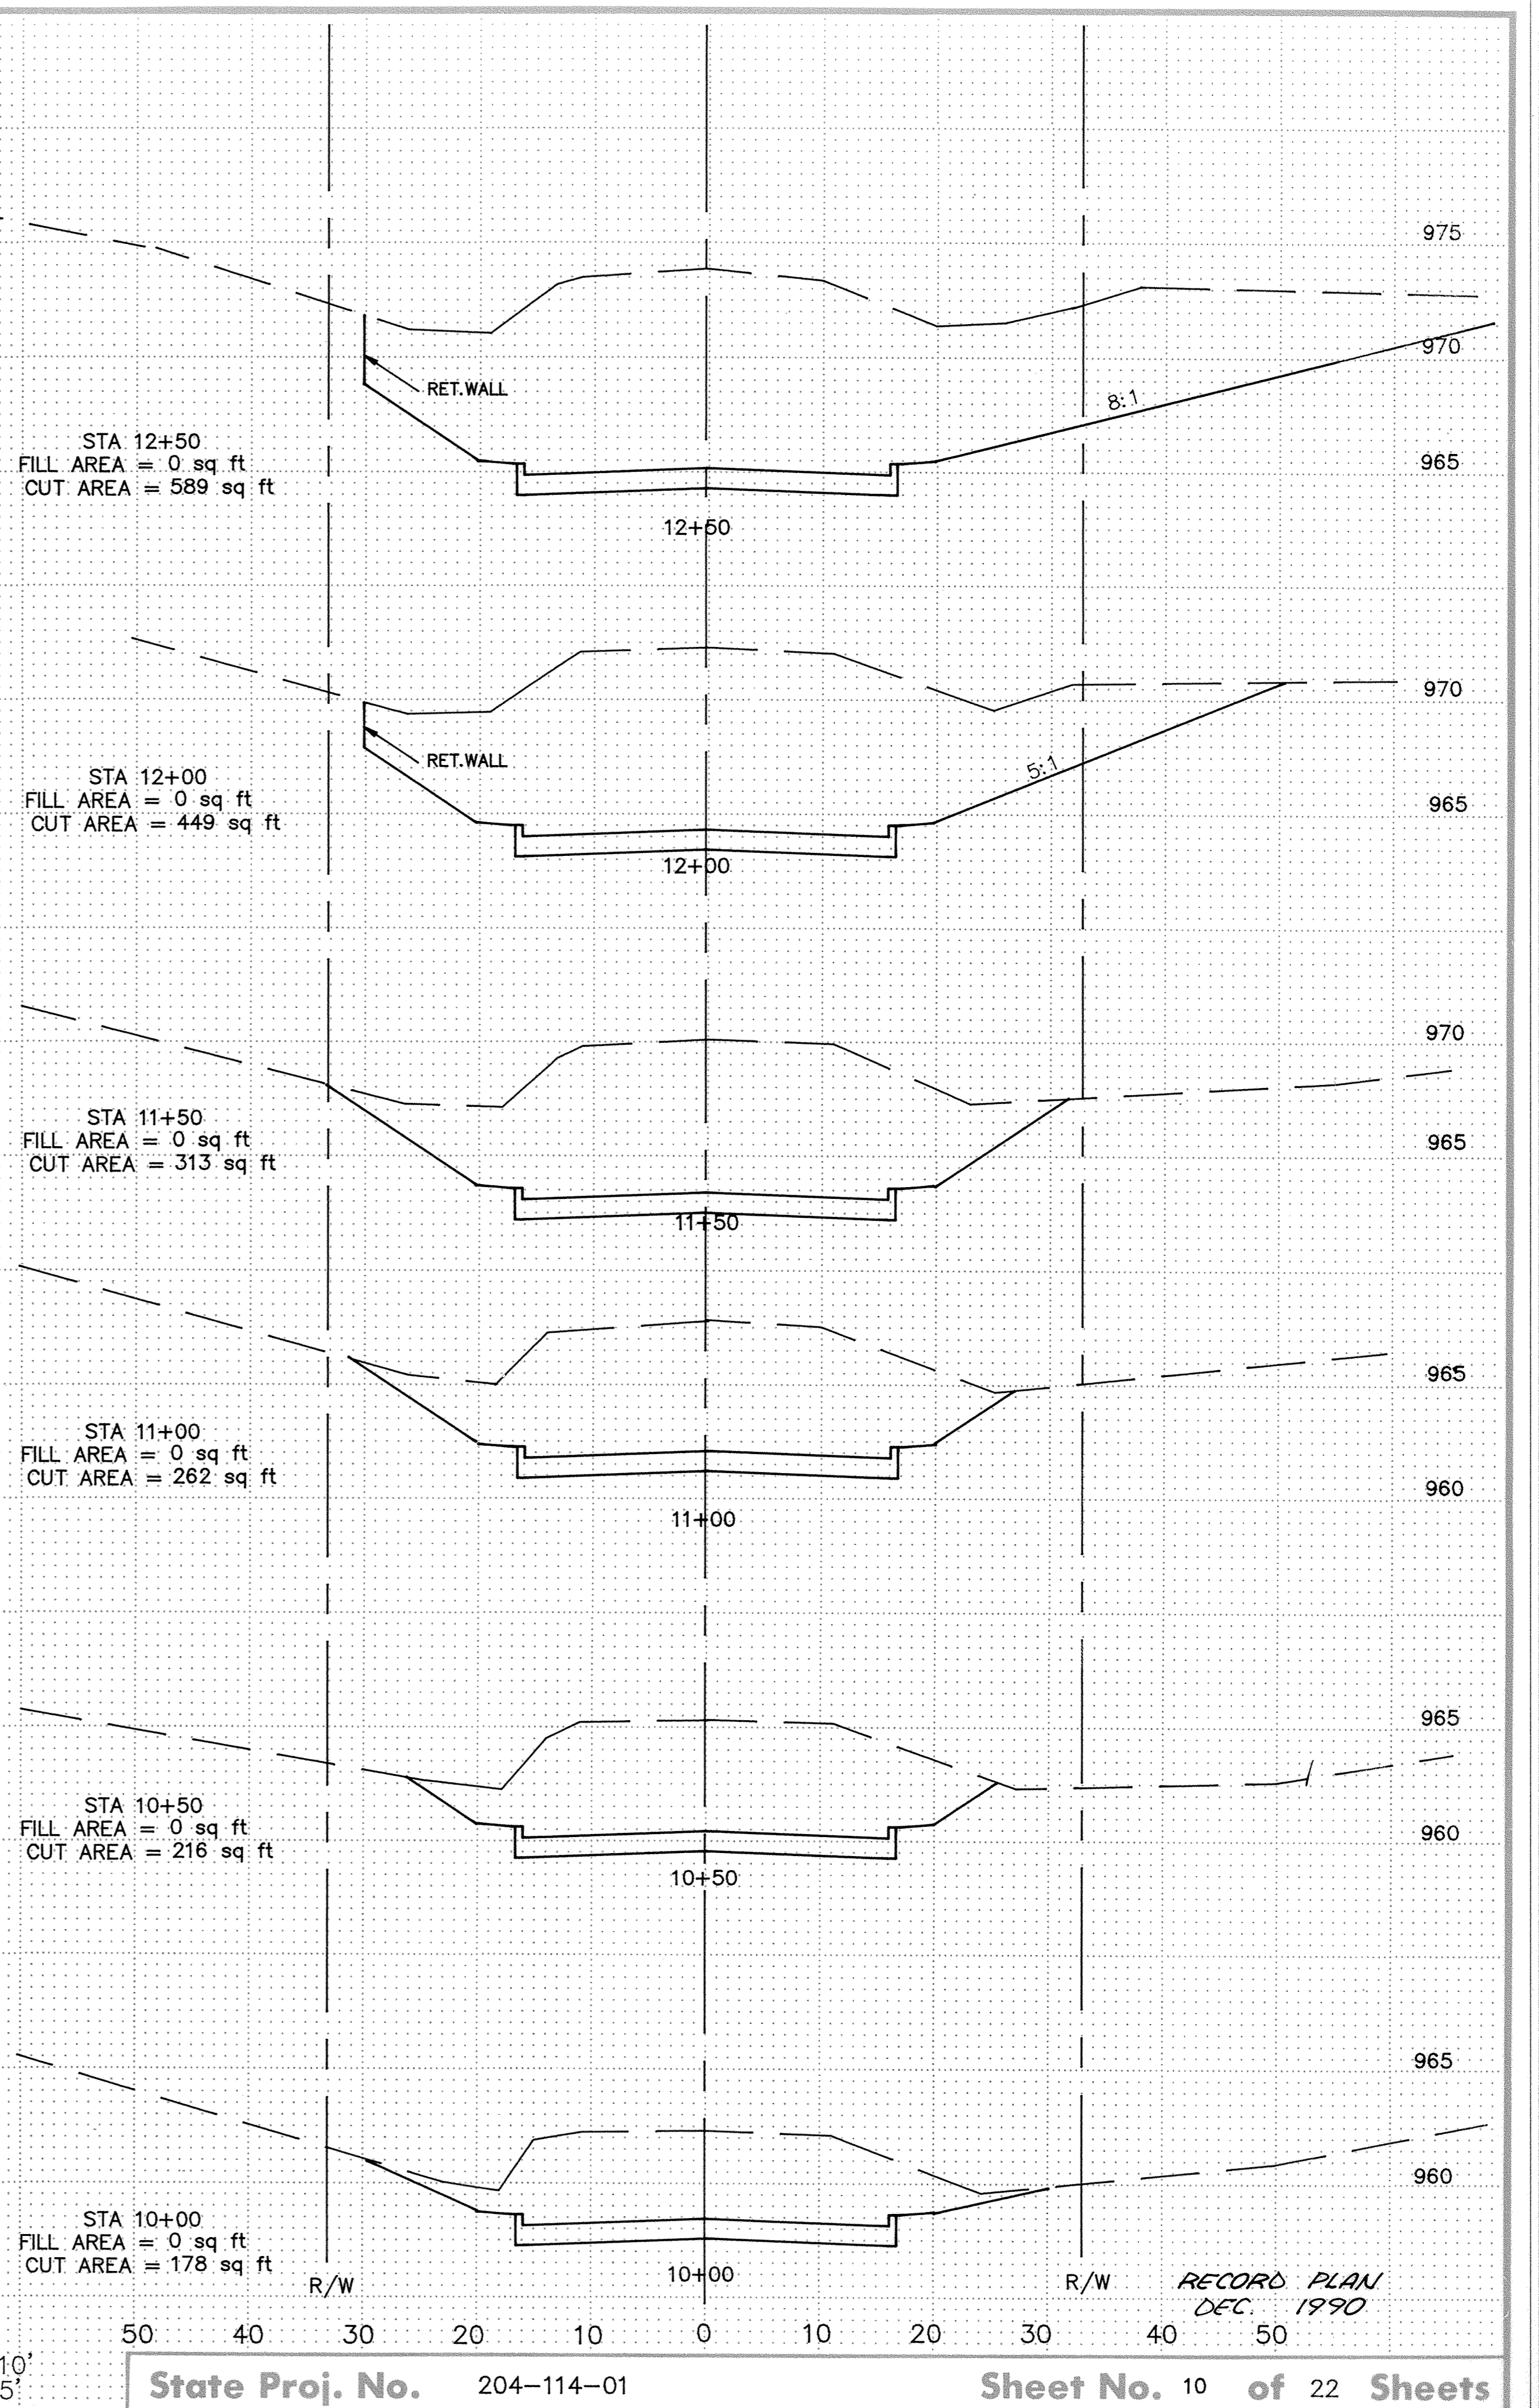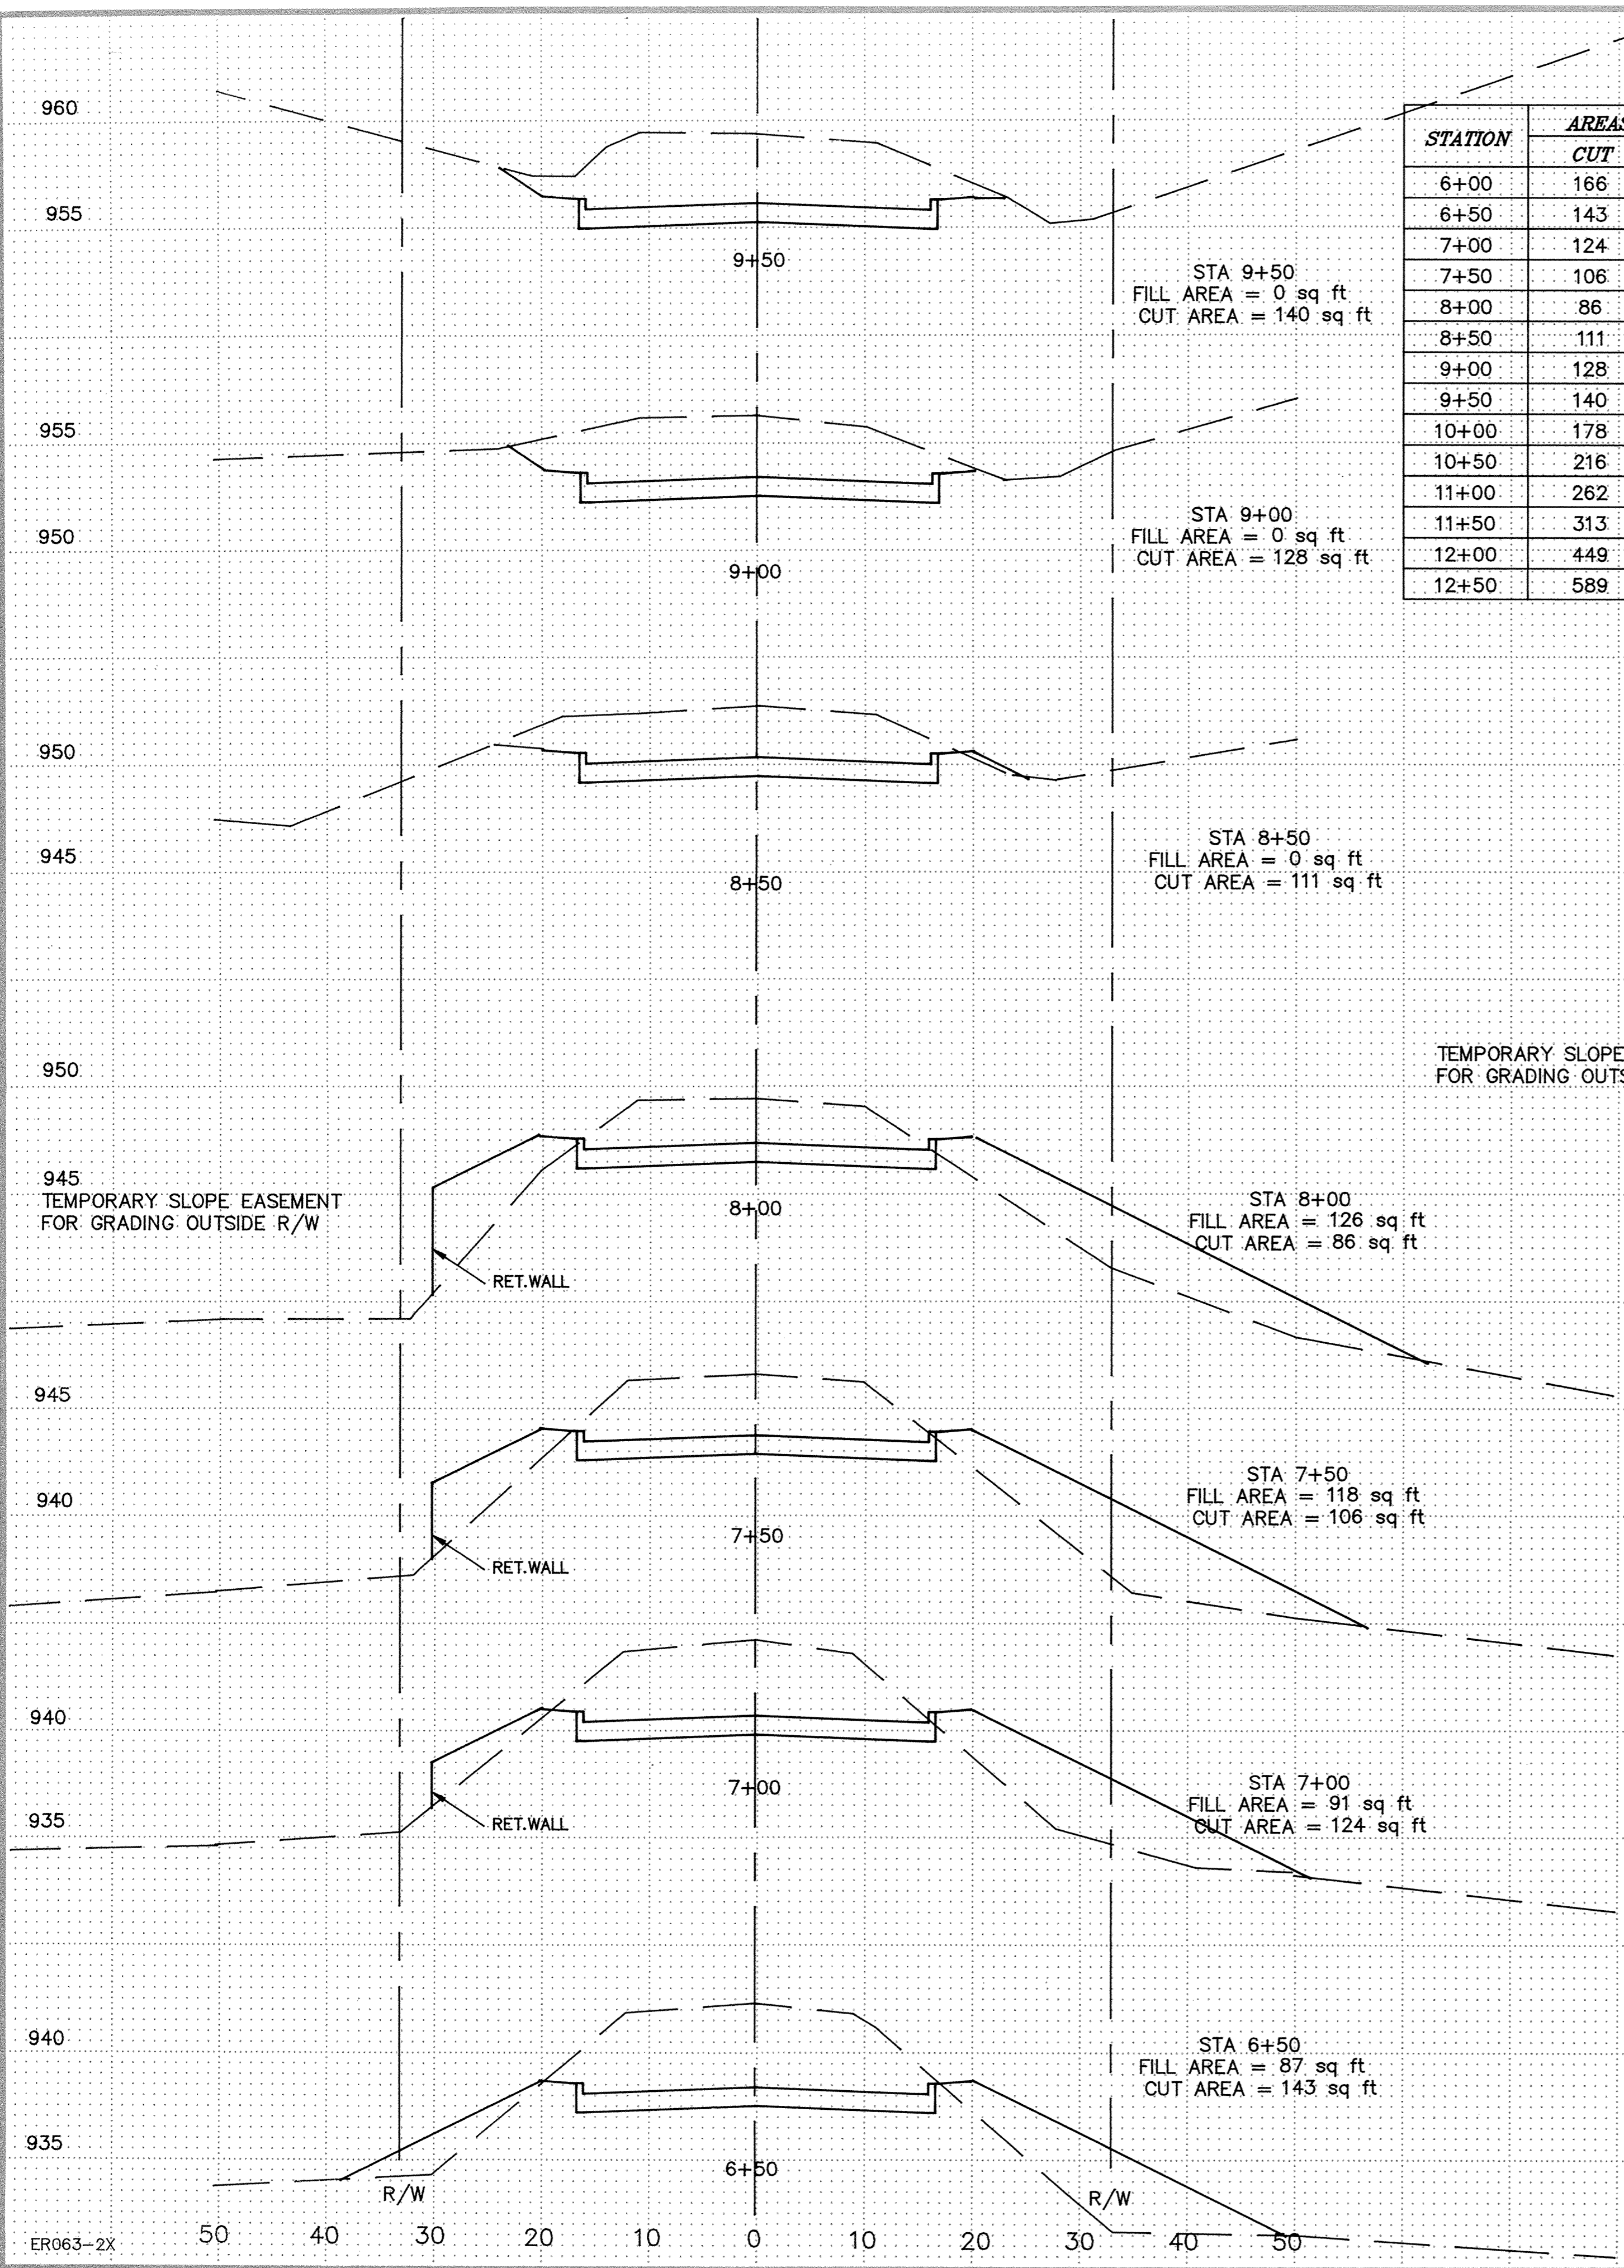

ER063-2X

Scale: Horiz. 1"=10'
Vert. 1"=5'

State Proj. No. 204-114-01

Sheet No. 10 of 22 Sheets