


SDC PRODUCTS • NEW HOPE, MINNESOTA
REVISION BY PART NUMBER 8592

SDC PRODUCTS • NEW HOPE, MINNESOTA
REVISION BY PART NUMBER 8592

SDC PRODUCTS • NEW HOPE, MINNESOTA
REVISION BY PART NUMBER 8592

SDC PRODUCTS • NEW HOPE, MINNESOTA
REVISION BY PART NUMBER 8592

STATION	AREAS in SQ FT		VOLUMES in CU. YDS.	
	CUT	FILL	CUT	FILL
12+50	589	0	1168	0
13+00	673	0	1257	0
13+50	684	0	1337	0
14+00	759	0	1241	0
14+50	581	0	1118	0
15+00	627	0	1003	0
15+50	457	0	782	10
16+00	388	11	567	52
16+50	225	45	340	73
17+00	143	34	171	117
17+50	42	93	55	149
18+00	17	68	9038	401

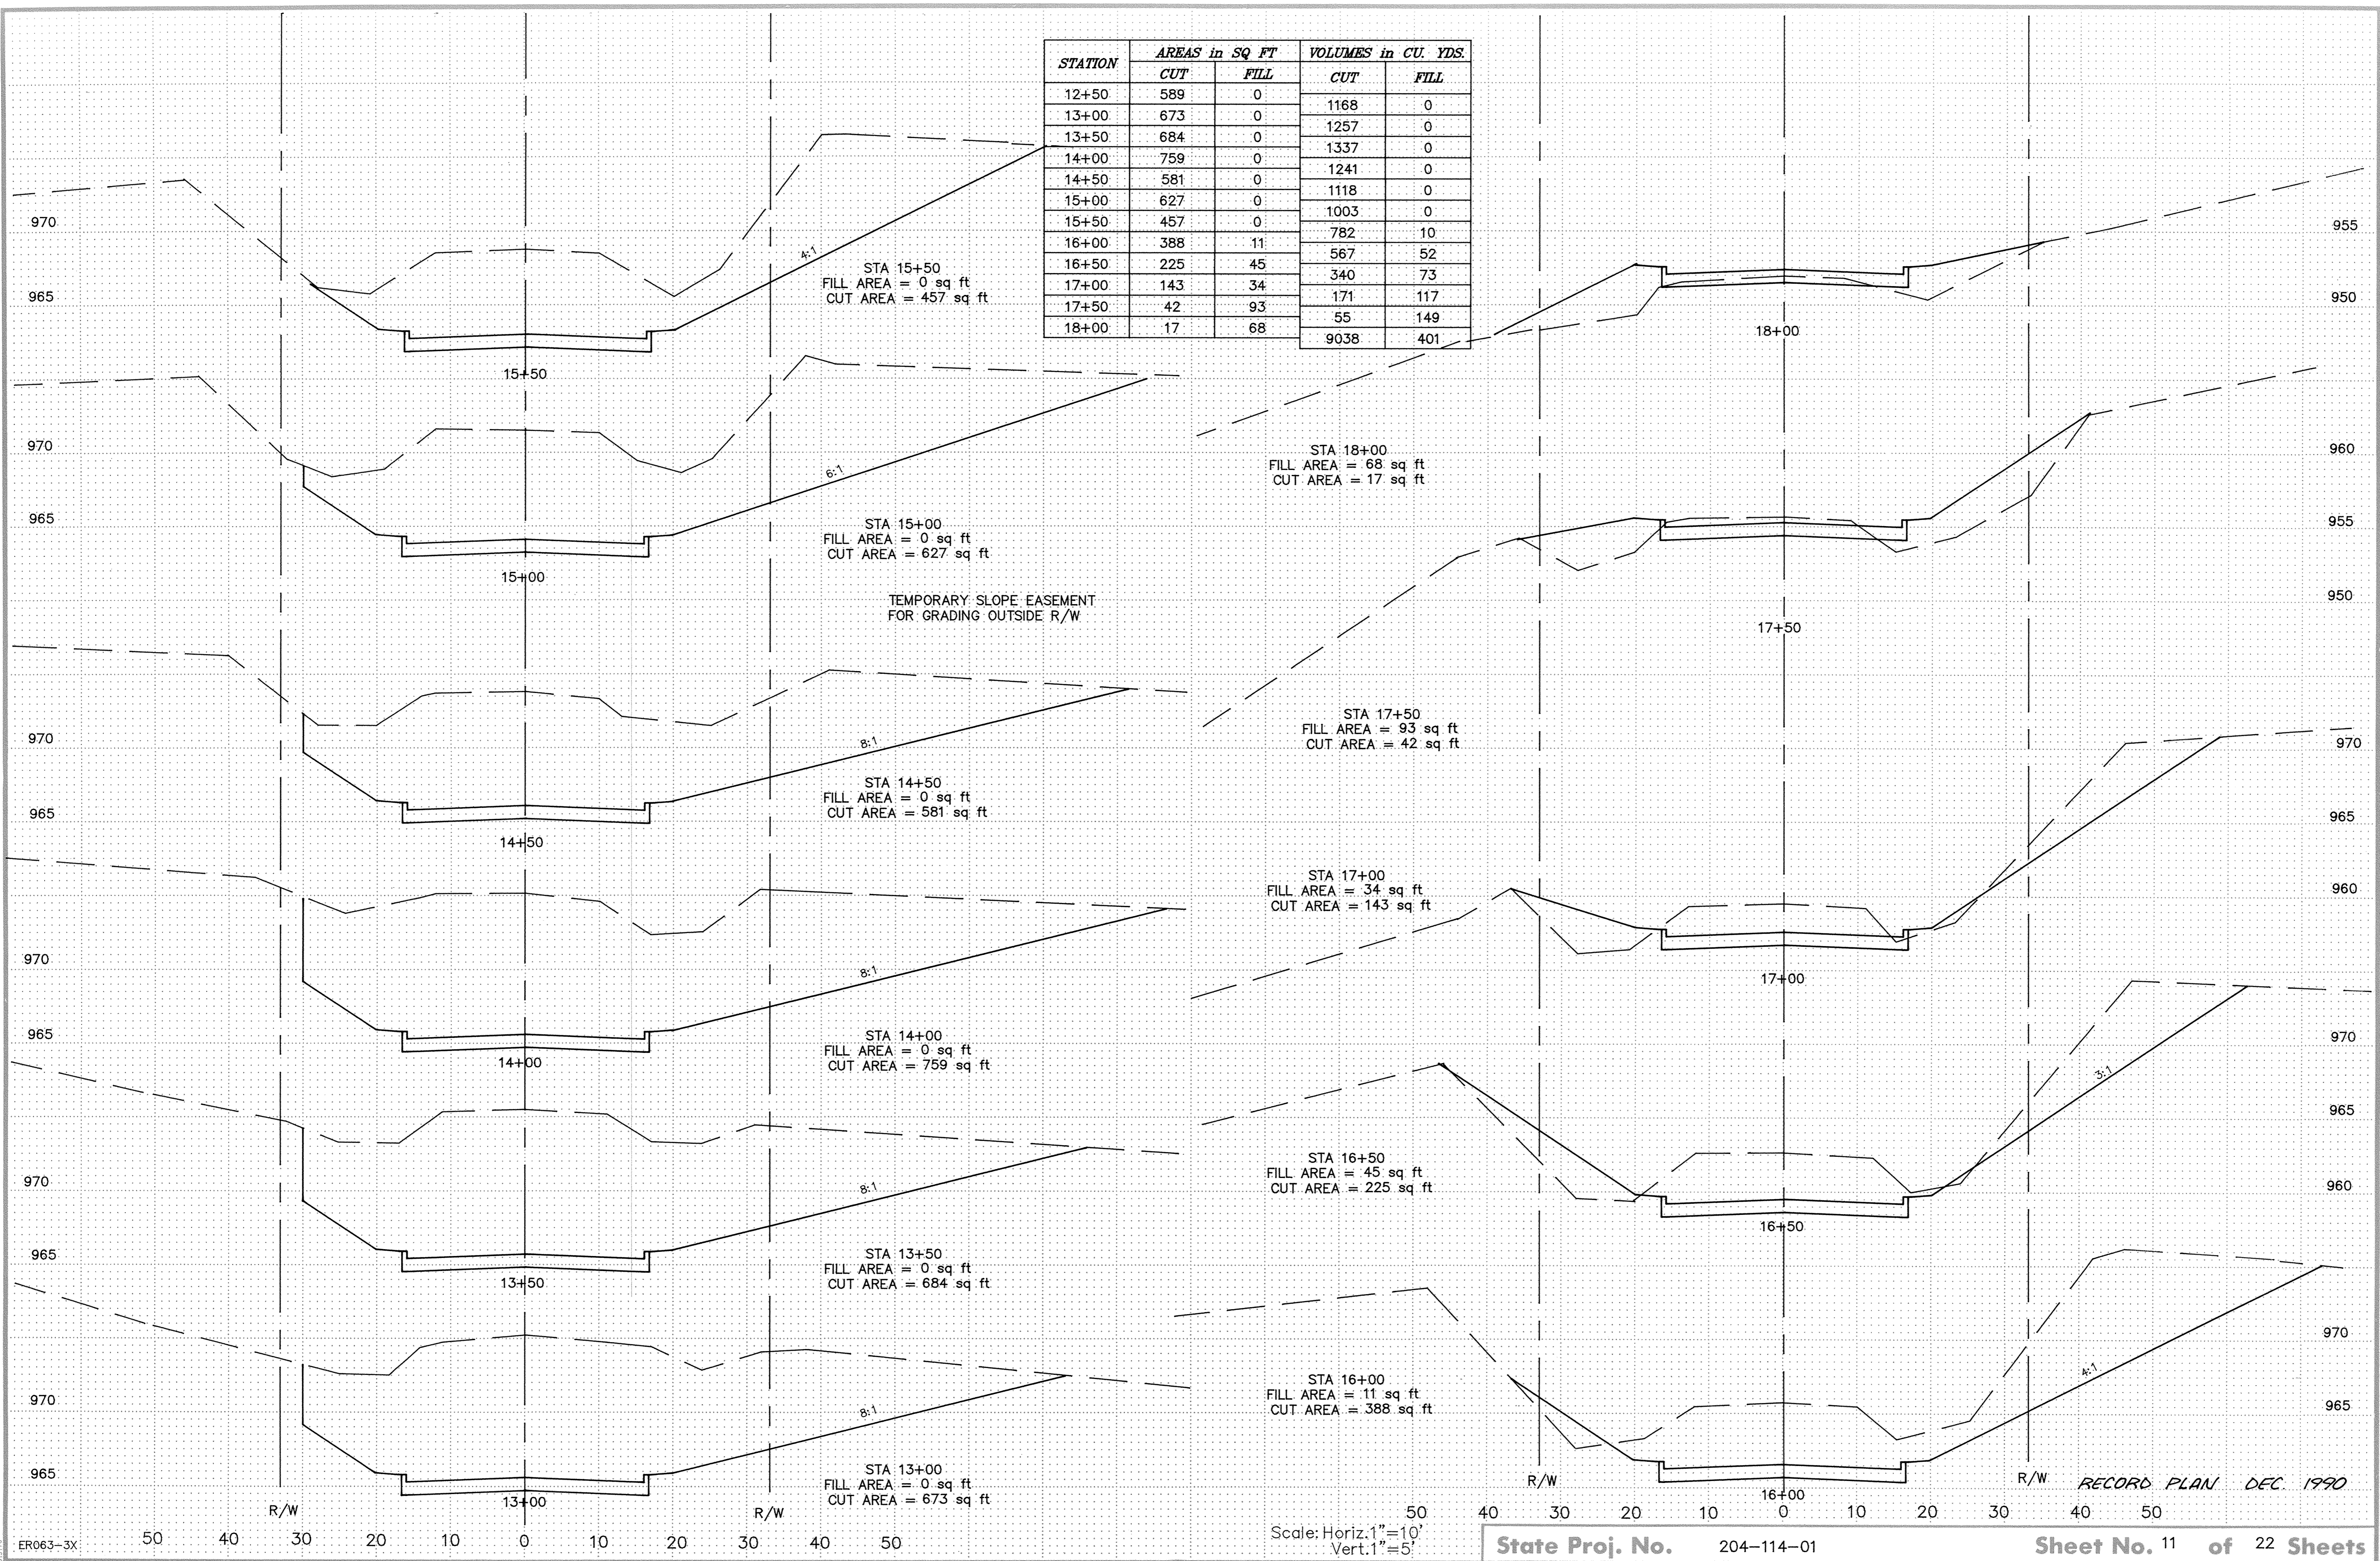

STA 15+50
 FILL AREA = 0 sq ft
 CUT AREA = 457 sq ft

STA 15+00
 FILL AREA = 0 sq ft
 CUT AREA = 627 sq ft

TEMPORARY SLOPE EASEMENT
 FOR GRADING OUTSIDE R/W

STA 14+50
 FILL AREA = 0 sq ft
 CUT AREA = 581 sq ft

STA 14+00
 FILL AREA = 0 sq ft
 CUT AREA = 759 sq ft

STA 13+50
 FILL AREA = 0 sq ft
 CUT AREA = 684 sq ft

STA 13+00
 FILL AREA = 0 sq ft
 CUT AREA = 673 sq ft

STA 18+00
 FILL AREA = 68 sq ft
 CUT AREA = 17 sq ft

STA 17+50
 FILL AREA = 93 sq ft
 CUT AREA = 42 sq ft

STA 17+00
 FILL AREA = 34 sq ft
 CUT AREA = 143 sq ft

STA 16+50
 FILL AREA = 45 sq ft
 CUT AREA = 225 sq ft

STA 16+00
 FILL AREA = 11 sq ft
 CUT AREA = 388 sq ft

Scale: Horiz. 1" = 10'
 Vert. 1" = 5'