
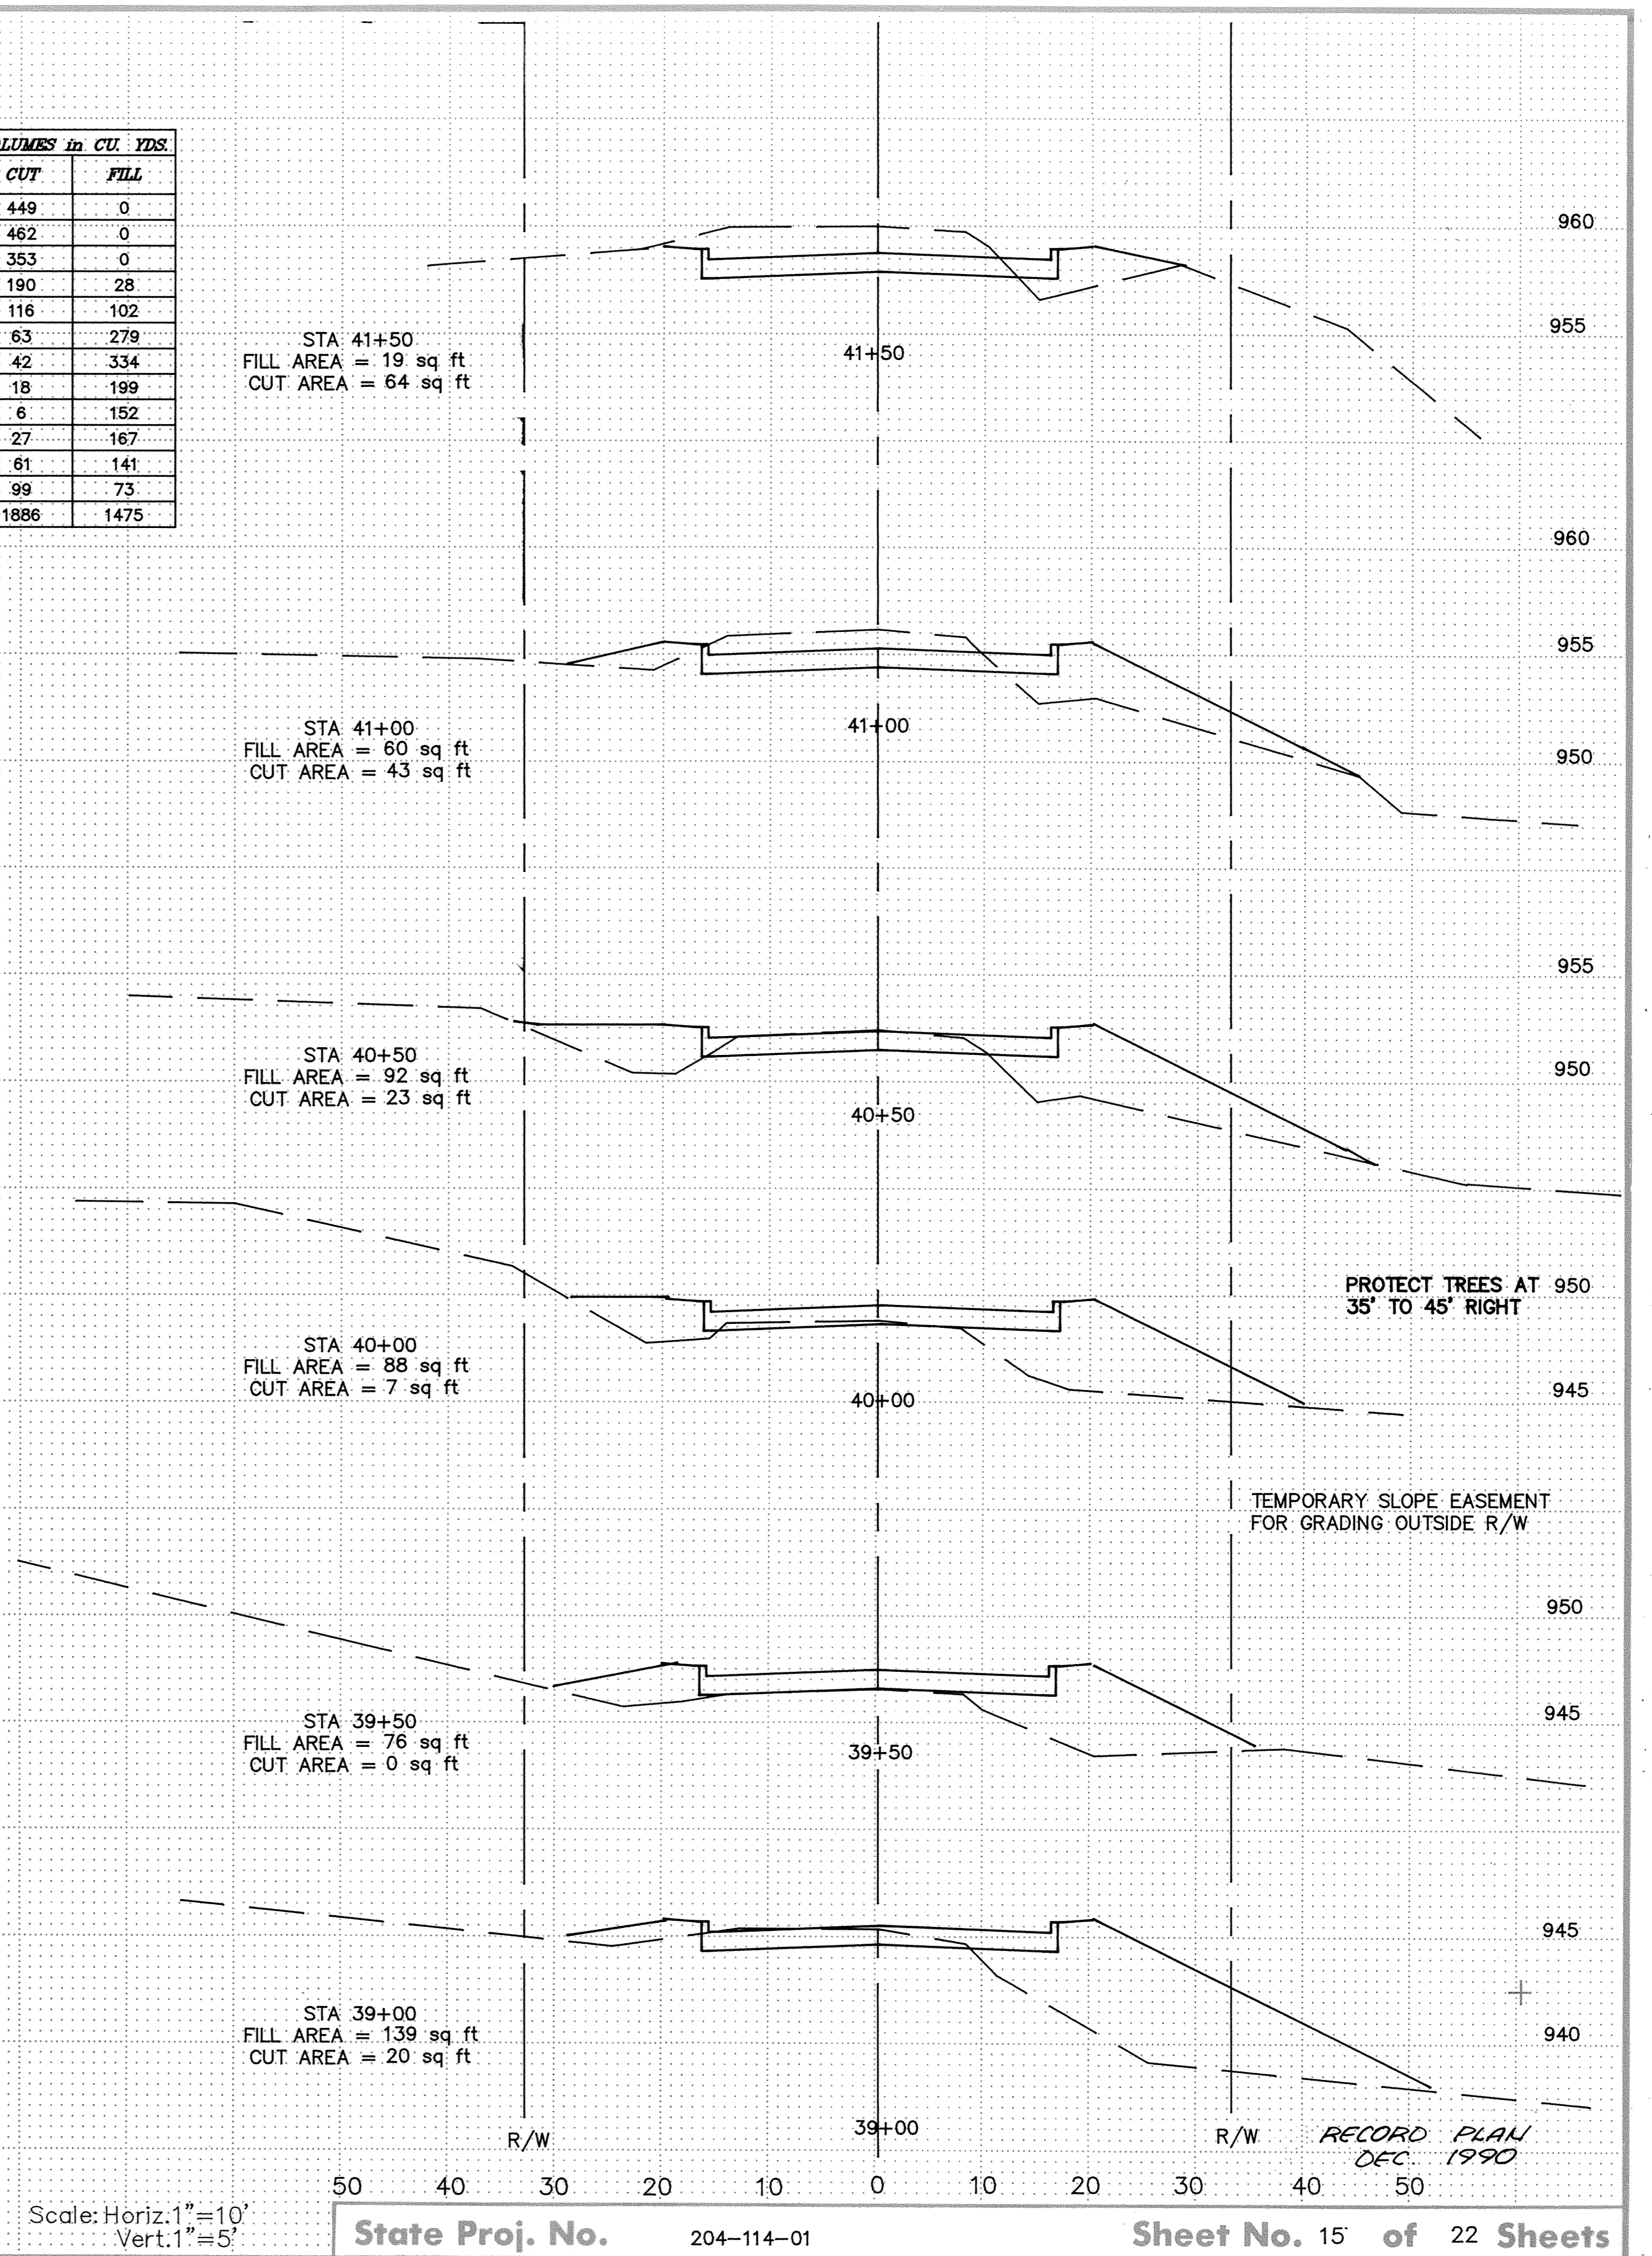



STATION	AREAS in SQ. FT.		VOLUMES in CU. YDS.	
	CUT	FILL	CUT	FILL
35+50	243	0	449	0
36+00	241	0	462	0
36+50	258	0	462	0
37+00	123	0	353	0
37+50	83	31	190	28
38+00	42	80	116	102
38+50	25	222	63	279
39+00	20	139	42	334
39+50	0	76	18	199
40+00	7	88	6	152
40+50	23	92	27	167
41+00	43	60	61	141
41+50	64	19	99	73
			1886	1475

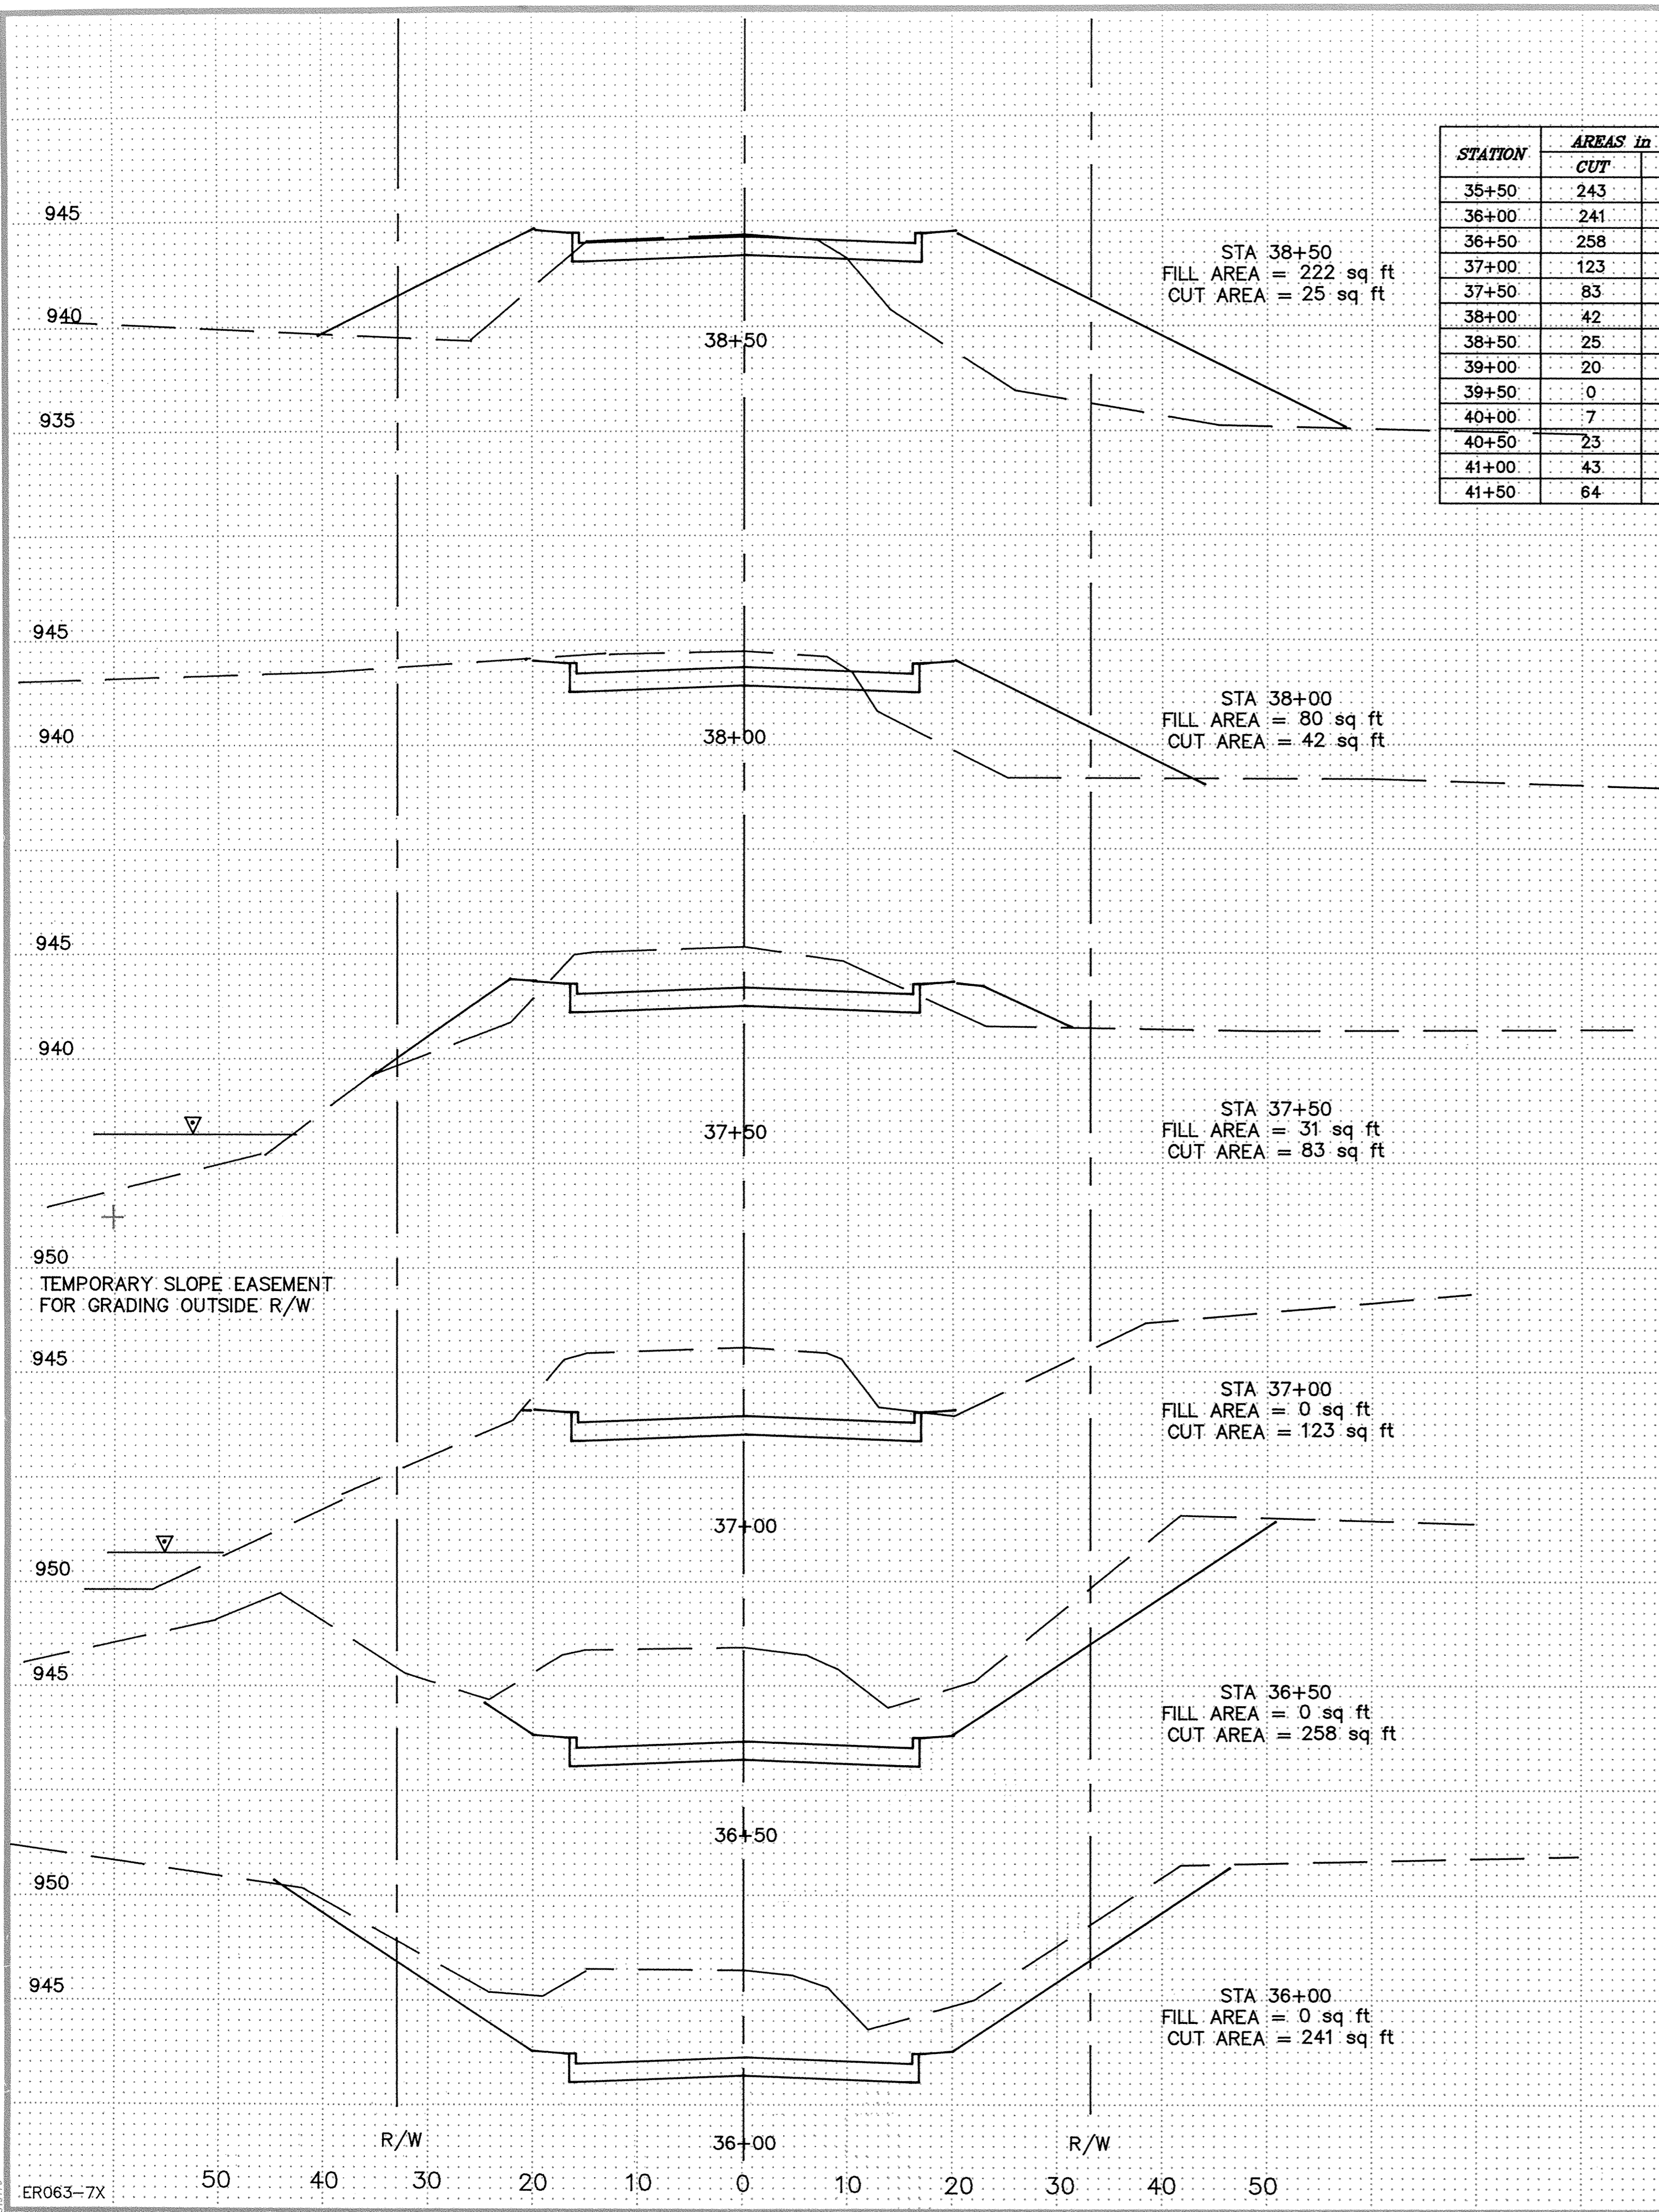

ER063-7X

Scale: Horiz. 1"=10'
Vert. 1"=5'

State Proj. No. 204-114-01

Sheet No. 15 of 22 Sheets

340