


STATION	AREAS in SQ FT		VOLUMES in CU. YDS.	
	CUT	FILL	CUT	FILL
41+50	64	19	227	18
42+00	181	0	232	8
42+50	69	8	152	1017
43+50	13	541	12	1286
44+00	0	848	0	1668
44+50	0	953	622	3995

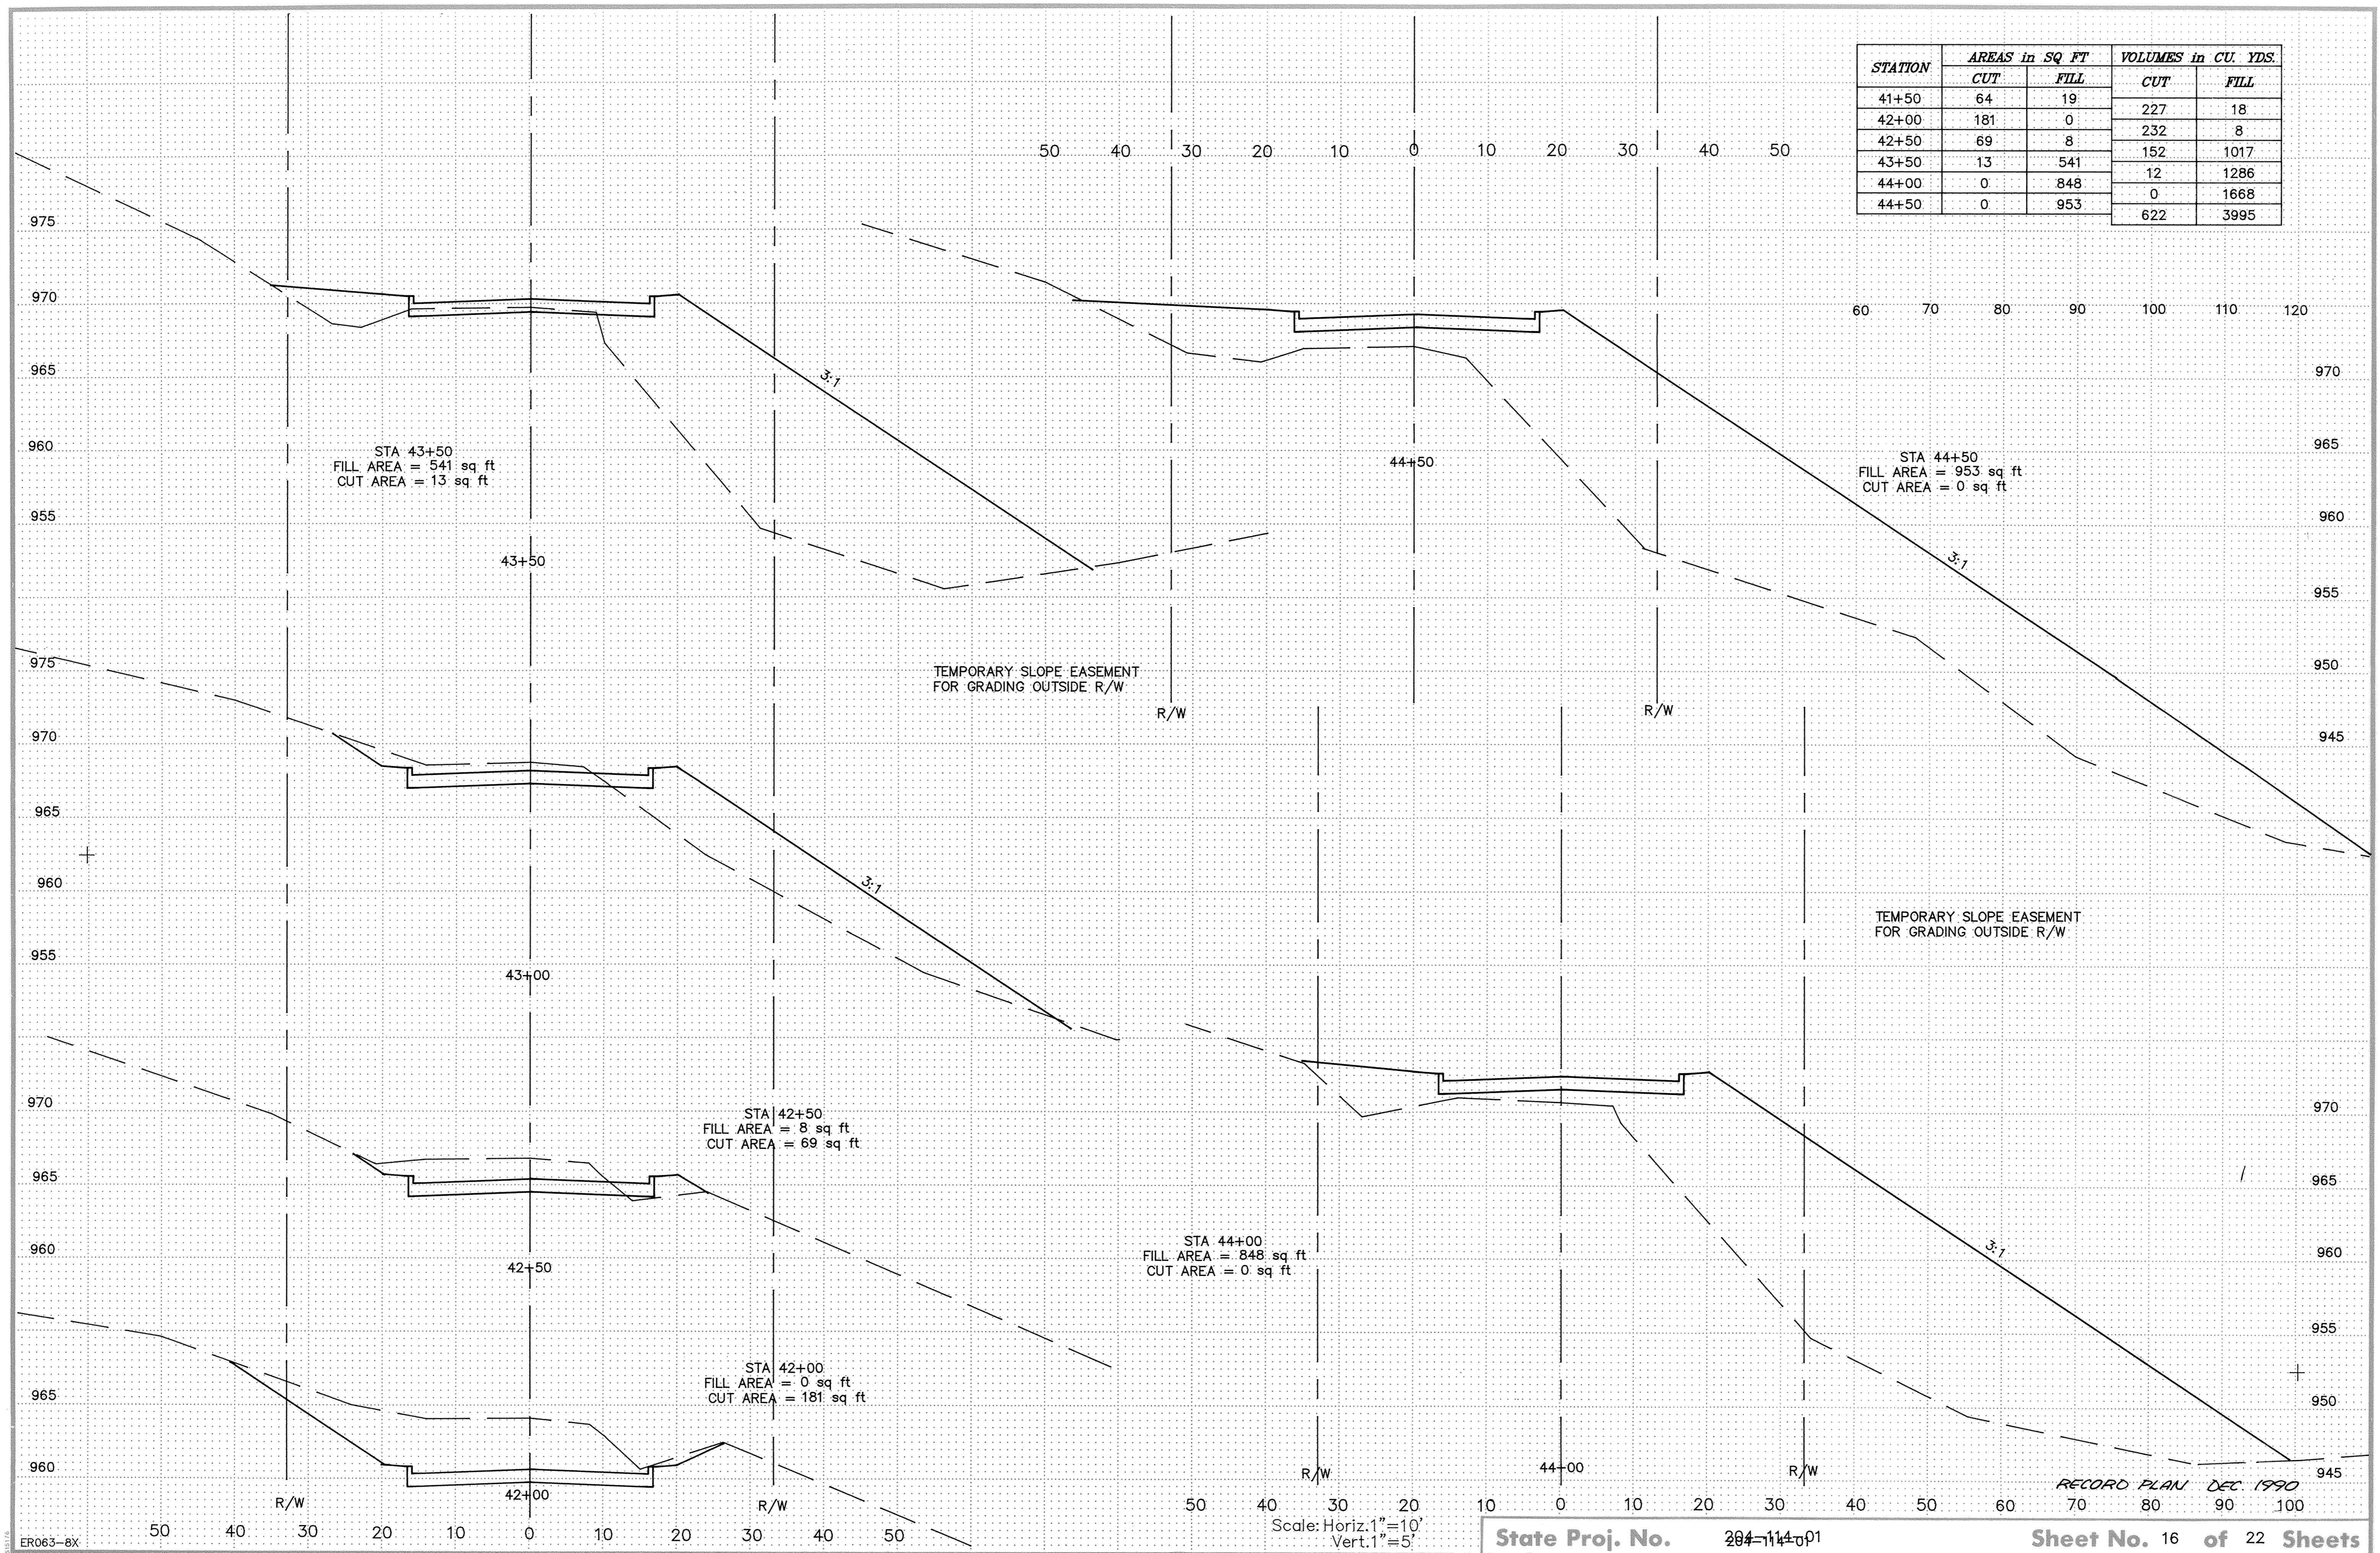

State Proj. No. 204-114-01

Sheet No. 16 of 22 Sheets